MATCH LINE – SEE SHEET C6.11

MATCH LINE – SEE SHEET C6.07

MATCH LINE – SEE SHEET C6.09

MATCH LINE – SEE SHEET C6.05

BUILDING 15

PARKING LOT 6

BUILDING 14

PARKING LOT 5

BUILDING 1
ADMINISTRATION

FOUNTAIN

FOUNTAIN

TO BUILDING "A" 2
(DISTRICT ADMIN. OFFICES)

CONNECT EXISTING STORM DRAIN

FILTER SYSTEM
18"x24" NDS LID
RIM 595.30
INV 592.30

FILTER SYSTEM
18"x24" NDS LID
RIM 595.30
INV 592.30

FILTER SYSTEM
18"x24" NDS LID
RIM 601.70
INV 598.10

FILTER SYSTEM
18"x24" NDS LID
RIM 601.50
INV 598.15

FILL VALVE BOX
12"x18" LID

FILL VALVE BOX
12"x18" LID

CONCRETE CHRISTY DRAIN BOX WITH LID
RIM 619.07
INV 618.07

TWO 1" SD LINES FROM SUMP PUMP TO CHRISTY DRAIN BOX

CONNECT TO EXISTING IRRIGATION LINE

CONNECT TO EXISTING IRRIGATION LINE

WATER MAIN LOWERING

WATER MAIN LOWERING

WATER MAIN LOWERING

CAUTION, EXISTING ELECTRICAL LINE CROSSINGS, ELEVATIONS TO BE VERIFIED IN FIELD
ELEC 617.70
EX TOP OF ELEC 617.0±

CONNECT NEW 2-1/2"

## RECORD DRAWINGS

THESE RECORD DOCUMENTS HAVE BEEN PREPARED BASED ON INFORMATION PROVIDED BY OTHERS. BKF ENGINEERS HAS NOT VERIFIED THE ACCURACY AND/OR COMPLETENESS OF THIS INFORMATION AND SHALL NOT BE RESPONSIBLE FOR ANY ERRORS OR OMISSIONS THAT MAY BE INCORPORATED HEREIN AS A RESULT. BKF ENGINEERS DOES NOT ASSUME ANY RESPONSIBILITY FOR THE FIELD MODIFICATIONS TO THE PLANS.

BY: BKF ENGINEERS DATE: JUNE 2011

GRAPHIC SCALE
20 0 20 40

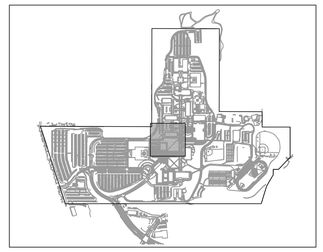

KEYMAP

## NOTES

1. SEE SHEETS C8.03 THROUGH C8.05 FOR UTILITY DETAILS.


McCarthy Building Companies, Inc.
343 Sansome Street, 14th Floor
San Francisco, California 94104
P 415 | 364-1339
F 415 | 397-5999

BKF ENGINEERS | SURVEYORS | PLANNERS
255 SHORELINE DRIVE, SUITE 200
REDWOOD CITY, CA 94065
PHONE: (650) 482-6300
FAX: (650) 482-6399


REGISTERED PROFESSIONAL ENGINEER
RICHARD N.Y. HAGA
No. C043971
CIVIL
STATE OF CALIFORNIA

IDENTIFICATION STAMP
DIV. OF THE STATE ARCHITECT
OFFICE OF REGULATION SERVICE
APPL #: 01-110097
AC_____ FLS_____ SS_____
DATE _____

FILE NUMBER:


This and all other project documents and all ideas, arrangements and designs indicated or represented thereby are instruments of service for use solely with respect to this project and McCarthy Building Companies, Inc. (MBC), KH Construction (KH) and LPA, Inc. (LPA) and are not to be used in whole or in part for any other project or purpose except as described in the contractual agreement between MBC/KH and the District. LPA hereby gives formal notice that any such project document use, reproduction or modification (misuse) is not only unlawful but automatically binds all parties involved with misuse to fully indemnify and defend LPA and LPA's Consultants to the maximum extent allowed under law. Project documents are not to be used for bidding purposes, permits, assurance or guarantees of any kind and are not to be released for misuse. Project documents describe design intent of work and are not a representation of as-built or existing conditions. LPA and LPA's Consultants make no representations concerning the accuracy of documents and are not responsible for any discrepancies between project documents and the existing conditions.

© Copyright 2008


College of San Mateo
Site Package
San Mateo, CA

Developed for
San Mateo County Community College District

| Revision Description | Date |
|---|---|
| DSA SUBMITTAL | 19 SEPT 2008 |
| DSA FINAL | 09 APRIL 2009 |
| RFI #21 | 14 JULY 2009 |
| RFI #23 | 16 JULY 2009 |
| RFI #27 | 17 JULY 2009 |
| RFI #30 rev 1 | 22 MAY 2010 |
| RFI #30 rev 2 | 18 MAY 2011 |
| PROJECT RECORD DRAWING | JUNE 2011 |

| | |
|---|---|
| Job. No. | 27082.30 |
| Date | 02 APRIL 2009 |
| Drawn by | MD, JT |
| Checked by | RH |
| Scale | 1"=20' |

UTILITY PLAN

C6.08