

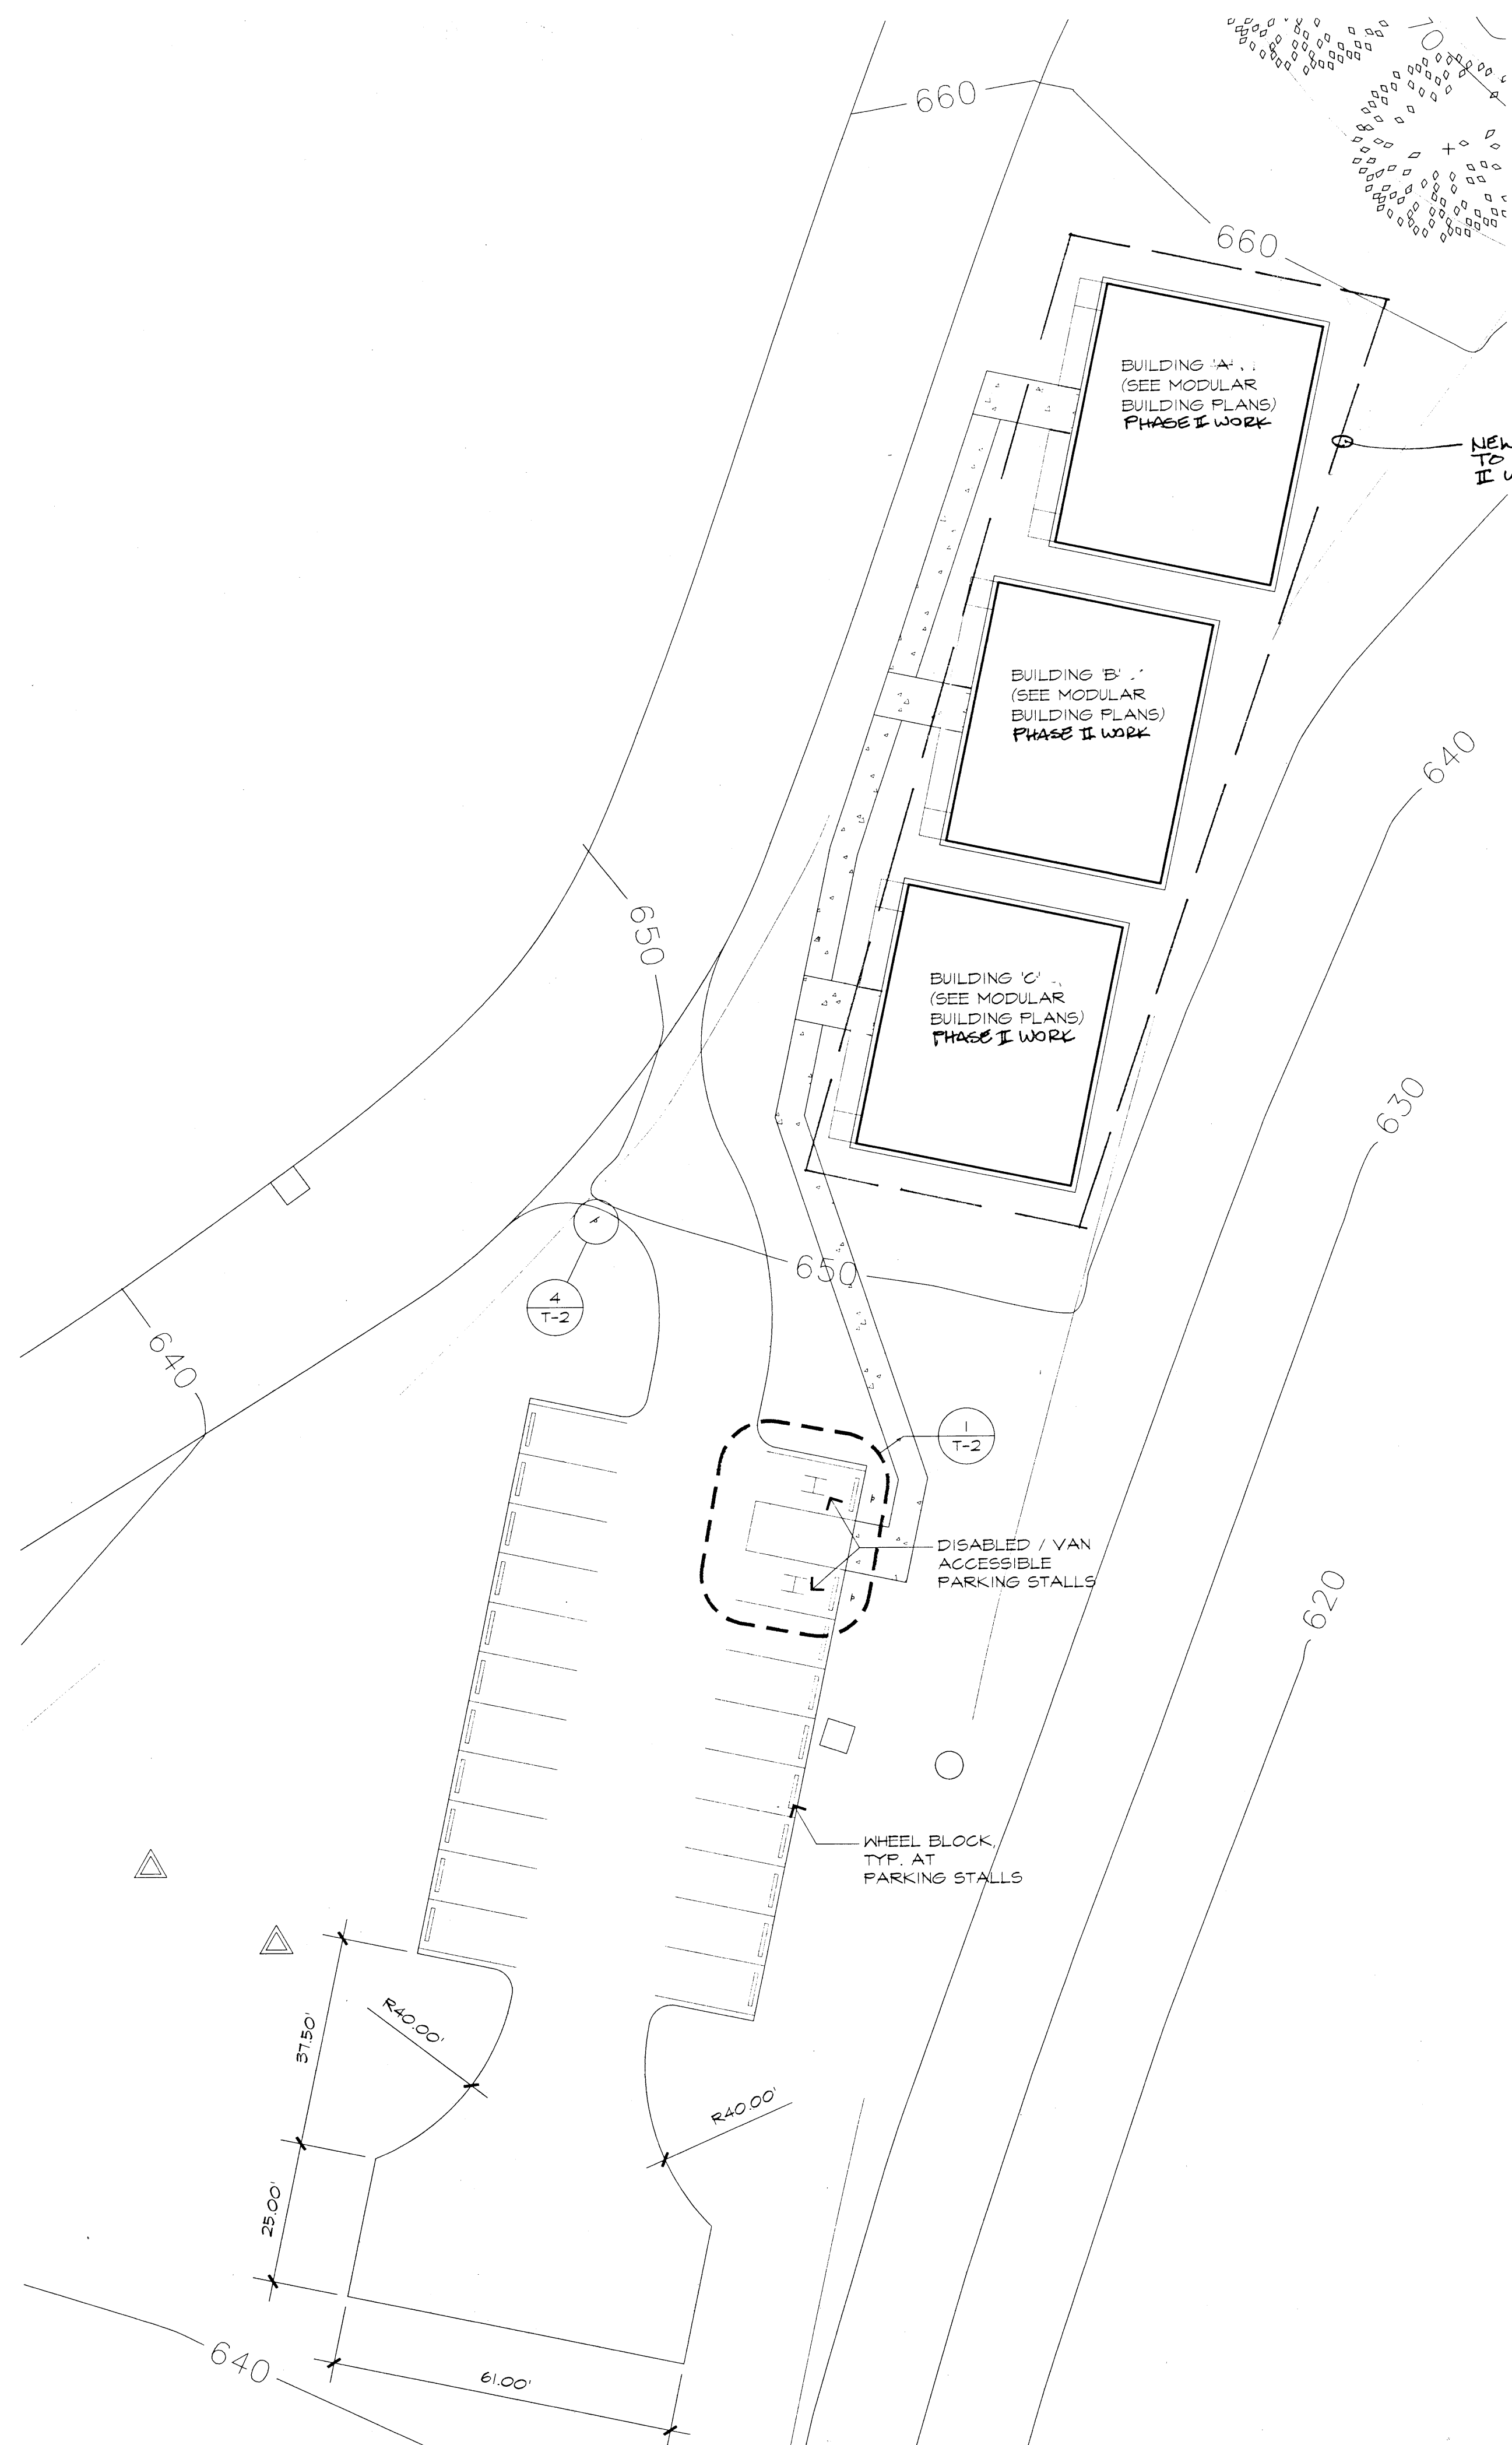


NAME: P:\2056\CAD\PLT\2056s1.dwg DATE: DEC 11, 2000 TIME: 11:25 AM

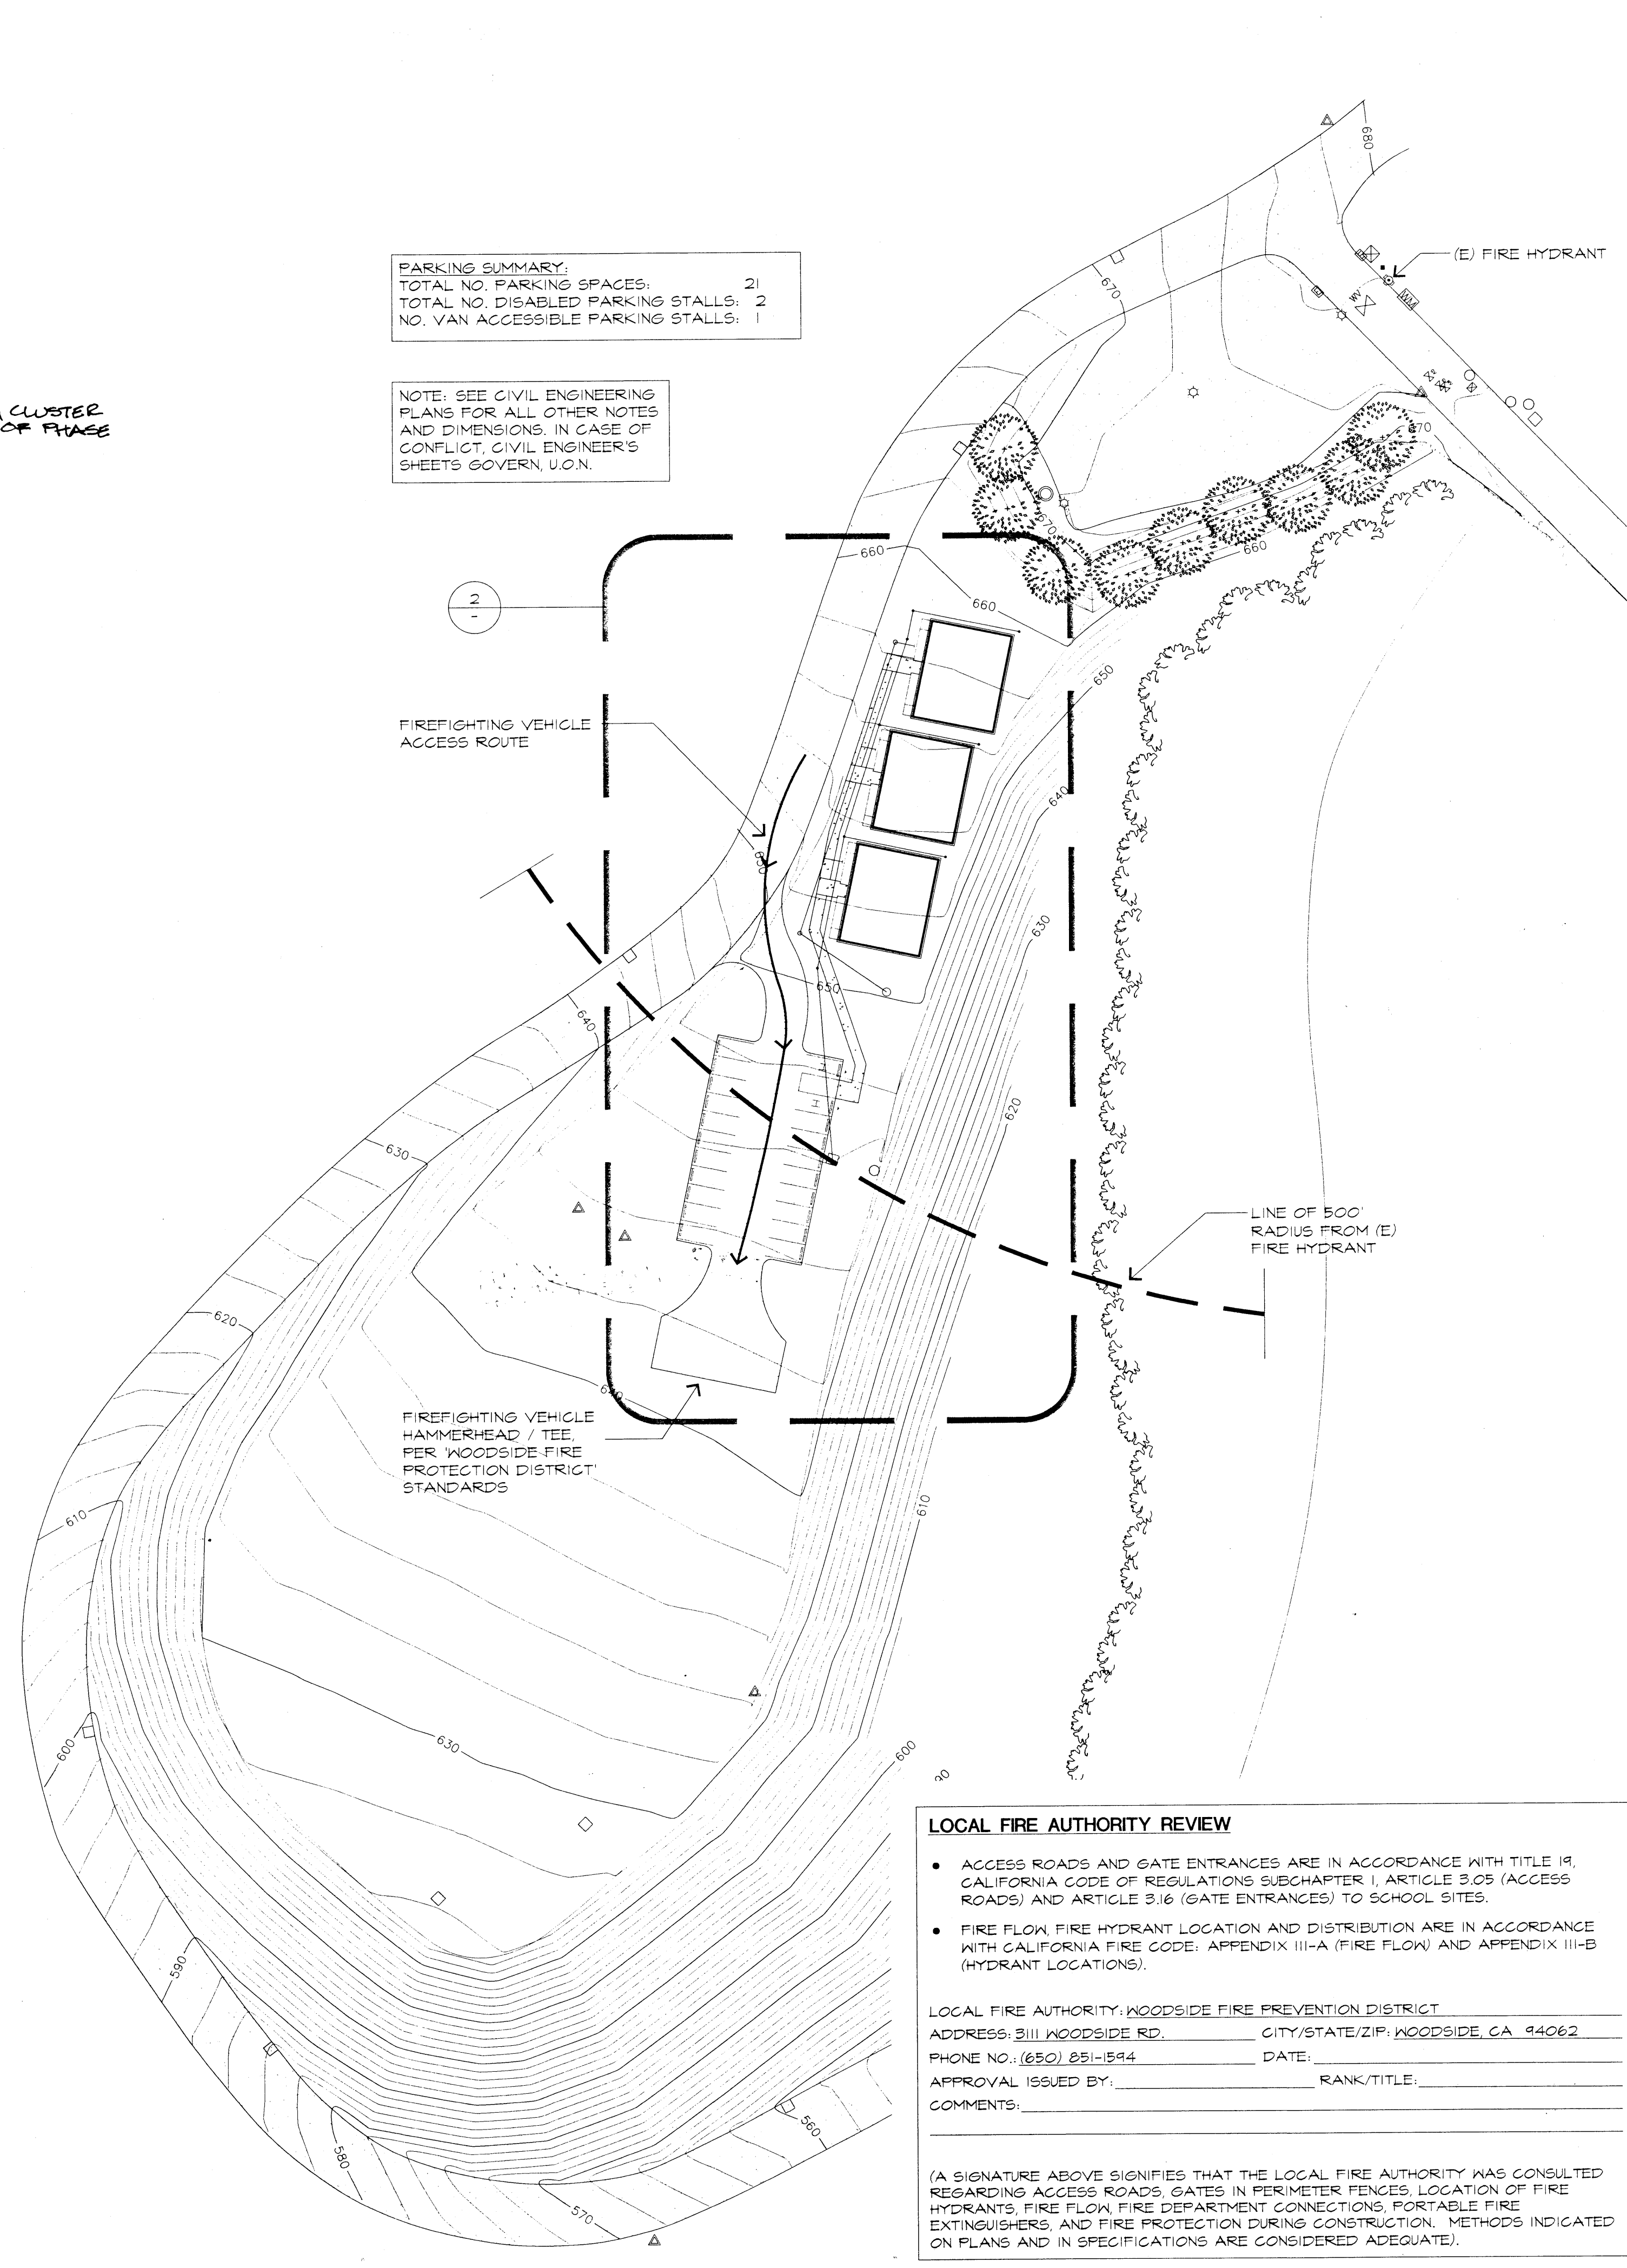

2 PARTIAL SITE PLAN

1"=20'-0" 0 5' 10' 20' 40' 60'

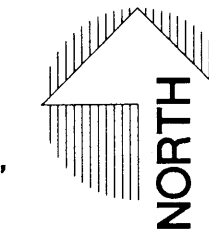

**PARKING SUMMARY:**  
 TOTAL NO. PARKING SPACES: 21  
 TOTAL NO. DISABLED PARKING STALLS: 2  
 NO. VAN ACCESSIBLE PARKING STALLS: 1

NOTE: SEE CIVIL ENGINEERING PLANS FOR ALL OTHER NOTES AND DIMENSIONS. IN CASE OF CONFLICT, CIVIL ENGINEER'S SHEETS GOVERN, U.O.N.

**LOCAL FIRE AUTHORITY REVIEW**


- ACCESS ROADS AND GATE ENTRANCES ARE IN ACCORDANCE WITH TITLE 19, CALIFORNIA CODE OF REGULATIONS SUBCHAPTER 1, ARTICLE 3.05 (ACCESS ROADS) AND ARTICLE 3.16 (GATE ENTRANCES) TO SCHOOL SITES.
- FIRE FLOW, FIRE HYDRANT LOCATION AND DISTRIBUTION ARE IN ACCORDANCE WITH CALIFORNIA FIRE CODE, APPENDIX III-A (FIRE FLOW) AND APPENDIX III-B (HYDRANT LOCATIONS).

LOCAL FIRE AUTHORITY: WOODSIDE FIRE PREVENTION DISTRICT  
 ADDRESS: 3111 WOODSIDE RD. CITY/STATE/ZIP: WOODSIDE CA 94062  
 APPROVAL ISSUED BY: \_\_\_\_\_ RANK/TITLE: \_\_\_\_\_  
 COMMENTS: \_\_\_\_\_


(A SIGNATURE ABOVE SIGNIFIES THAT THE LOCAL FIRE AUTHORITY WAS CONSULTED REGARDING ACCESS ROADS, GATES IN PERIMETER FENCES, LOCATION OF FIRE HYDRANTS, FIRE FLOW, FIRE DEPARTMENT CONNECTIONS, PORTABLE FIRE EXTINGUISHERS, AND FIRE PROTECTION DURING CONSTRUCTION. METHODS INDICATED ON PLANS AND IN SPECIFICATIONS ARE CONSIDERED ADEQUATE).

1 OVERALL SITE PLAN

1"=50'-0" 0 10' 20' 50' 100' 150'

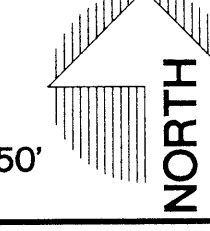

**Sugimura & Associates Architects**  
 Architecture • Planning • Interiors  
 Landscape • Irrigation  
 2155 South Bascom Ave., Suite 200  
 Campbell, CA 95008  
 408-879-0600 Fx 408-377-6066  
 COPYRIGHT © 2000 Sugimura & Associates/Architects

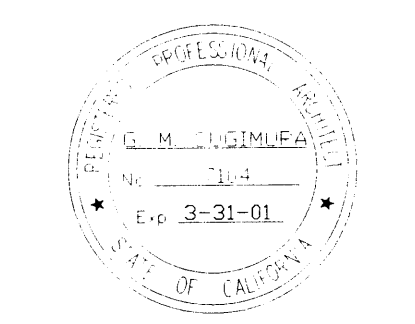

G.M. Sugimura

**SITE PLANS**  
 WEST ED MODULAR BUILDINGS  
 CANADA COLLEGE  
 4200 FARM HILL BOULEVARD  
 REDWOOD CITY, CALIFORNIA

NO.	ITEM	DATE

CLIENT APPROVAL:  
 DRAWN BY: **DBP**  
 CHECKED BY: **GMS**  
 JOB NO: 2056 DATE: 12/20/00