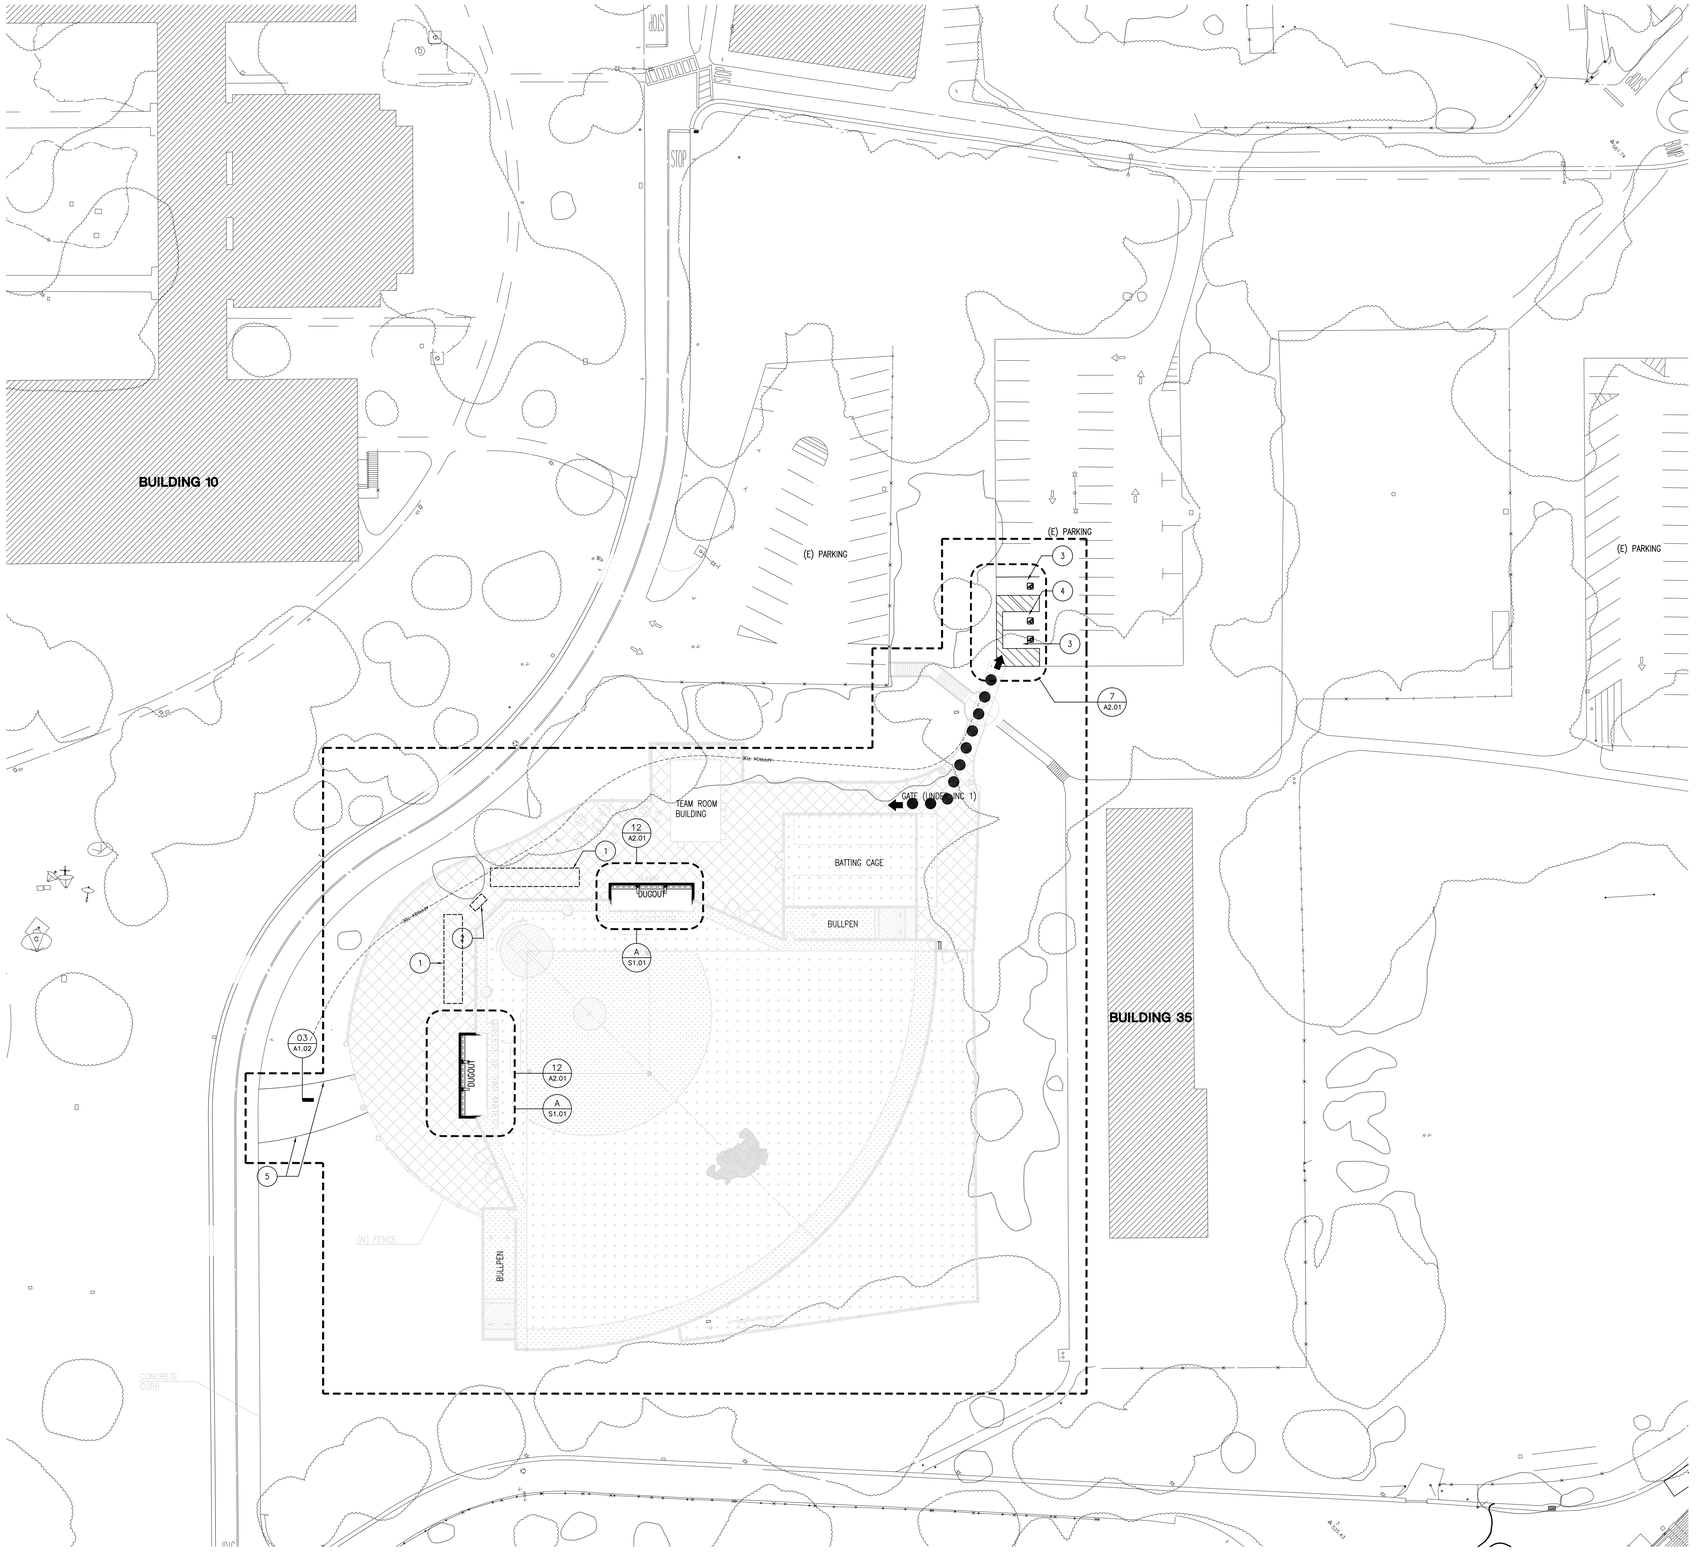

1 SITE PLAN
1"=30'-0"

PLAN KEY NOTES

1. LINE OF FUTURE BLEACHERS
2. FUTURE SCORER'S TABLE
3. ACCESSIBLE PARKING STALL
4. VAN ACCESSIBLE PARKING STALL
5. TEMPORARY ASPHALT PAVING

SYMBOLS/ LEGENDS

AREAS OF WORK

ACCESSIBLE PATH OF TRAVEL

DES ARCHITECTS ENGINEERS
399 Bradford Street Redwood City, Ca. 94063
Tel: (650) 364-6453
Fax: (650) 364-2618
www.des-ae.com

CMX Sports Engineers
7740 NORTH 16TH STREET
SUITE 100
PHOENIX, AZ. 85020
Ph: (602) 567-1900
Fax: (602) 567-1901

ROBERT A. BOTHMAN, INC.
General Engineering and Building Contractors
650 QUINN AVENUE
SAN JOSE, CA. 95112
Ph: (408) 279-2277
Fax: (408) 279-2281

SAN MATEO COUNTY COMMUNITY COLLEGE DISTRICT ATHLETIC FIELDS PHASE 2

INCREMENT 1.A
COLLEGE OF SAN MATEO SOFTBALL FIELD
1700 W. Hillsdale Blvd.
San Mateo, Ca. 94402

PROJECT SITE PLAN

ISSUE:	DATE:	DESCRIPTION:
	11-14-06	CD REVISIONS

DRAWN BY: A. MARQUEZ
REVIEWED BY: V. AMRHEIN
APPROVED BY: V. AMRHEIN
DES PROJECT NO.: 9126.12

INDENTIFICATION STAMP
DIVISION OF THE STATE ARCHITECT
APPL. #:
FILE #: 41-C1
AC_____ FLS_____ SS_____
DATE:_____

LICENSED ARCHITECT VINCENT AMRHEIN C-28933 12/3/07 RENEWAL DATE STATE OF CALIFORNIA

© 2006

SHEET NO.
- A1.01

Jun 30, 2008 - 9:57am ddaksh P:\SMCCCD\AtHP2\912612\Dwg\Incr 1, 2 and 6 CSM_Softball\Incr 1\Incr 1A\A1.01 SITE PLAN.dwg