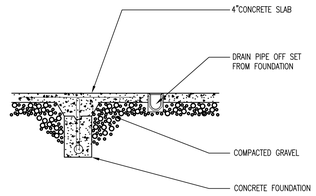

13 DRAIN PIPE DETAIL
1/2"=1'-0"
FILE NAME: DRAWN BY: A. BAKSH

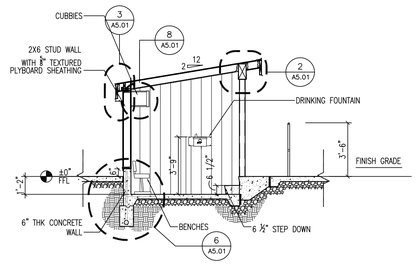

9 DUGOUT SECTION 01
1/4" = 1'-0"

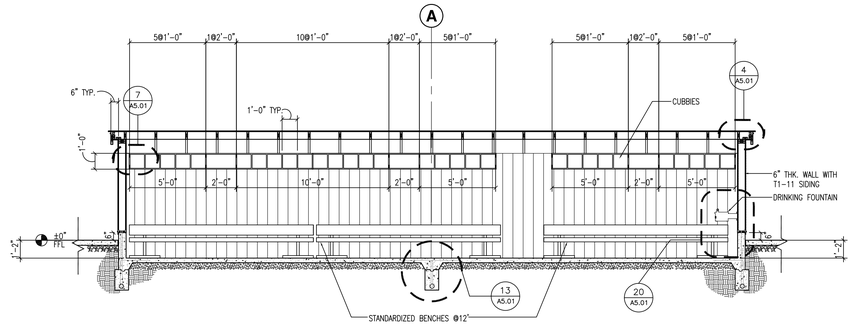

5 DUGOUT SECTION 02
1/4"=1'-0"

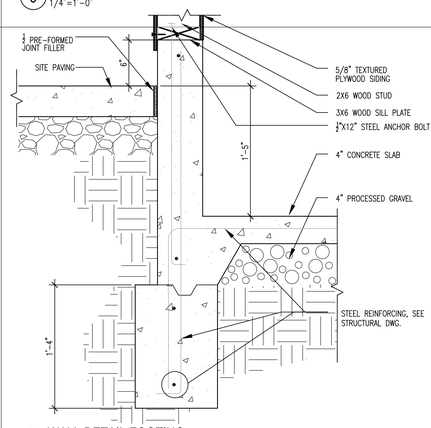

6 WALL DETAIL FOOTING
1 1/2"=1'-0"
FILE NAME: DRAWN BY:

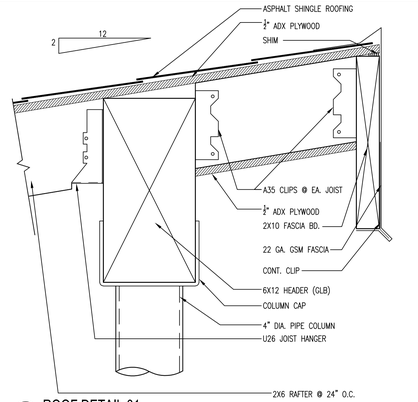

2 ROOF DETAIL 01
3"=1'-0"
FILE NAME: DRAWN BY:

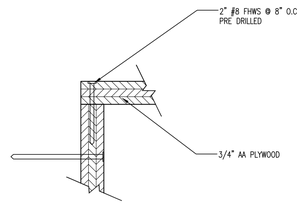

11 CUBBY JOINT DETAIL 02
6"=1'-0"
FILE NAME: DRAWN BY:

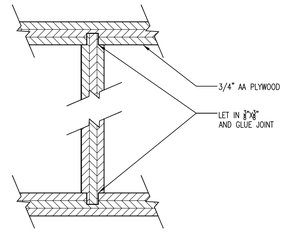

7 CUBBY JOINT DETAIL 01
6"=1'-0"
FILE NAME: DRAWN BY:

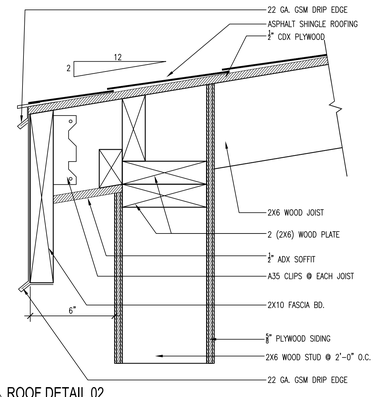

3 ROOF DETAIL 02
3"=1'-0"
FILE NAME: DRAWN BY:

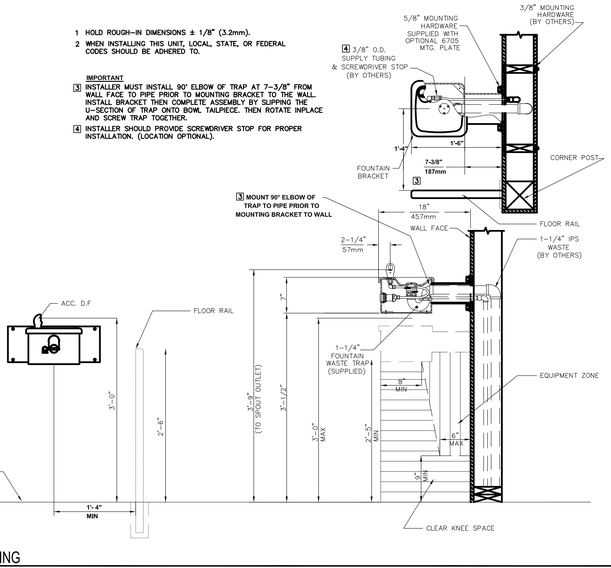

20 DUGOUT DRINKING FOUNTING
1"=1'-0"
FILE NAME: DRAWN BY:

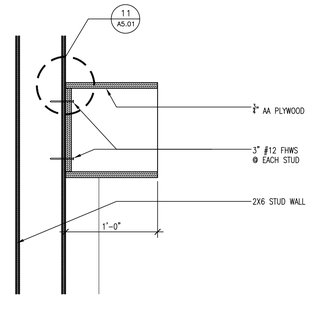

8 CUBBY DETAIL 02
1 1/2"=1'-0"
FILE NAME: DRAWN BY:

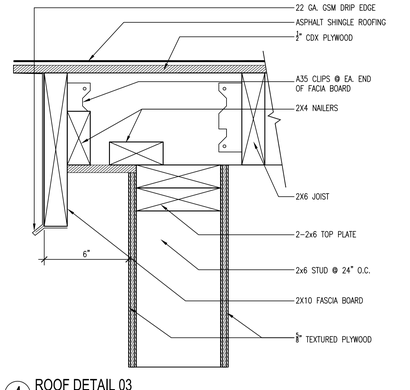

4 ROOF DETAIL 03
3"=1'-0"
FILE NAME: DRAWN BY:

DES
ARCHITECTS
ENGINEERS
399 Bradford Street Redwood City, Ca. 94063
Tel: (650) 364-6453
Fax: (650) 364-2618
www.des-ae.com

CMX Sports Engineers
7740 NORTH 16TH STREET
SUITE 100
PHOENIX, AZ. 85020
Ph: (602) 567-1900
Fax: (602) 567-1901

ROBERT A. BOTHMAN, INC.
General Engineering and Building Contractors
650 QUINN AVENUE
SAN JOSE, CA. 95112
Ph: (408) 279-2277
Fax: (408) 279-2281

SAN MATEO COUNTY COMMUNITY COLLEGE DISTRICT ATHLETIC FIELDS PHASE 2

INCREMENT 1.A
COLLEGE OF SAN MATEO
SOFTBALL FIELD

1700 W. Hillsdale Blvd.
San Mateo, Ca. 94402

SECTION DETAILS

ISSUE:	DATE:	DESCRIPTION:
	01-22-07	REVIEW

DRAWN BY: A. MARQUEZ / A.BAKSH
REVIEWED BY: V. AMRHEIN
APPROVED BY: V. AMRHEIN
DES PROJECT NO.: 9126.12

INDENTIFICATION STAMP
DIVISION OF THE STATE ARCHITECT
APPL. #:
FILE #: 41-C1
AC_____ FLS_____ SS_____
DATE:_____

LICENSED ARCHITECT VINCENT AMRHEIN C-28933 12/31/07 RENEWAL DATE STATE OF CALIFORNIA

© 2006

SHEET NO.
- A5.01

Jun 30, 2008 - 10:34am dbaksh P:\SMCCCD\AMHF2\9126\2\Dwg\Incr 1, 2 and 6 CSM Softball\Incr 1\Incr 1A\A5.01 SECTION & DETAILS.dwg