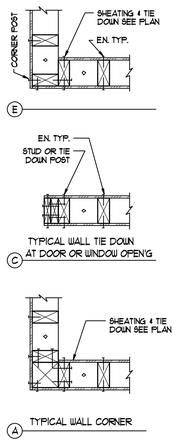

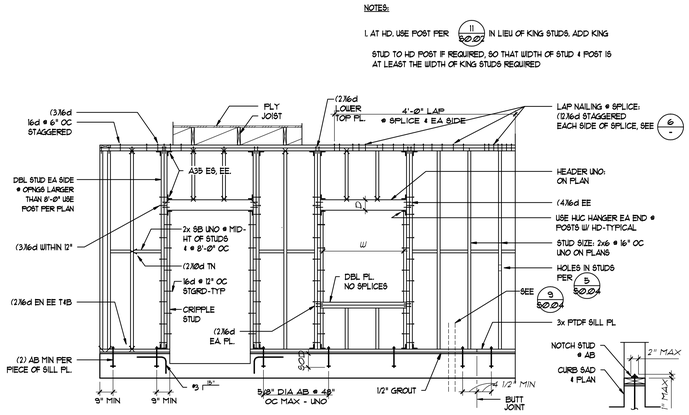

11 SHEAR WALL CONFIGURATIONS

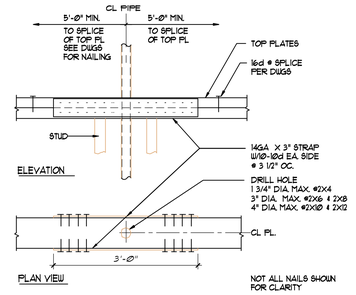

12 PLUMBING PENETRATION @ WALL

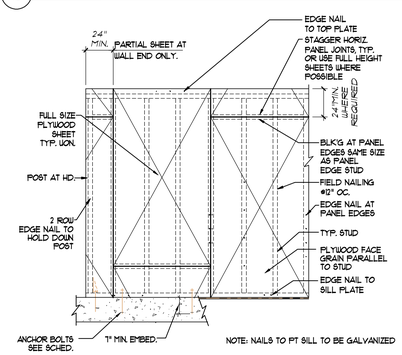

15 SHEAR WALL FRAMING ELEV.

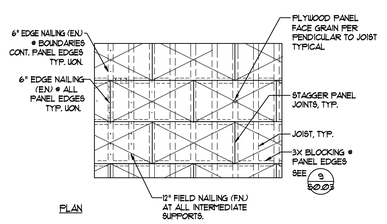

NOTES:
1. USE 10d COMMON NAILS @ FLOORS; 16d COMMON NAILS @ ROOFS
2. GLUE PLYWOOD TO FLOOR FRAMING MEMBERS PRIOR TO NAILING
3. MINIMUM PLYWOOD WIDTH IS 24"
4. SEE PLAN FOR PLYWOOD THICKNESS & GRADE

6 PLYWOOD SHEATING @ ROOF

2 TYPICAL EXTERIOR STUDWALL FRAMING ELEVATION

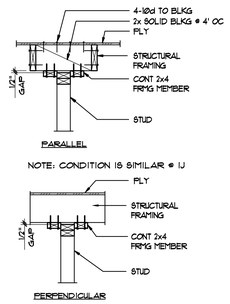

7 TYPICAL NON-BEARING STUD WALL DETAILS

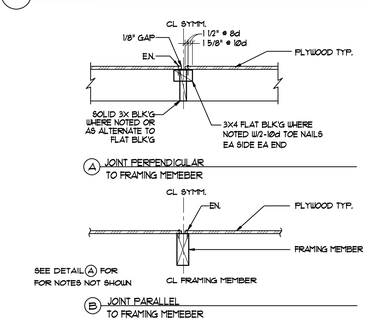

9 PLYWOOD NAILING

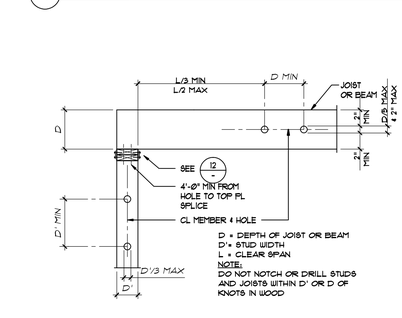

5 HOLES & NOTCHES IN WOOD STUDS, JOISTS, BEAMS & PLATES

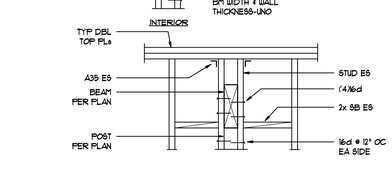

4 TYPICAL BEAM IN & THRU STUD WALL

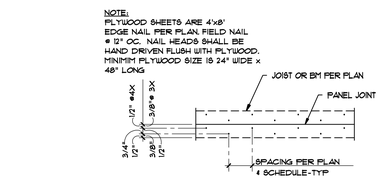

9A PLAN VIEW OF CLOSE SPACED NAILS

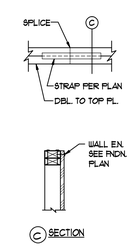

6 TOP PLATE SPLICE

DES ARCHITECTS ENGINEERS
399 Bradford Street Redwood City, Ca. 94063
Tel: (650) 364-6453
Fax: (650) 364-2618
www.des-ae.com

CMX Sports Engineers
7740 NORTH 16TH STREET
SUITE 100
PHOENIX, AZ. 85020
Ph: (602) 567-1900
Fax: (602) 567-1901

ROBERT A. BOTHMAN, INC.
General Engineering and Building Contractors
650 QUINN AVENUE
SAN JOSE, CA. 95112
Ph: (408) 279-2277
Fax: (408) 279-2281

SAN MATEO COUNTY COMMUNITY COLLEGE DISTRICT ATHLETIC FIELDS PHASE 2 INCREMENT 1A

COLLEGE OF SAN MATEO SOFTBALL FIELD
1700 W. Hillsdale Blvd.
San Mateo, Ca. 94402

S0.03

ISSUE:	DATE:	DESCRIPTION:
	10/23/06	DSA
	01/22/07	REVISED
	03/07/07	REVISED

DRAWN BY: SL
REVIEWED BY: TS.
APPROVED BY: TS.
DES PROJECT NO.: 0000.000

TSA STRUCTURAL ENGINEERS
433 Airport Blvd, Ste 106E
Burlingame, Ca 94010
Tel. (650) 620-9555
Fax (650) 620-9559
E-mail: tsa@tsase.com

C-28933 12/31/07 RENEWAL
REGISTERED PROFESSIONAL ENGINEER ANTOINE SAMRA No. 38514 Ex. 3-31-07 STRUCTURAL STATE OF CALIFORNIA

SHEET NO.
- S0.03