

KRUGER BENSEN ZIEMER
ARCHITECTS, INC. AIA
30 W. ARRELLAGA SANTA BARBARA, CA.
805/963-1726 93101

STEVE DOWTY, A.I.A.
PRINCIPAL IN CHARGE


GERALD SHUSTA
PROJECT ARCHITECT



DALAN ENGINEERING, INC.
ELECTRICAL ENGINEERS
DALAN JOB No AA181
8638 DARBY AVENUE (714) 771-4221
NORTHIDGE, CA. 91325 (805) 684-4944
(818) 772-2220 FAX (818) 772-2239

NOTES:

- 1 SEE DETAIL — (A-E)10
- 2 SEE DETAIL — (B-E)10
- 3 SPLICE CIRCUIT #1 IN PANEL "CL1B" SO THAT IT CAN BE CARRIED IN BOTH HOMERUNS "CL1B-1,3" AND "CL1B-1,5"
- 4 3 # 14 LOW VOLTAGE WIRE IN 1/2" CONDUIT.
- 5 CONNECT NEW LIGHTS TO EXISTING BATHROOM LIGHTING CIRCUIT CL1A-9
- 6 CONNECT NEW LIGHTS TO EXISTING LIGHTING CIRCUIT CL1A-9

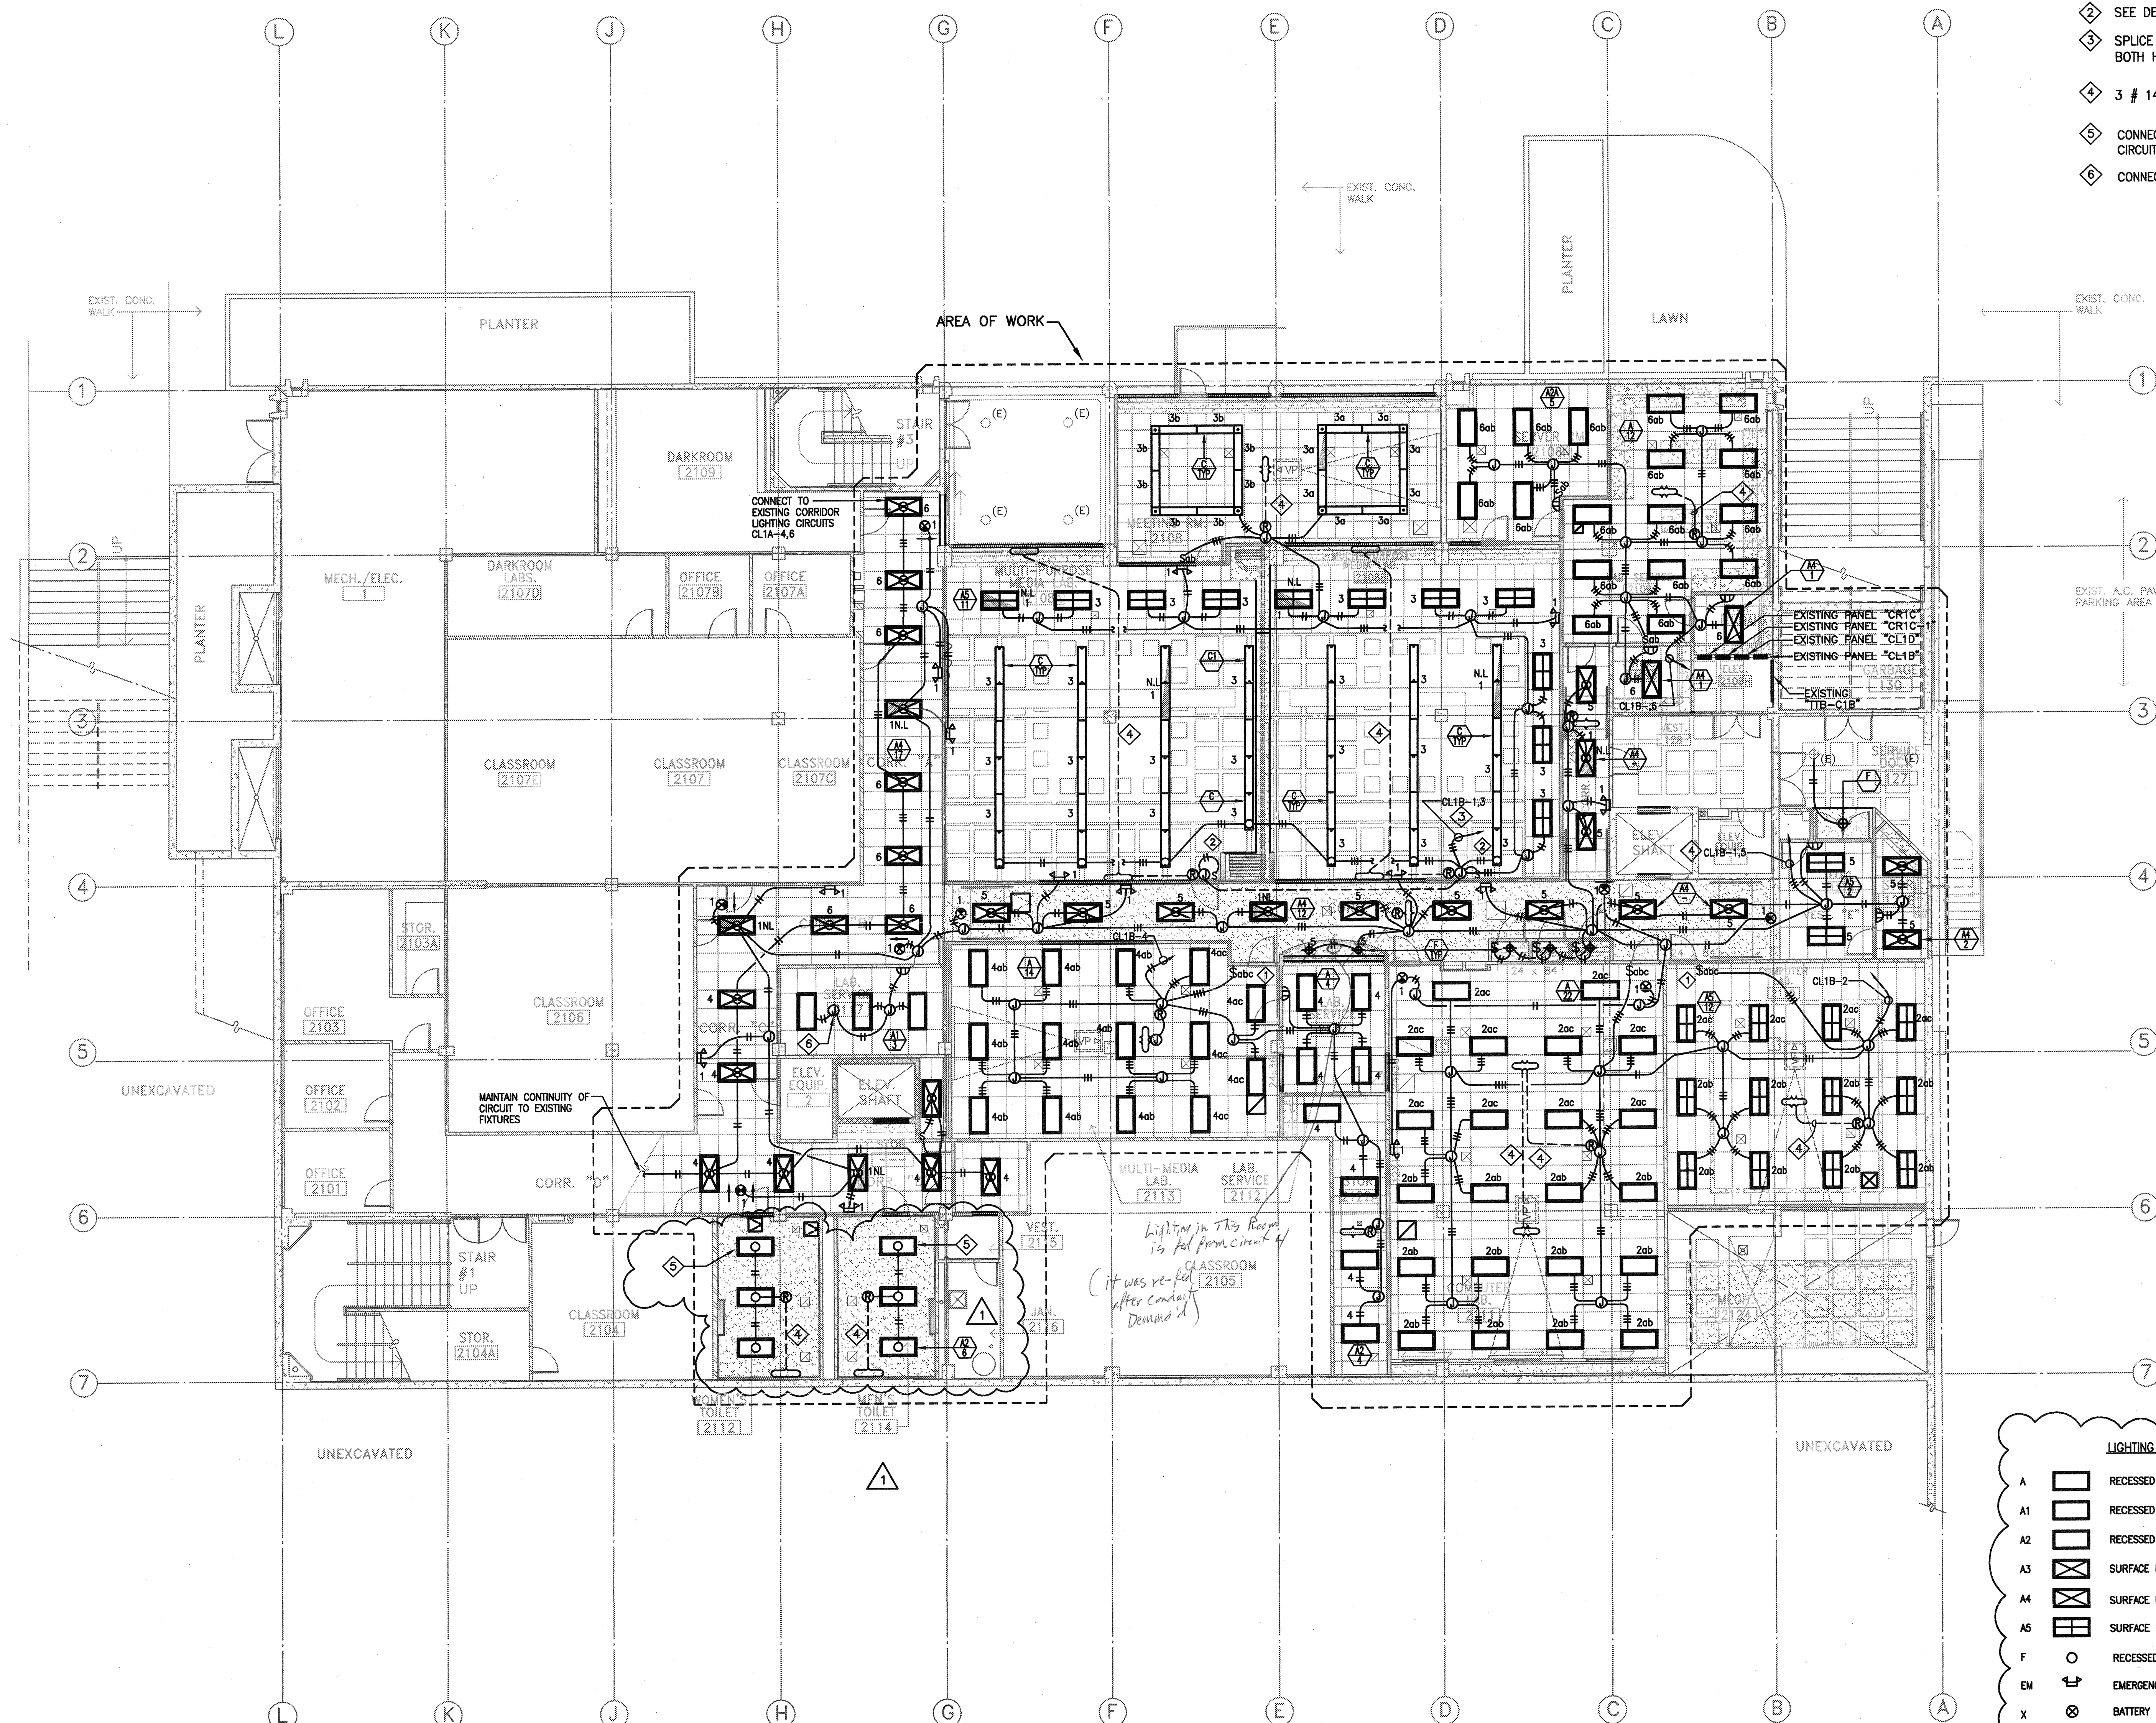




LIGHTING FIXTURE LEGEND:

- A RECESSED MOUNTED PARABOLIC 3 LAMP FLUORESCENT FIXTURE
- A1 RECESSED MOUNTED PARABOLIC 2 LAMP FLUORESCENT FIXTURE
- A2 RECESSED MOUNTED PRISMATIC 2 LAMP FLUORESCENT FIXTURE
- A3 SURFACE MOUNTED PRISMATIC 3 LAMP FLUORESCENT FIXTURE
- A4 SURFACE MOUNTED PRISMATIC 2 LAMP FLUORESCENT FIXTURE
- A5 SURFACE MOUNTED PARABOLIC 3 LAMP FLUORESCENT FIXTURE
- F RECESSED COMPACT FLUORESCENT DOWNLIGHT.
- EM EMERGENCY BATTERY BACK FIXTURE.
- X BATTERY BACKED LED EXIT SIGN.

R E M O D E L

1st LEVEL FLOOR PLAN BUILDING # 2

SCALE: 1/8" = 1'-0"

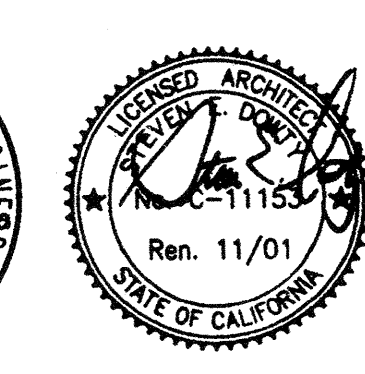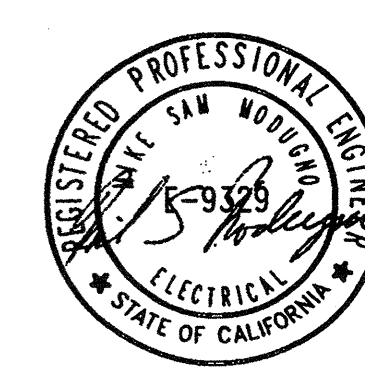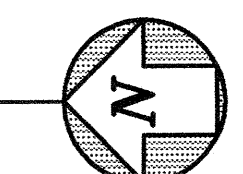

IDENTIFICATION STAMP
DIV. OF THE STATE ARCHITECT
OFFICE OF REGULATION SERVICES
APPL. 01-103 735
DATE: 03/21/01

△	BID SET REVISIONS	10/25/01
□	DSA SUBMITTAL	06/15/01
NO.	DESCRIPTION	DATE BY
REVISION		

DRAWN	LOG
CHECKED	DK
DATE	03/21/01
JOB NO.	98-03
SHEET TITLE	
1ST FLOOR PARTIAL LIGHTING FLOOR PLAN	
SHEET	
E 2.2	
OF	

CENTER FOR ADVANCED LEARNING TECHNOLOGY
SKYLINE COLLEGE
 SAN MATEO COUNTY COMMUNITY COLLEGE DISTRICT
 3300 COLLEGE DRIVE
 SAN BRUNO, CALIFORNIA 94066