


EQUIPMENT SCHEDULE						
ELECTRICAL						
ITEM #	VOLTAGE	SUPPLY FAN	RETURN AIR	DISCONNECT	CIRCUIT No./WIRE SIZE	REMARKS
1	480V-3Ø	COMPRESSOR (4) 17.2A.	FAN (4) 1.8	100AS 100AF 3P,W.P.	AC-8,10,12 1 1/2" C-3#1 & 1#8GRD. THWN. CU.	CONTROL PANEL PROVIDED WITH "CH-2"
2	120V.	1 H. P.		MOTOR RATED 20A. SWITCH WEATHERPROOF	PC-38 3/4" C-3#12 THWN CU.	


PLAN NOTE:

- CONNECT AIR HANDLING UNIT. ELECTRICAL CONTRACTOR TO SUPPLY & INSTALL 100 A/S. 100S/F CONTRACTOR SHALL CREDIT PROJECT COST TO PROVIDE AND INSTALL SWITCH IF SWITCH IS NOT REQUIRED.

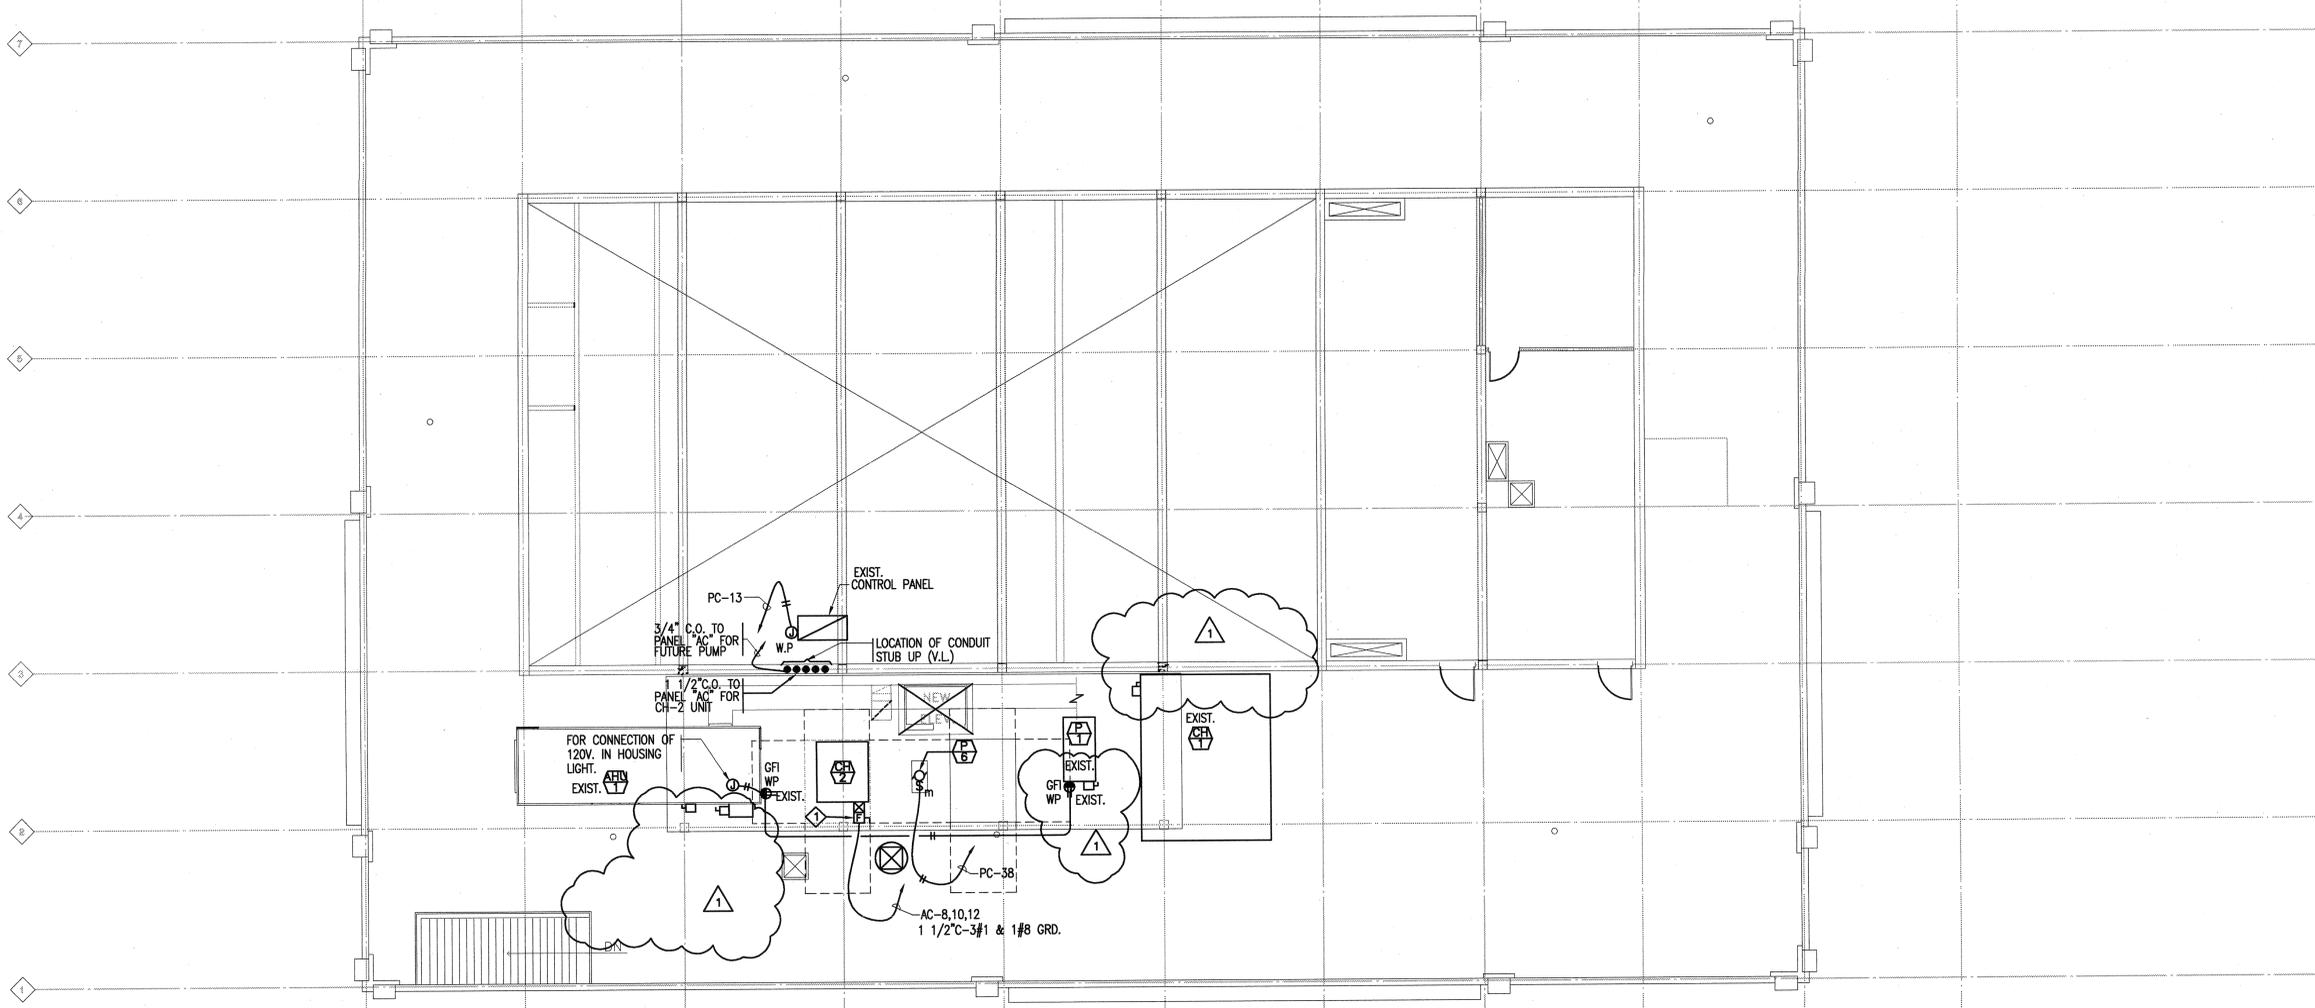

R O O F P L A N

SCALE: 1/8" = 1'-0"

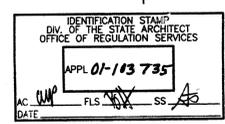

KRBZ
 KRUGER BENSEN ZIEMER ARCHITECTS, INC. AIA
 30 W. ARPELLAGA RD./SANTA BARBARA, CA 93101
 STEVE DOWTY, A.I.A. PRINCIPAL IN CHARGE
 GERALD SHUSTA PROJECT ARCHITECT
DALAN ENGINEERING, INC.
 ELECTRICAL ENGINEERS DALAN JOB No AA181
 8638 DARBY AVENUE (714) 771-4221
 NORTHBRIDGE, CA. 91325 (805) 684-4944
 (818) 772-2220 FAX (818) 772-2239

CENTER FOR ADVANCED LEARNING TECHNOLOGY
SKYLINE COLLEGE
 SAN MATEO COUNTY COMMUNITY COLLEGE DISTRICT
 SAN BRUNO, CALIFORNIA 94066
 3300 COLLEGE DRIVE

NO.	DESCRIPTION	DATE	BY
1	BID SET REVISIONS	10/25/01	
2	DSA SUBMITTAL	06/15/01	

DRAWN	FG
CHECKED	DK
DATE	03/21/01
JOB NO.	98-03
SHEET TITLE	
ROOF POWER PLAN	
SHEET	
E-2.5	
OF	