

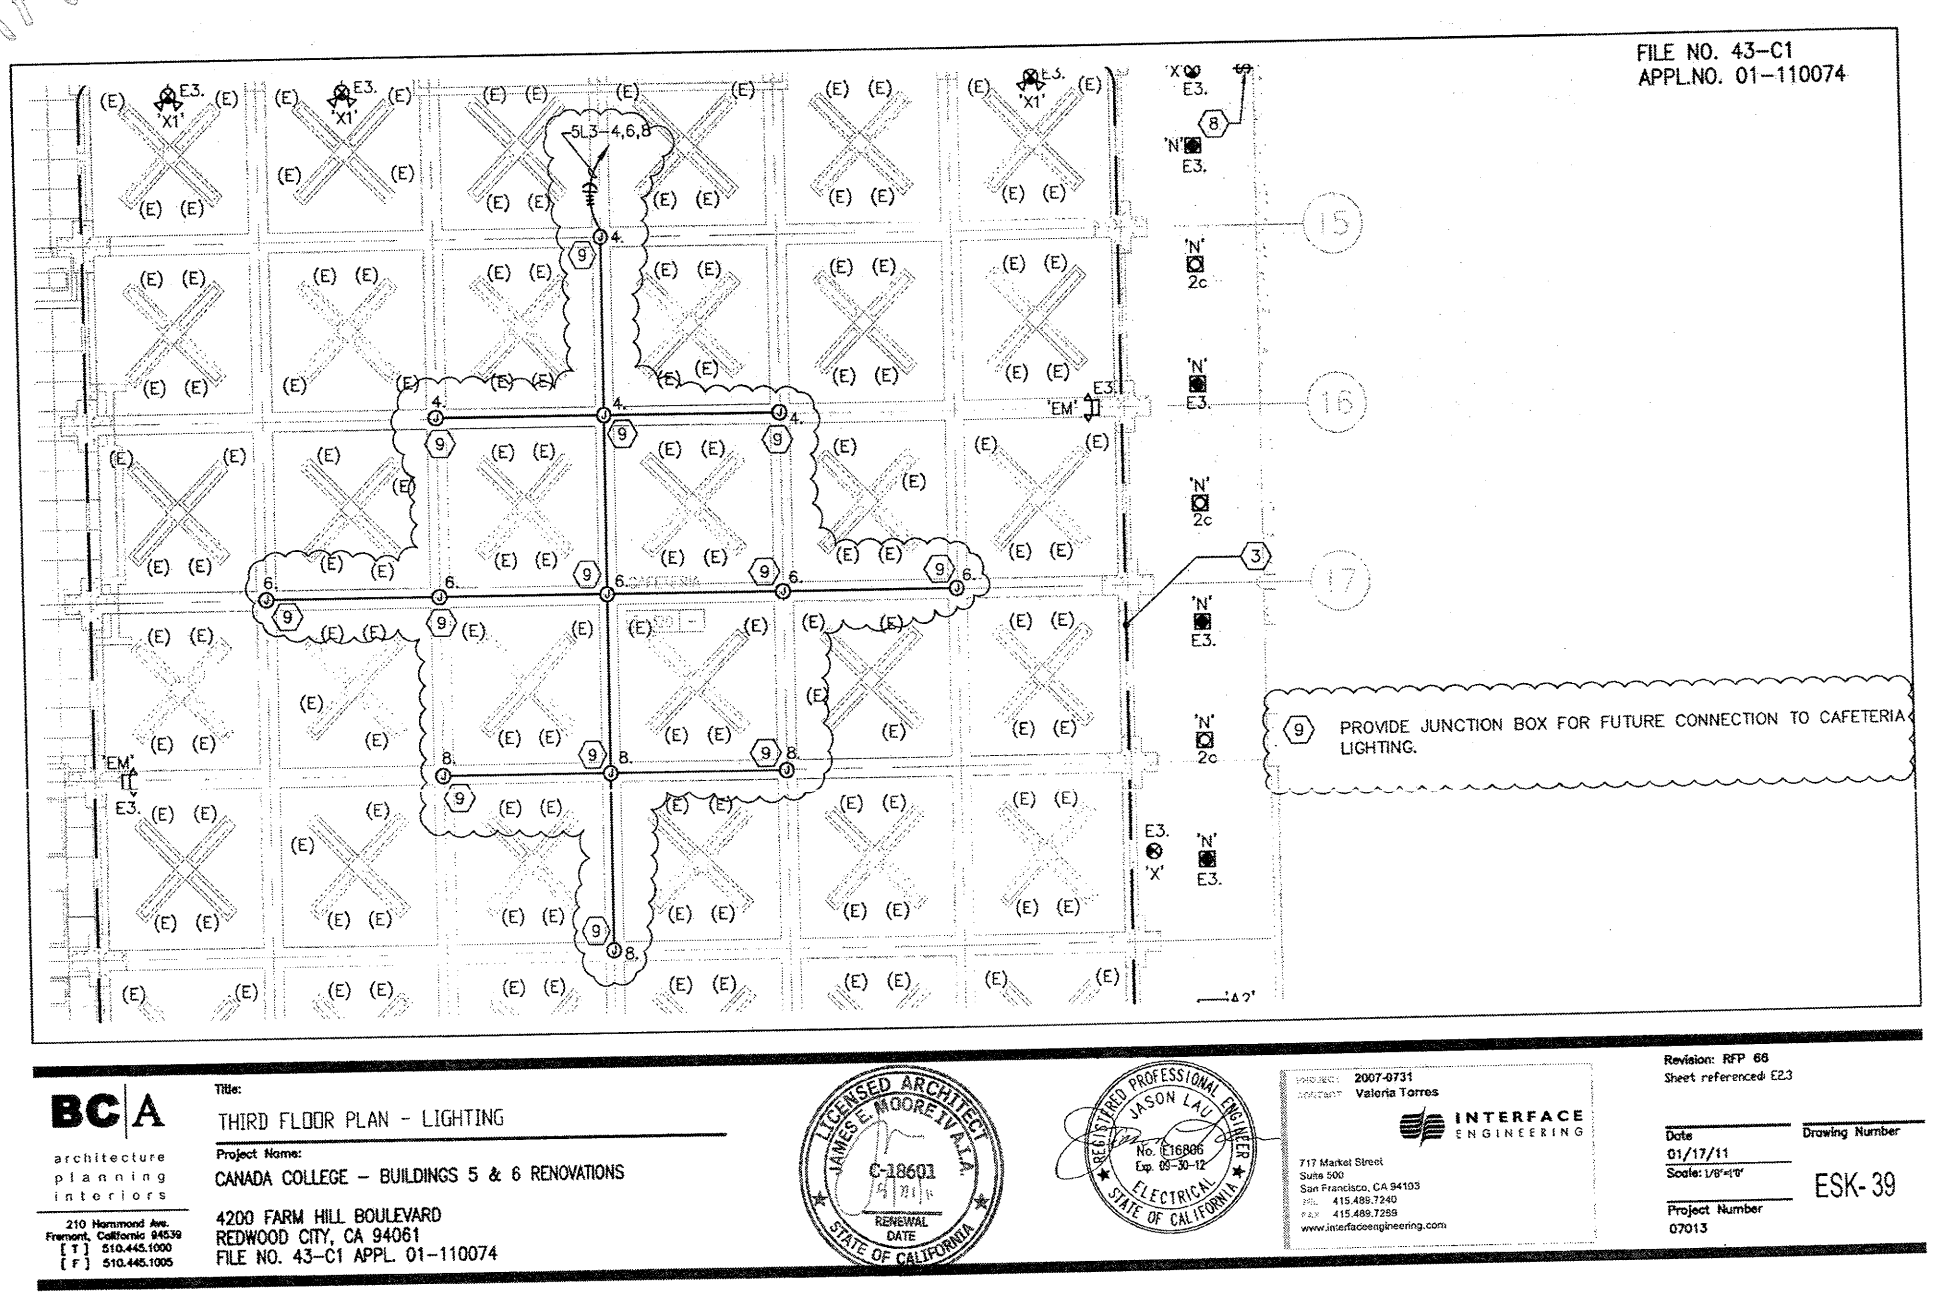



RFP-66

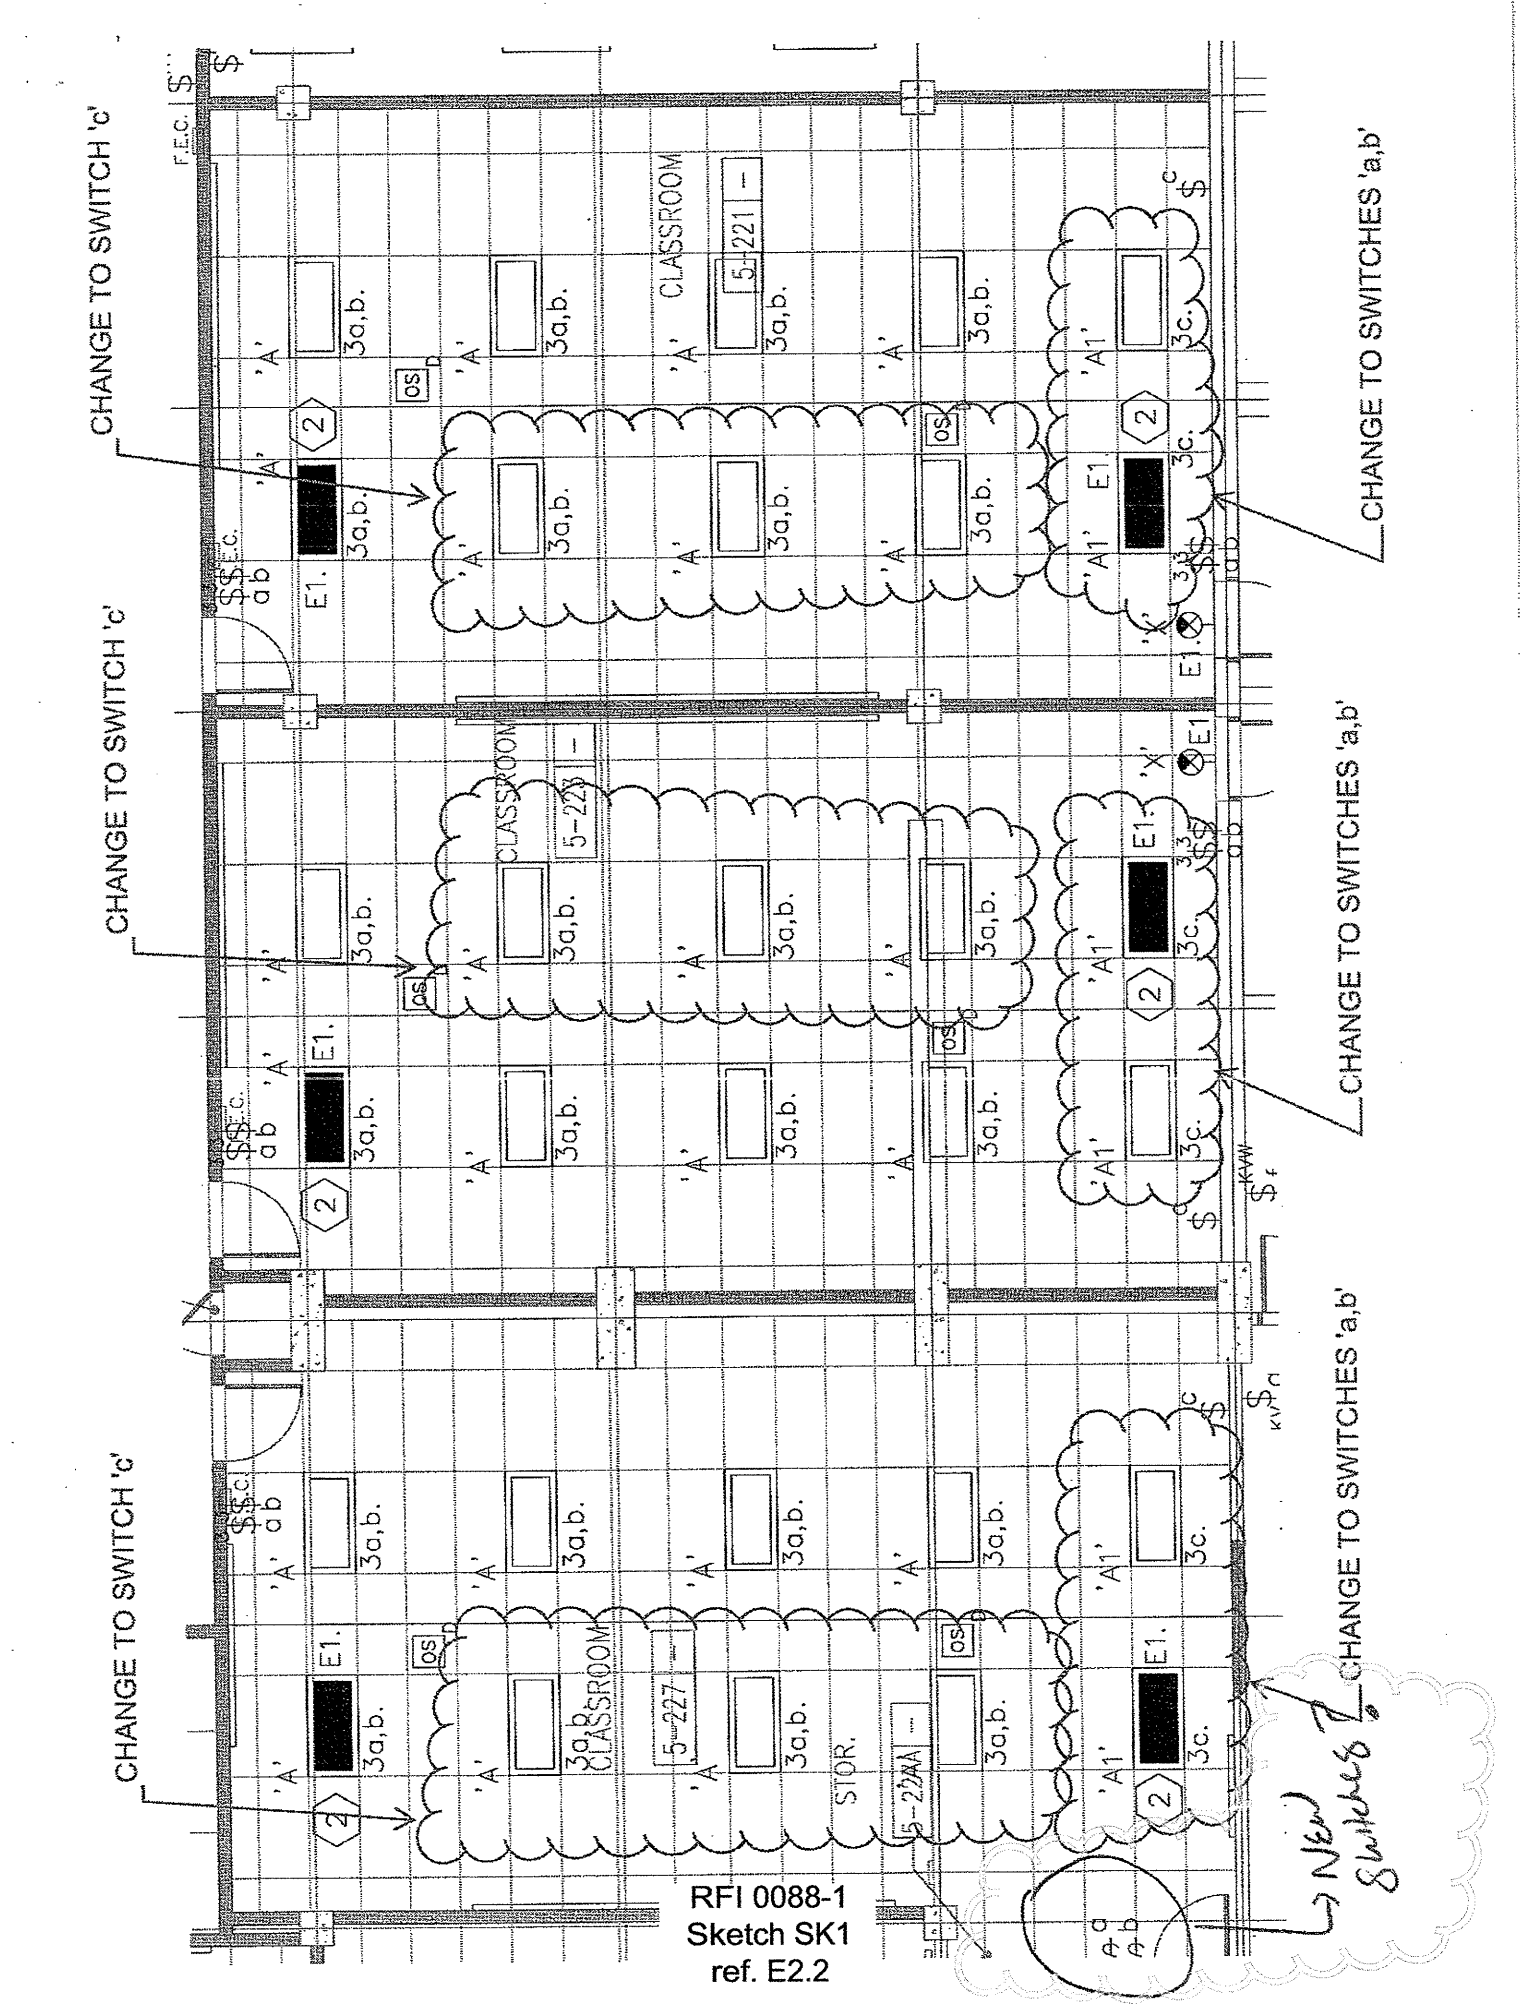


RFP 20

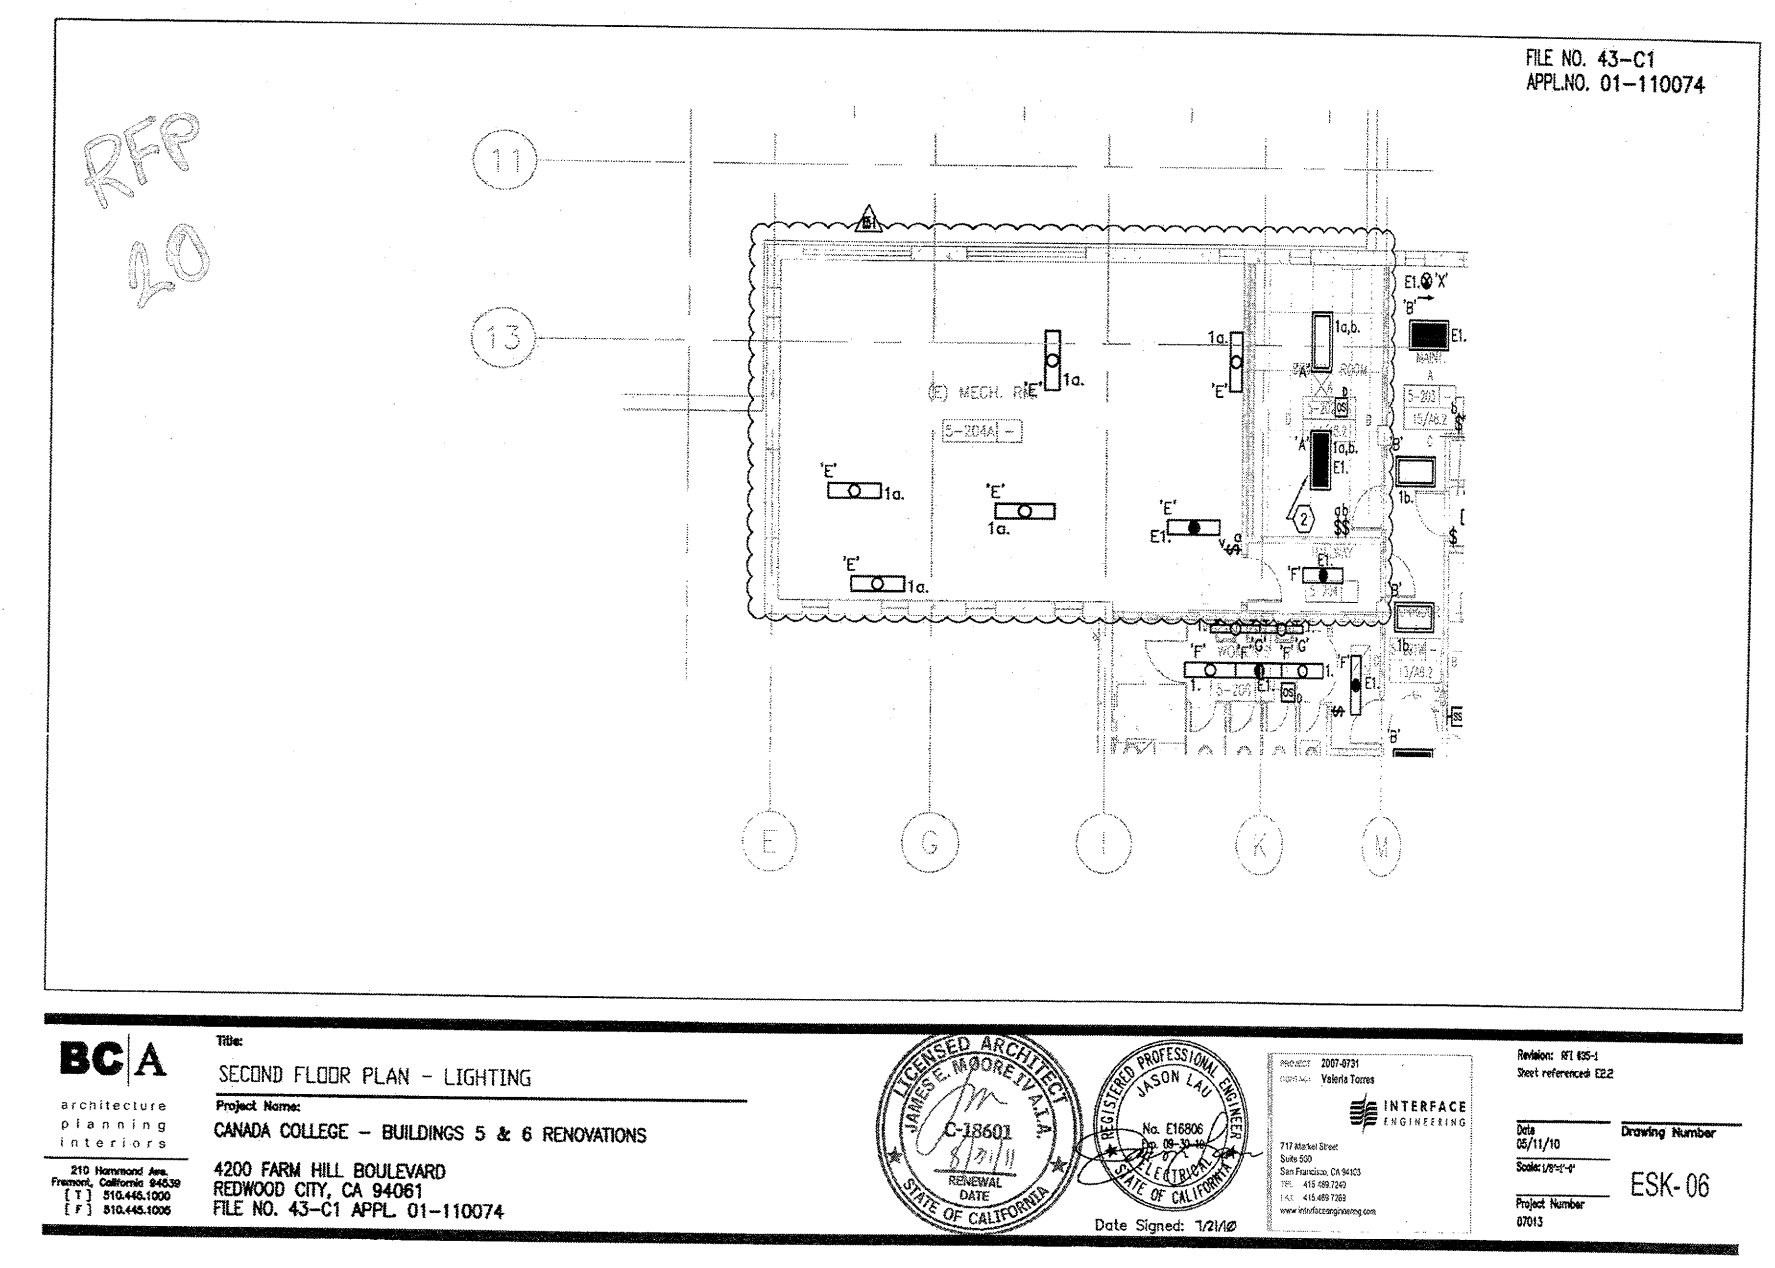


RFP-66

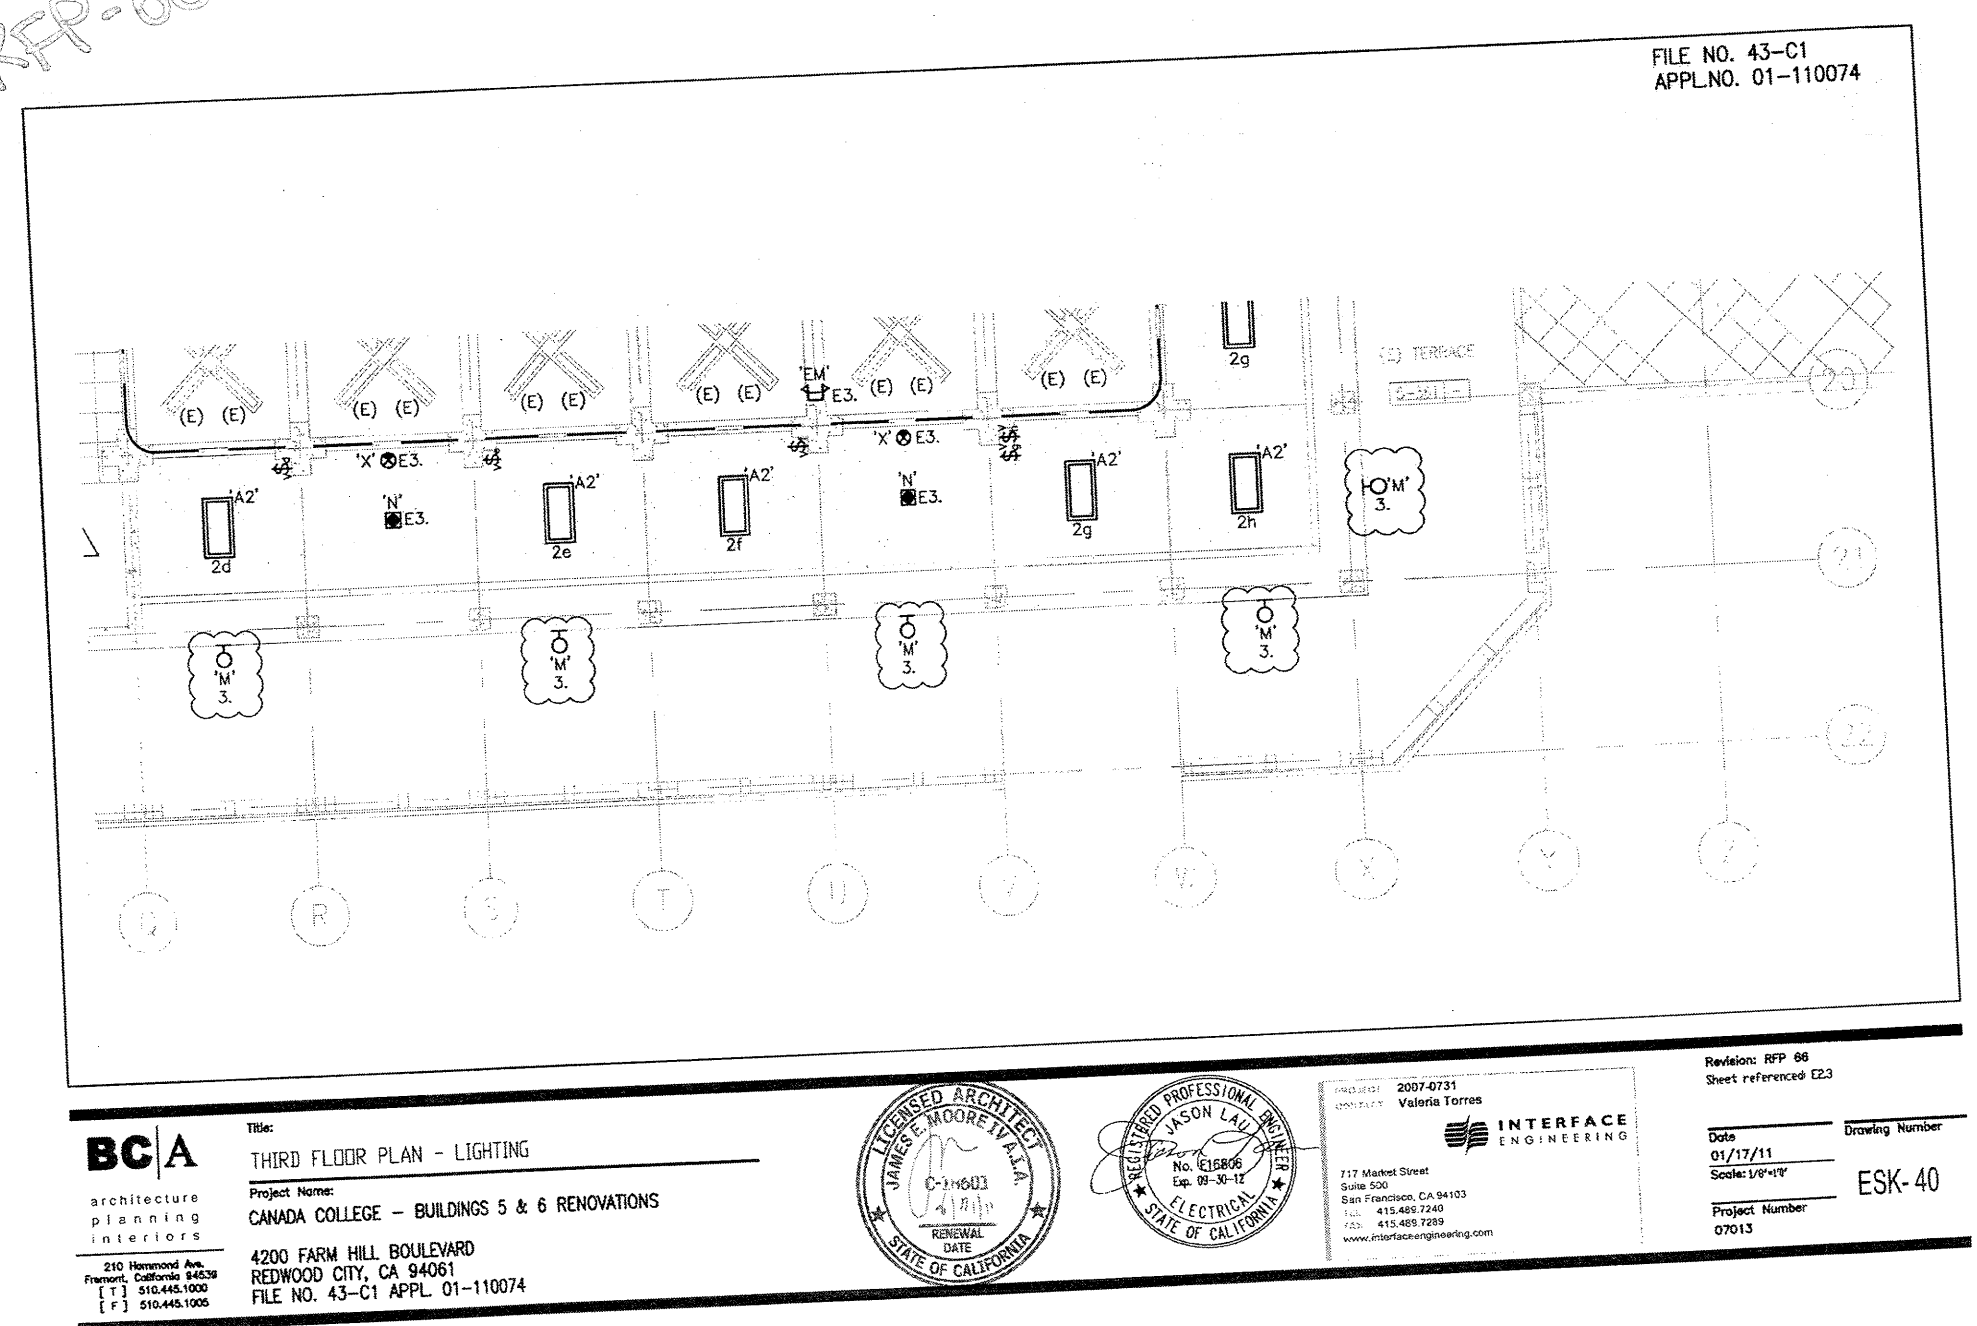

RFP 26

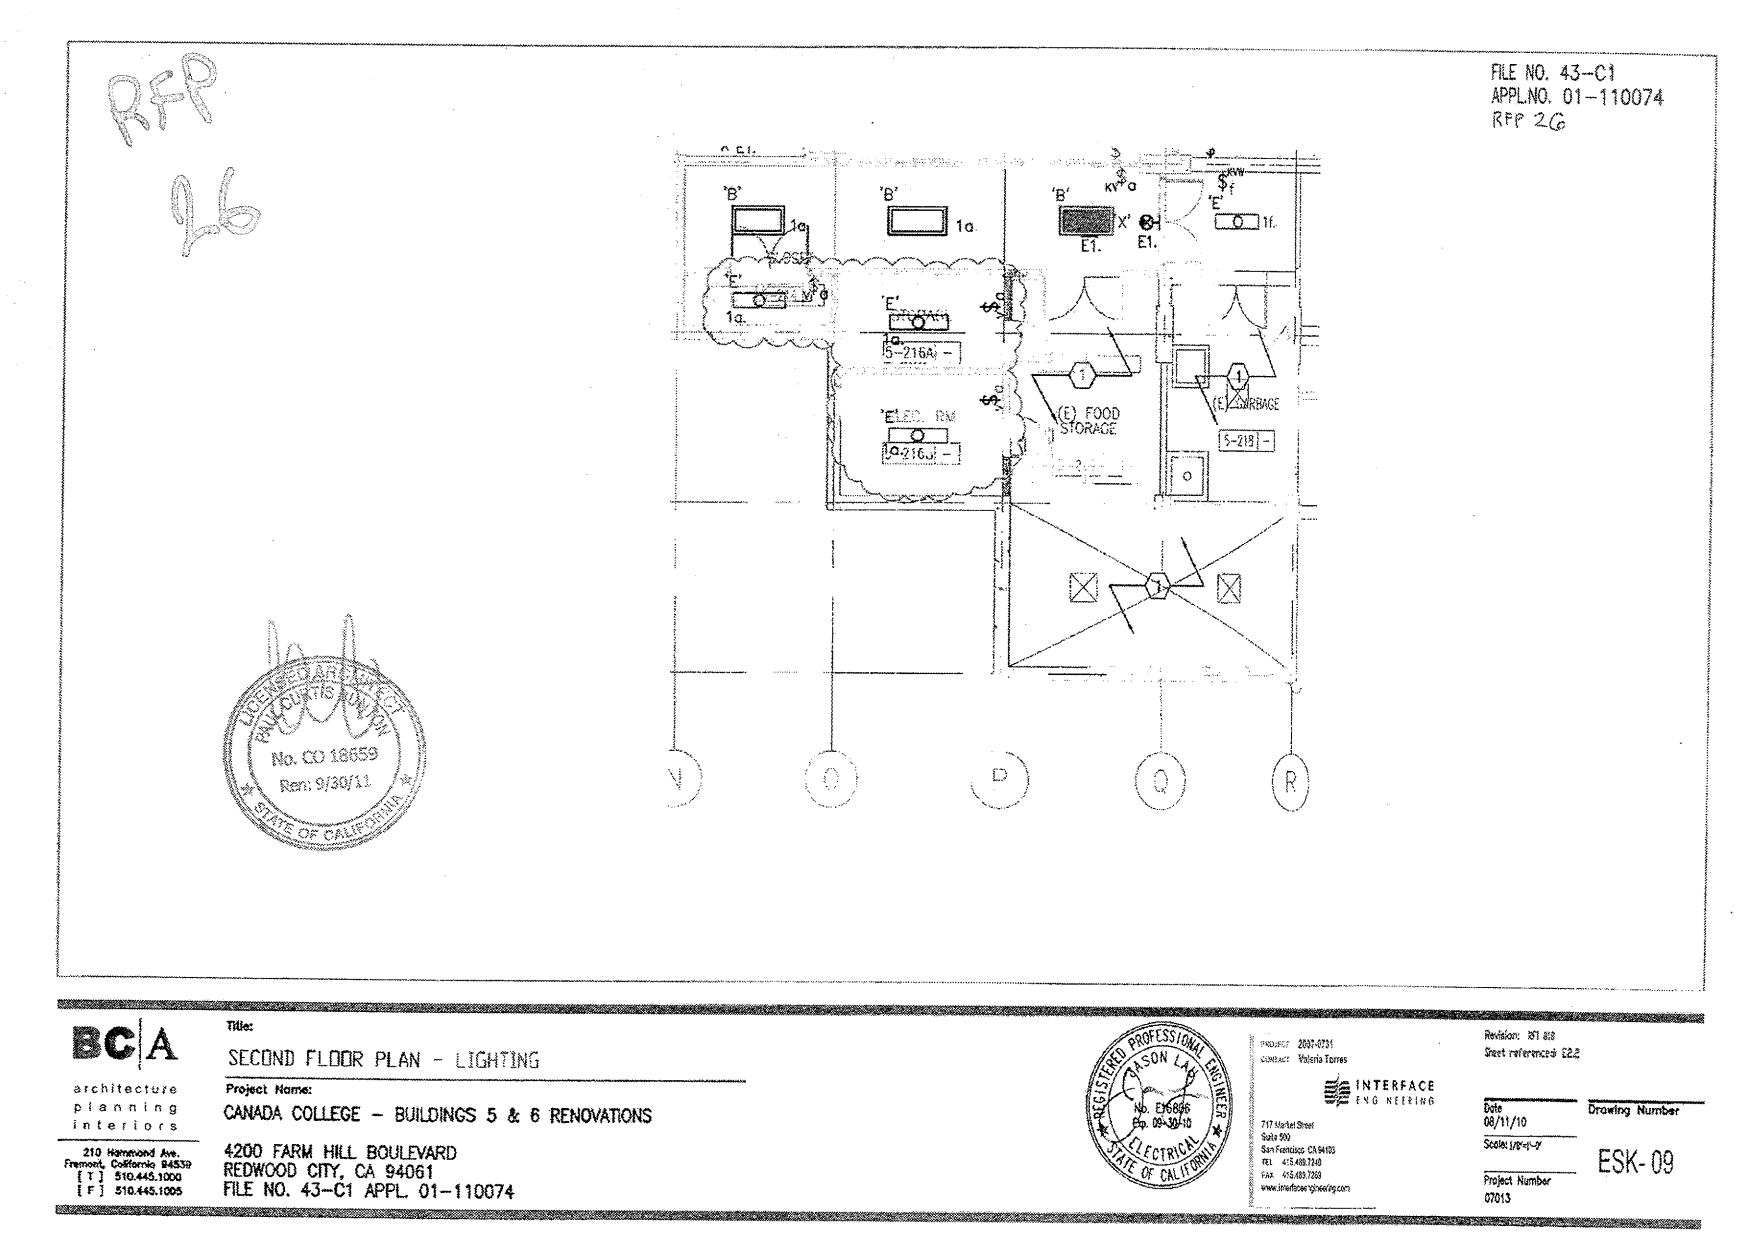


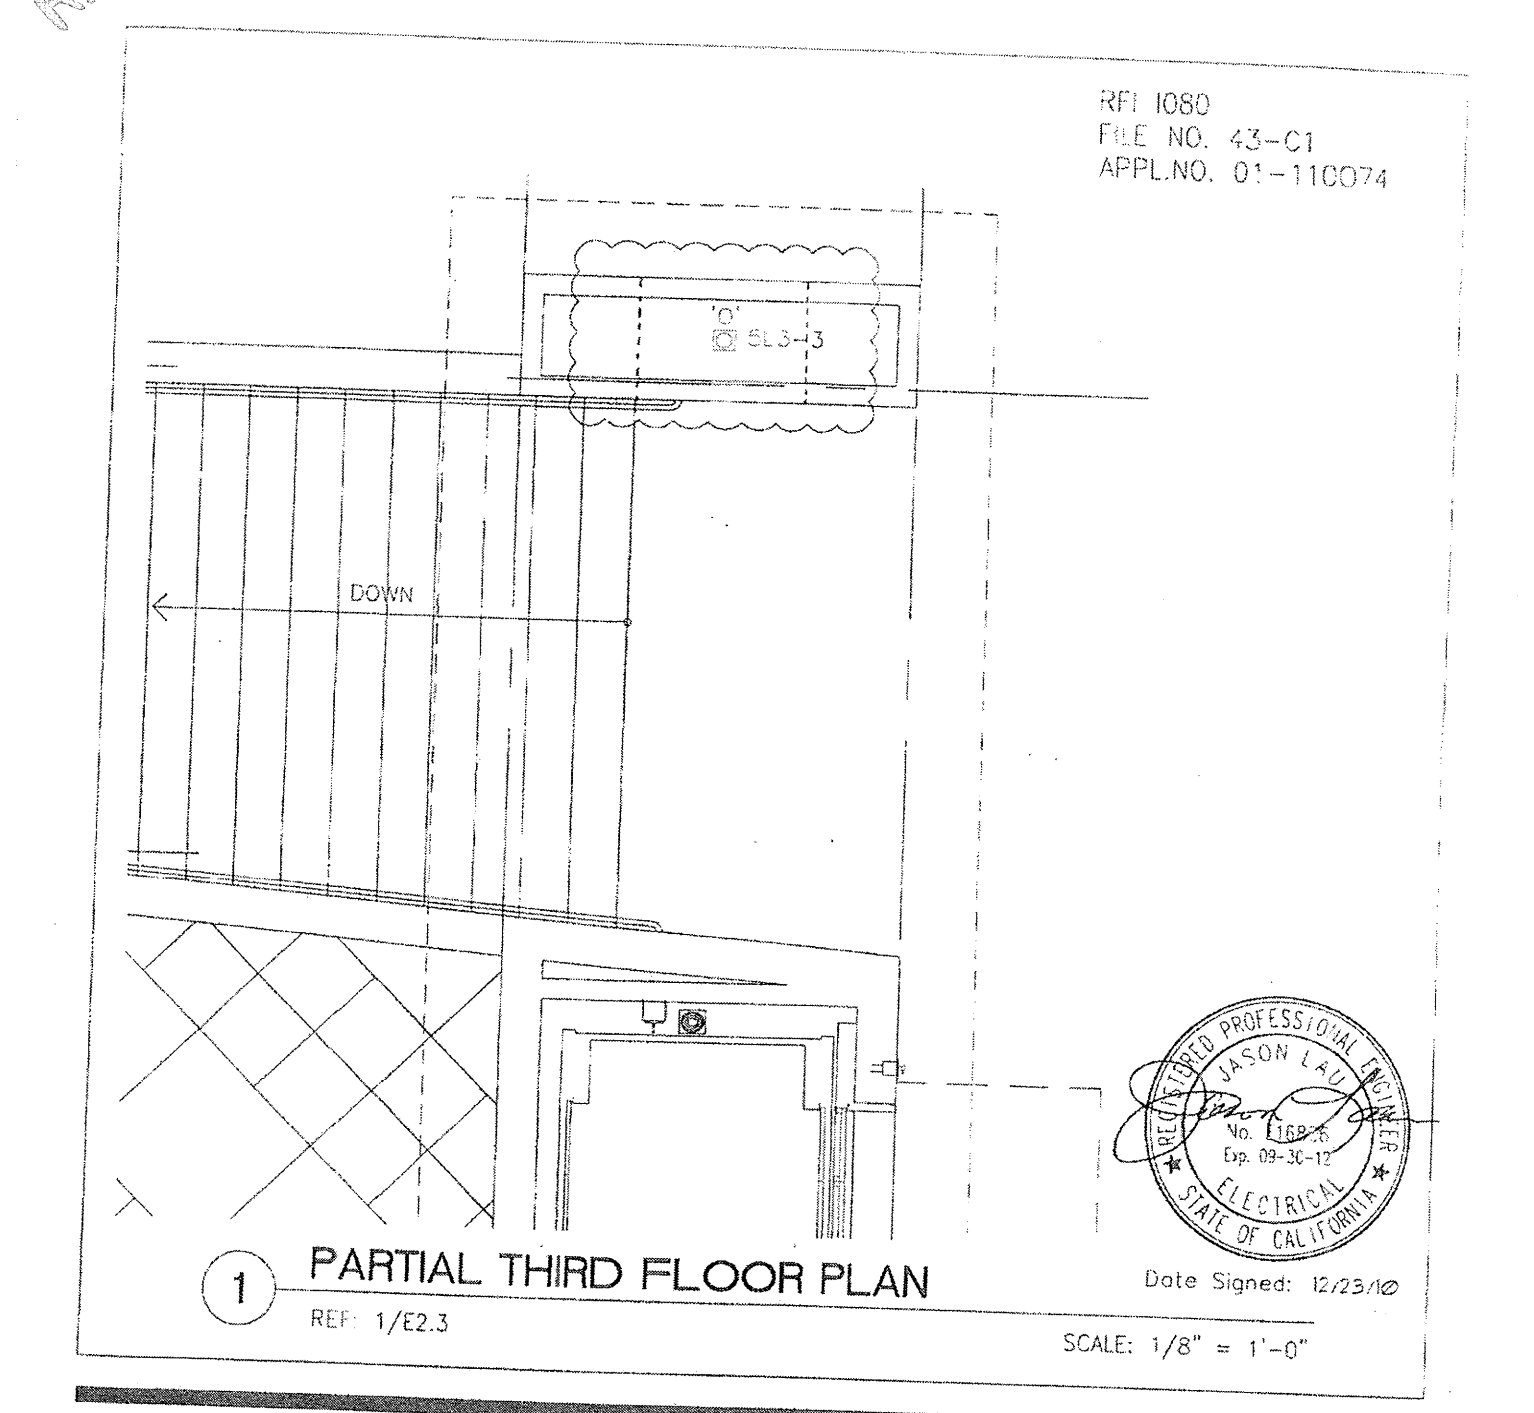

RFP-69

