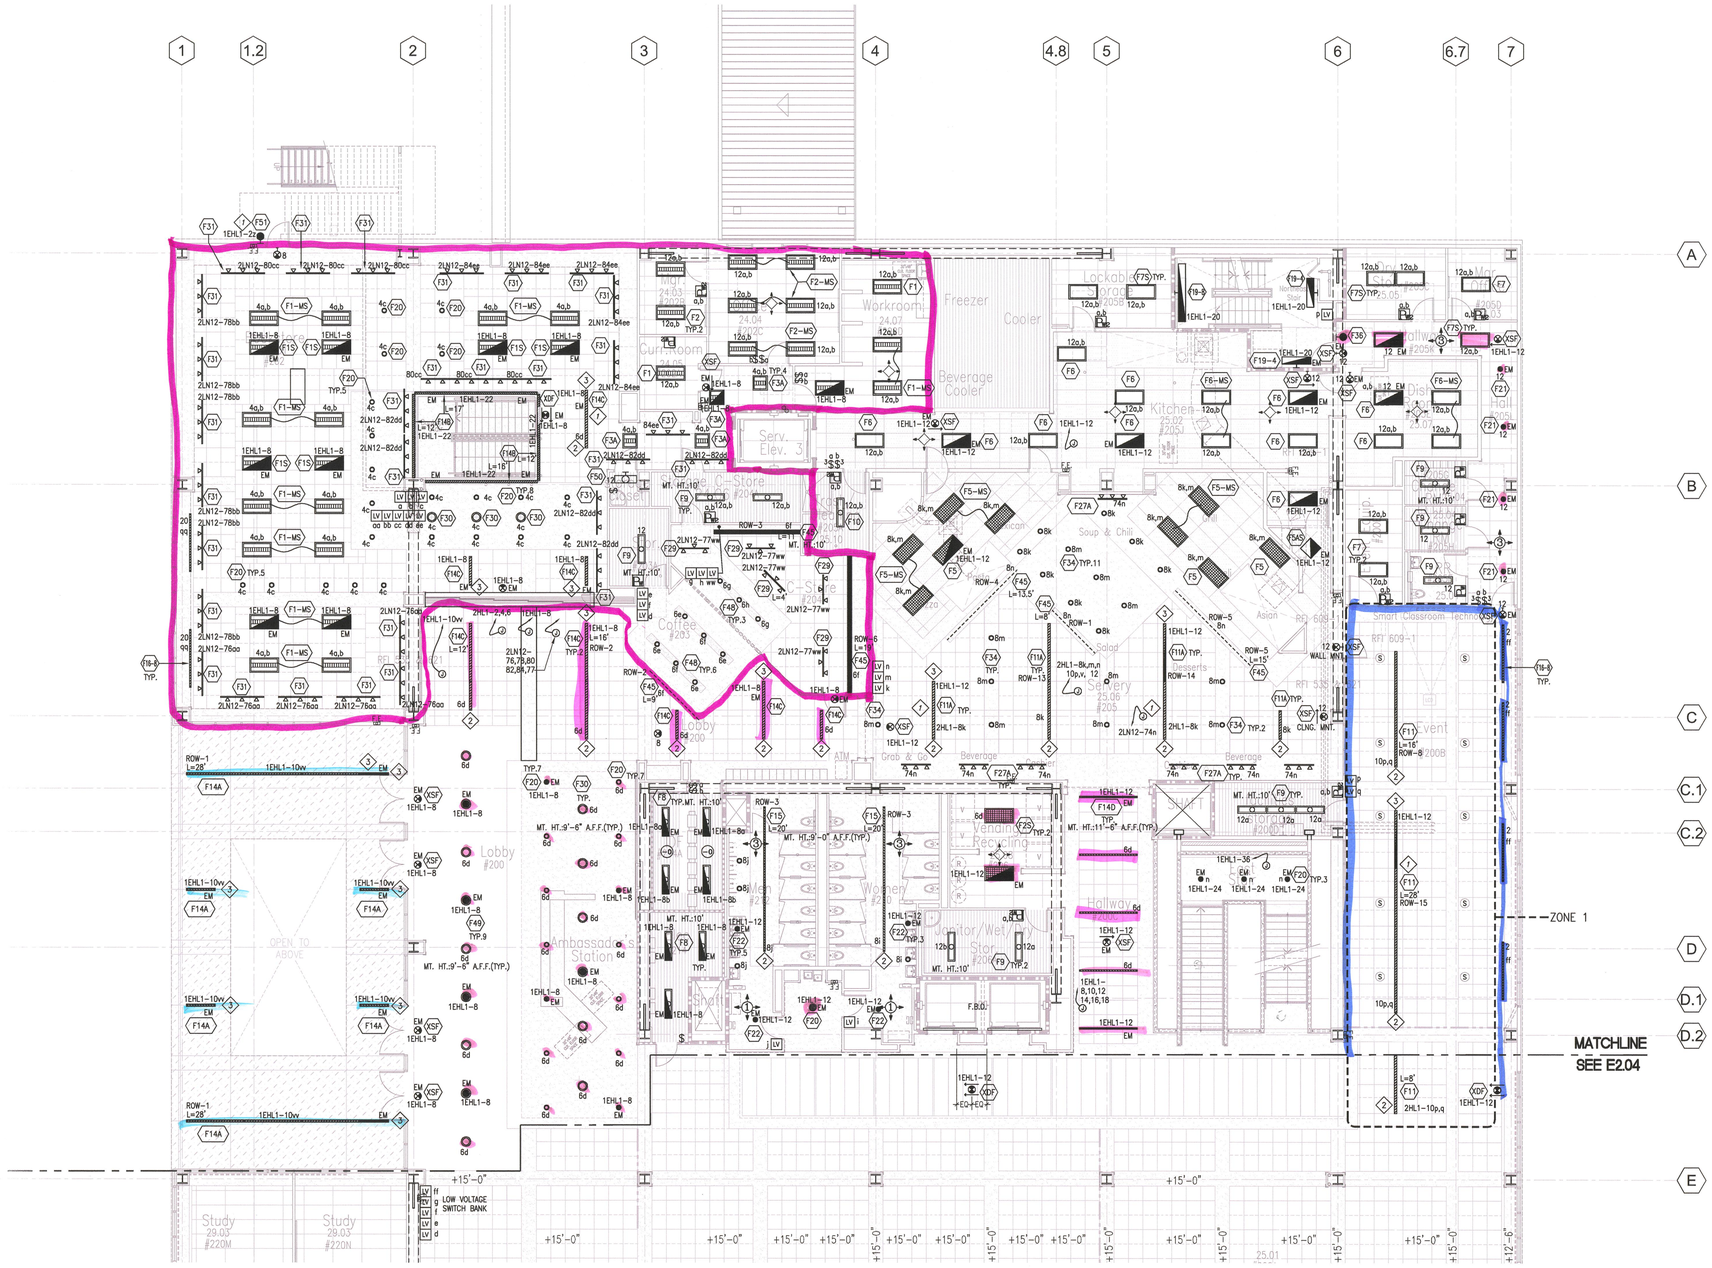

1 E2.03 Lighting Plan - Level 2 - North
SCALE:1/8"=1'-0"

GENERAL NOTES

A. ALL 277V, NORMAL LIGHTING DEVICES SHALL BE CIRCUITED TO PANEL "2HL1", U.O.N.

B. ALL 277V, EMERGENCY LIGHTING DEVICES SHALL BE CIRCUITED THRU EMERGENCY LIGHTING INVERTER TO PANEL "1EHL1", U.O.N.

C. ALL 120V, NORMAL LIGHTING DEVICES SHALL BE CIRCUITED TO PANEL "2LN11/2LN12", U.O.N.

D. ROUTE EXTERIOR LIGHTING CIRCUITRY VIA EXTERIOR PHOTOSENSOR MOUNTED ON ROOF FACING NORTH AND LCP. CONTROLS SHALL BE INTERFACED WITH BMS.

SHEET NOTES

1. ½ OF LAMPS IN LINEAR FIXTURES ARE CONNECTED TO AN EMERGENCY CIRCUIT AS INDICATED ON PLAN.
2. NORMAL POWER FEED END.
3. EMERGENCY POWER FEED END.

LEGEND: OCCUPANCY SENSORS

- CI-200
- DT-300
- PW PW-100
- PWZ PW-200
- UT-300-1
- UT-300-3

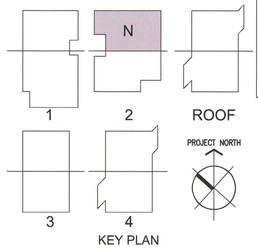

DRAWING OF RECORD
ROSENDIN ELECTRIC, INC.
DATE: 01-21-2011

McCarthy Building Companies, Inc.
343 Sansome Street, 14th Floor
San Francisco, California 94104
P 415 | 397-5151
F 415 | 397-5999

IDENTIFICATION STAMP
DIVISION OF THE STATE ARCHITECT
OFFICE OF REGULATION SERVICE
APPL. #: 01-110095
AC ____ FLS ____ SS ____
DATE ____
FILE NUMBER: 41-C1

REGISTERED PROFESSIONAL ENGINEER
ERNESTO ANTONIO HERNANDEZ
E015390
EXP.6/30/11
ELECTRICAL
STATE OF CALIFORNIA

ROSENDIN ELECTRIC
www.rosendin.com
CORPORATE HEADQUARTERS
880 Mabury Road
San Jose, CA 95133
(408) 286-2800
Arizona California Nevada New Mexico Oregon

This and all other project documents and all ideas, methodologies and designs incorporated therein are instruments of service. All project documents are the registered property of LPA, Inc. (LPA) and cannot be lawfully used in whole or in part for any project or purpose except as described in the contracted agreement between LPA and the client. LPA hereby grants limited license to the client to use the documents for reproduction or modification (release) in and only extent but authoritatively binds all parties involved with release to fully indemnify and defend LPA and LPA's Consultants to the maximum legal extent against all losses, demands, claims or suits arising out of or in any way related to such unauthorized release. Project documents describe design intent of work and are not a representation of as-built or existing conditions. LPA and LPA's Consultants make no representations concerning the accuracy of documents and are not responsible for any discrepancies between project documents and the existing conditions.

© Copyright 2007

College of San Mateo Building 10N

San Mateo, CA

Developed for:
San Mateo County Community College District

Revision	Description	Date
1	FCO 41 EXIT SIGN COORDINATION	07/27/10
2	PROVIDE ON AIR SIGN - FCO 041 12/14/09	
3	CONFIGURE PROGRAMMABLE AT #1 ELEVATOR - FCO 022	03/24/10
4	ADD CO2 SENSOR - FCO 022	03/24/10
5	MC 1-5 FINANCIAL AID CHANGES - FCO 138	03/24/10
6	4TH FLR V.P. SUITES CHANGES - FCO 139	03/24/10
7	4TH FLR CONFERENCE RMS 401 & 421 REMOVE - FCO 240	03/24/10
	ELECTRICAL-DRAWING OF RECORD	01/21/11

Revision	Description	Date
	100% Design Development	06/05/08
	50% Construction Documents	07/25/08
	DSA Submittal	10/14/08
	100% Construction Documents	12/19/08
	DSA Final	03/11/09
1	ELEC BM CHANGES PER ARCHT	07/28/09
2	FCO 014	08/05/09
3	4TH FLR OFFICES SEYBSON FOR OWNER - FCO 139	11/20/09

Job. No.
Date March 2009
Drawn by
Checked by
Scale

LIGHTING PLAN
LEVEL 2 - NORTH

E2.03

of San Mateo-Bldg 10N_300085\Electrical Design-DOR_01-07-2011\300085_10N_E2.03.dwg - Feb 14, 2011 Monday - 10:54am - 30x42-Plt - fferaren