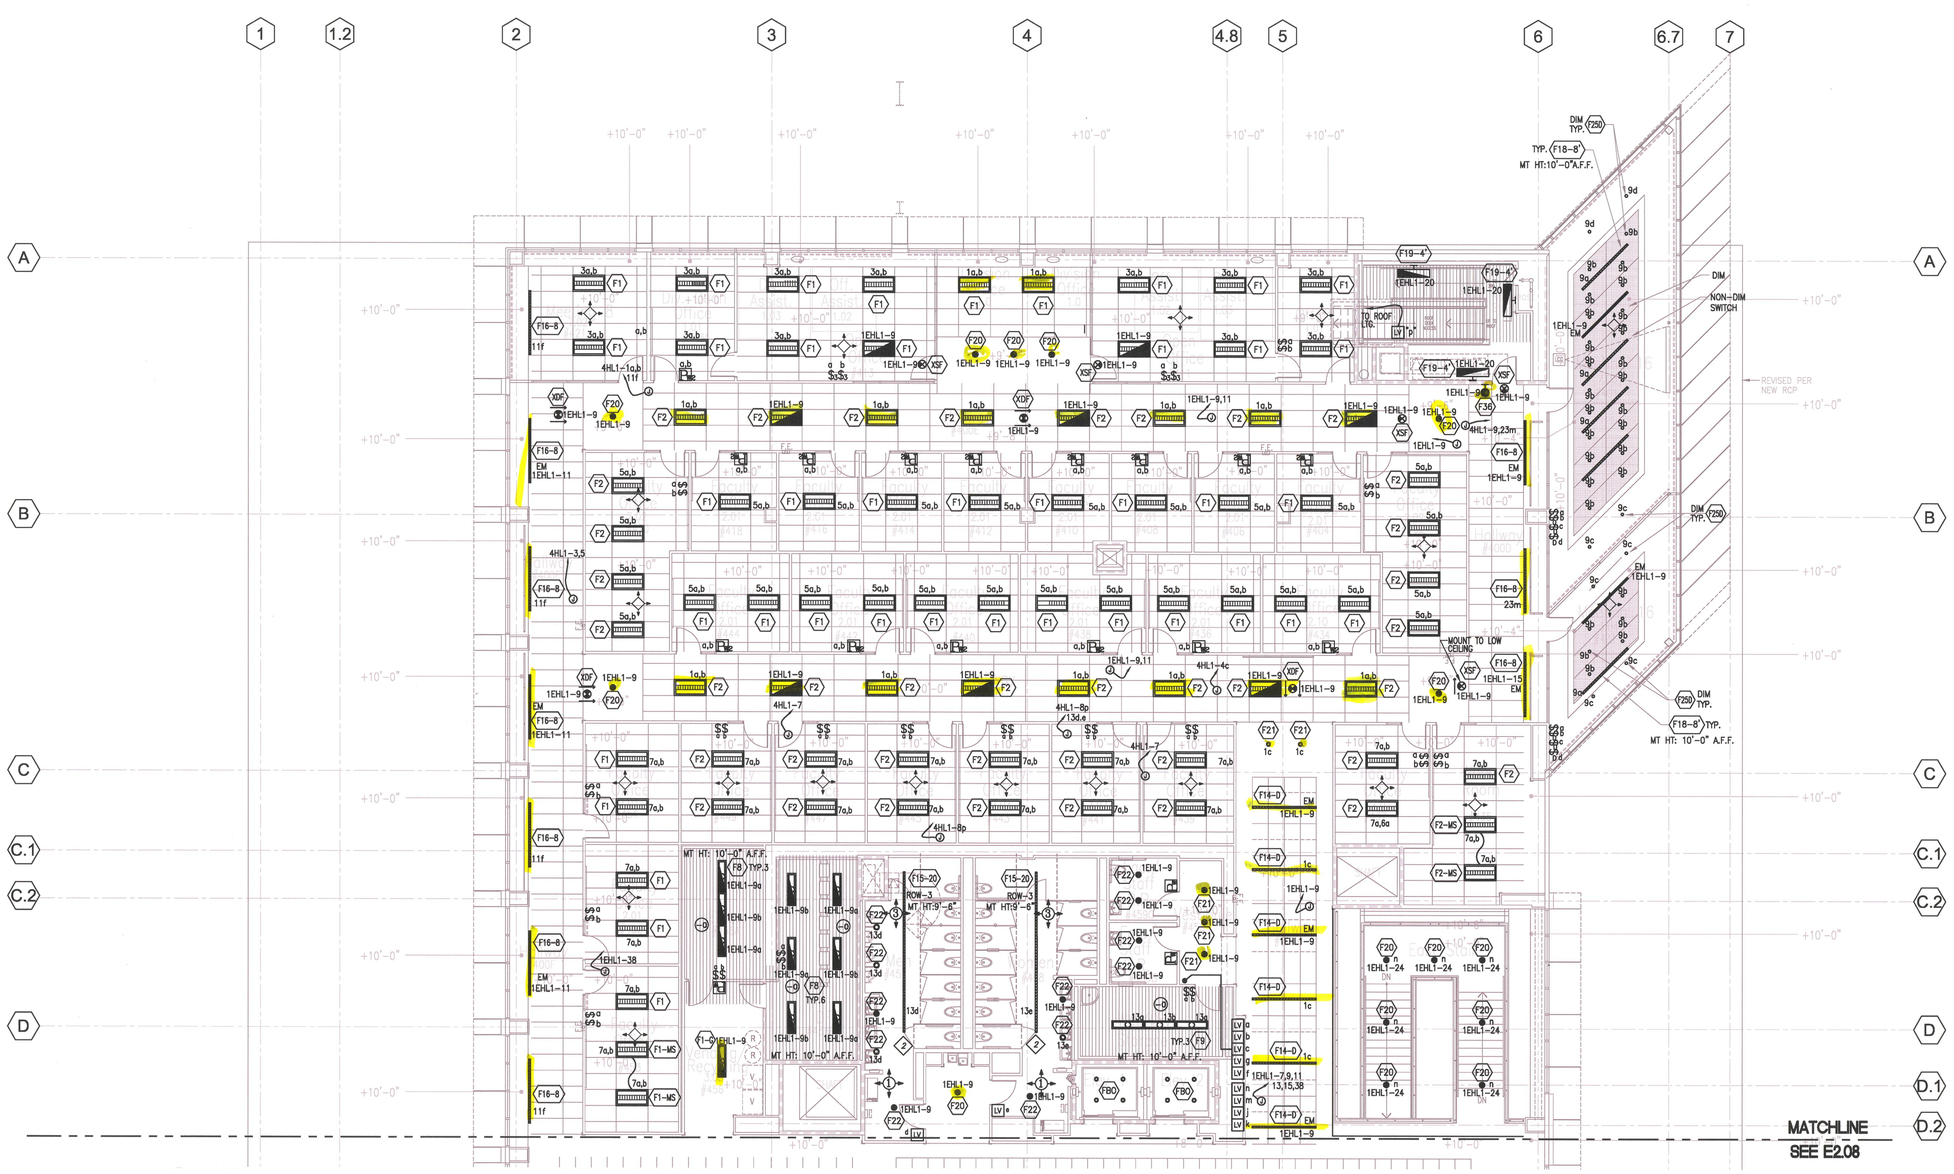

LEGEND: OCCUPANCY SENSORS

- CI-200
- DT-300
- PW PW-100
- PW2 PW-200
- UT-300-1
- UT-300-3

GENERAL NOTES

A.	ALL 277V, NORMAL LIGHTING DEVICES SHALL BE CIRCUITED TO PANEL "4HL1", U.O.N.
B.	ALL 277V, EMERGENCY LIGHTING DEVICES SHALL BE CIRCUITED THRU EMERGENCY LIGHTING INVERTER, TO PANEL "1EHL1", U.O.N.
C.	ALL 120V, NORMAL LIGHTING DEVICES SHALL BE CIRCUITED TO PANEL "4LN11/4LN12", U.O.N.

SHEET NOTES

1	NOT USED.
2	NORMAL POWER FEED END.

1 E2.07 Lighting Plan - Level 4 - North
SCALE:1/8"=1'-0"

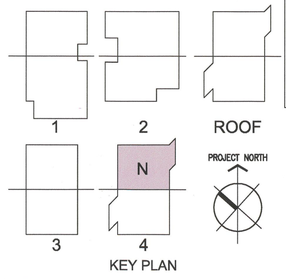

DRAWING OF RECORD
ROSENDIN ELECTRIC, INC.
DATE: 01-21-2011

McCarthy Building Companies, Inc.
343 Sansome Street, 14th Floor
San Francisco, California 94104
P 415 | 397-5151
F 415 | 397-5999

IDENTIFICATION STAMP
DIVISION OF THE STATE ARCHITECT
OFFICE OF REGULATION SERVICE
APPL. #: 01-110095
AC ____ FLS ____ SS ____
DATE ____
FILE NUMBER: 41-C1

REGISTERED PROFESSIONAL ENGINEER
ERNESTO ANTONIO HERNANDEZ
E015390
EXP.6/30/11
ELECTRICAL
STATE OF CALIFORNIA

BUILDING QUALITY BUILDING VALUE BUILDING PEOPLE
ROSENDIN ELECTRIC
www.rosendin.com
CORPORATE HEADQUARTERS
2500 Walsh Road
San Jose, Ca 95133
(408) 286-2800
Arizona California Nevada New Mexico Oregon

Title and all other project documents and all ideas, sketches and designs incorporated therein are instruments of service. All project documents are the registered property of LPA, INC. (LPA) and cannot be lawfully used in whole or in part for any project or purpose except as described in the contracted agreement between McCarthy and the District. LPA hereby gives formal notice that any such project document use, reproduction or modification (misuse) is not only unlawful but automatically binds all parties involved with misuse to fully indemnify and defend LPA and LPA's Consultants to the maximum extent allowed by law against any claims, damages or liabilities arising directly or indirectly from project document misuse. Project documents describe design intent of work and are not a representation of as-built or existing conditions. LPA and LPA's Consultants make no representations concerning the accuracy of documents and are not responsible for any discrepancies between project documents and the existing conditions.

© Copyright 2007

College of San Mateo
Building 10N

San Mateo, CA

Developed for
San Mateo County Community College District

Revision	Description	Date
7	FCO-14 EXIT SIGN COORDINATION	07/27/10
6	PROTOCOL ON AIR SIGN	FCO-141 12/14/09
5	DSA-SUBMITTAL ZIGBEE EXPANDED DISTRICT ELEVATOR CONTROLLER RELAY AT ELEV. OFFICE DSA-SUBMITTAL CANOPY MAJOR	FCO-132 03/24/10 03/24/10 03/24/10
4	3RD R.F.I. FINANCIAL AID CHANGES	FCO 038 03/24/10
3	4TH R.F.I. V.F. SUITES CHANGES	FCO-095 03/24/10
2	4TH R.F.I CORRIDOR 2 SMF-BT-1 AT 1ST FLOOR	FCO-096 03/24/10
1	ELECTRICAL - DRAWING OF RECORD	01/21/11

Revision	Description	Date
7	100% Design Development	05/08/08
6	50% Construction Documents	07/28/08
5	DSA Submittal	09/19/08
4	50% Construction Documents	12/08/08
3	DSA Final	03/11/09
2	ELEC ENG CHANGES PER ARCH'T	07/28/09
1	FCO 074	08/05/09
0	ADD'N'S & CHANGES REVISION PER OWNER - FCO 089	09/15/09 11/02/09

Job No.
Date March 2009
Drawn by
Checked by
Scale

LIGHTING PLAN
LEVEL 4 - NORTH

E2.07

\\RESJENG\S2ENG2\Eng_2\Current Projects\College of San Mateo-Bldg 10N_300085\Electrical Design-DOR_01-07-2011\300085_10N_E2.07.dwg - Feb 14, 2011 Monday - 10:55am - 30x42-Plt - fferaren