RFP 39

FCD – 47
FILE NO. 43–C1
APPL.NO. 01–110074
EXHIBIT 31 PHASE 3

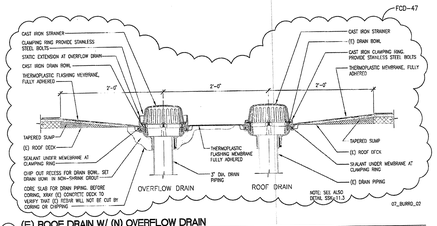

1 (E) ROOF DRAIN W/ (N) OVERFLOW DRAIN
NEW DETAIL

SCALE: 1 1/2" = 1'-0"

BC|A architecture planning interiors
303 Sacramento St. San Francisco, CA 94111-1029 (T) 415.956.0100 (F) 415.956.1005 www.BCArchitects.com

Title: NEW OVERFLOW DRAIN

Project Name: CANADA COLLEGE – BUILDINGS 5 & 6 RENOVATIONS SAN MATEO COUNTY COMMUNITY COLLEGE DISTRICT FILE NO. 43–C1 APPL. 01–110074 4200 FARM HILL BOULEVARD REDWOOD CITY, CA 94061

Revision: | Date: 05/21/10 | Scale: AS NOTED | Project Number: 0203 | Drawing Number: ASK- 17E

RFP 39

FCD – 47
FILE NO. 43–C1
APPL.NO. 01–110074
EXHIBIT 31 PHASE 3

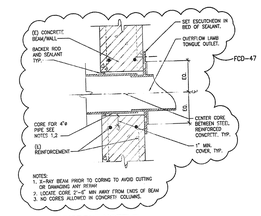

1 DOWNSPOUT NOZZLE
NEW DETAIL

SCALE: 3" = 1'-0"

BC|A architecture planning interiors
303 Sacramento St. San Francisco, CA 94111-1029 (T) 415.956.0100 (F) 415.956.1005 www.BCArchitects.com

Title: NEW OVERFLOW DRAIN

Project Name: CANADA COLLEGE – BUILDINGS 5 & 6 RENOVATIONS SAN MATEO COUNTY COMMUNITY COLLEGE DISTRICT FILE NO. 43–C1 APPL. 01–110074 4200 FARM HILL BOULEVARD REDWOOD CITY, CA 94061

Revision: | Date: 05/21/10 | Scale: AS NOTED | Project Number: 0203 | Drawing Number: ASK- 17F

RFP 44

FILE NO. 43–C1
APPL.NO. 01–110074

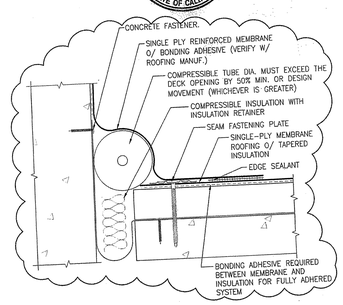

1 EXPANSION JOINT DETAIL
REF: NEW DETAIL

SCALE: NTS

BC|A architecture planning interiors

Title: EXPANSION JOINT

Project Name: CANADA COLLEGE – BUILDINGS 5 & 6 RENOVATIONS SAN MATEO COUNTY COMMUNITY COLLEGE DISTRICT 4200 FARM HILL BOULEVARD REDWOOD CITY, CA 94061 FILE NO. 43–C1 APPL. 01–110074

Revision: | Date: 10/20/10 | Scale: AS NOTED | Project Number: 0210 | Drawing Number: ASK- 23