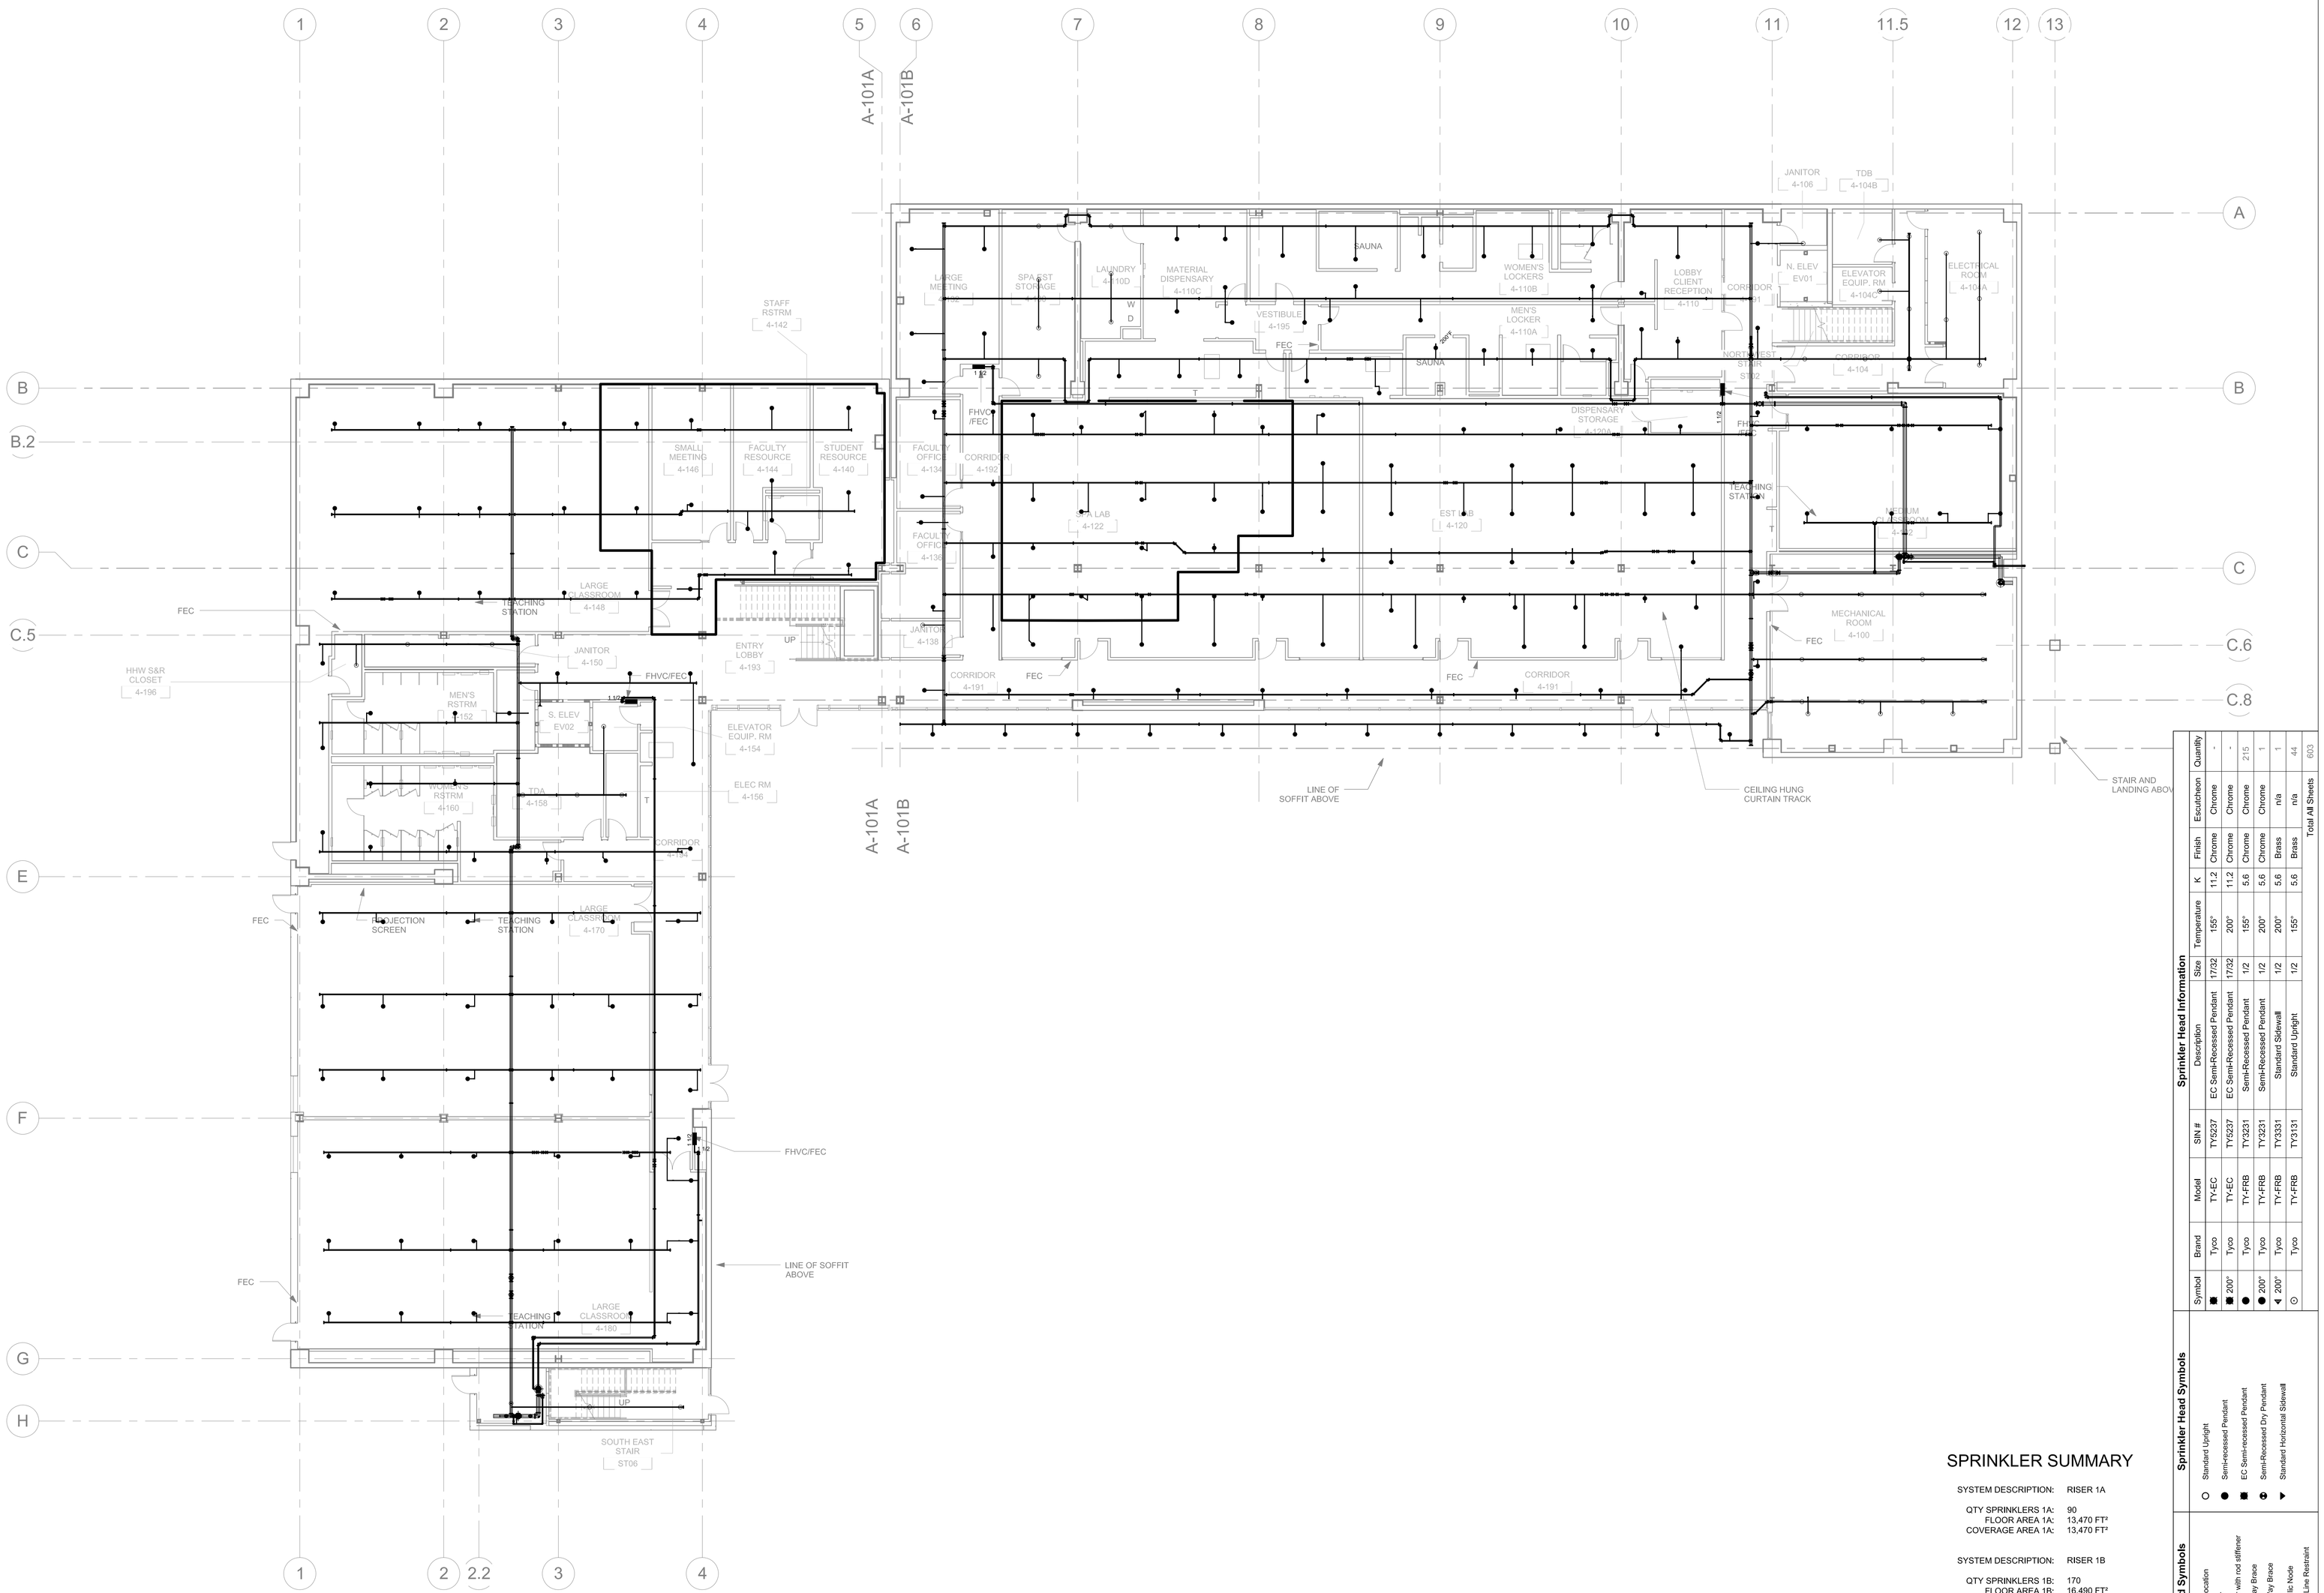

1 LEVEL 1 OVERALL FIRE PROTECTION FLOOR PLAN
3/32" = 1'-0"

SPRINKLER SUMMARY

SYSTEM DESCRIPTION:	RISER 1A
QTY SPRINKLERS 1A:	90
FLOOR AREA 1A:	13,470 FT²
COVERAGE AREA 1A:	13,470 FT²
SYSTEM DESCRIPTION:	RISER 1B
QTY SPRINKLERS 1B:	170
FLOOR AREA 1B:	16,490 FT²
COVERAGE AREA 1B:	16,490 FT²
TOTAL SPRINKLERS THIS FLOOR	260
TOTAL AREA THIS FLOOR:	29,960 FT²

0' 4' 8' 12' 16' 20' 24' 28' 32'
3/32" = 1'-0"

Sprinkler Head Information

Symbol	Brand	Model	SIN #	Description	Size	Temperature	K	Finish	Escutcheon	Quantity
■	Tyco	TY-EC	TY5237	EC Semi-Recessed Pendant	17/32	155°	11.2	Chrome	Chrome	-
■ 200°	Tyco	TY-EC	TY5237	EC Semi-Recessed Pendant	17/32	200°	11.2	Chrome	Chrome	215
●	Tyco	TY-FRB	TY3231	Semi-Recessed Pendant	1/2	155°	5.6	Chrome	Chrome	1
● 200°	Tyco	TY-FRB	TY3231	Semi-Recessed Pendant	1/2	200°	5.6	Chrome	n/a	1
◀ 200°	Tyco	TY-FRB	TY3231	Standard Sidewall	1/2	200°	5.6	Brass	n/a	44
⊙	Tyco	TY-FRB	TY3131	Standard Upright	1/2	155°	5.6	Brass	n/a	603
									Total All Sheets	

Sprinkler Head Symbols

○ Standard Upright ● Semi-recessed Pendant ■ EC Semi-recessed Pendant ● Semi-Recessed Dry Pendant ▶ Standard Horizontal Sidewall

Standard Symbols

Riser Location · Hanger · Hanger with rod stiffener · Two Way Brace · Four Way Brace · Hydraulic Node · End of Line Restraint

North

All drawings and written material appearing herein constitute original and unpublished work of the Architect/Engineer and may not be duplicated, used or disclosed without consent of Architect/Engineer.

If this drawing is not 30"x42", then the drawing has been revised from its original size. Noted scales must be adjusted. This line should be equal to one inch

WRNS STUDIO LLP
501 SECOND STREET
4TH FLOOR, STE. 402
SAN FRANCISCO
CALIFORNIA 94107
415.489.2224 TEL
415.358.9100 FAX
WWW.WRNSSTUDIO.COM

Steinberg Architects

Hensel Phelps Construction Co.

TRANSBAY FIRE PROTECTION, INC.
License No. 629778
2182 Rheem Dr. Pleasanton, CA 94588
(925) 846-9484 Fax (925) 846-9710

NO.	ISSUES/REVISIONS	DATE
1	100% SCHEMATIC DESIGN SUBMITTAL	04/28/08
2	50% DESIGN DEVELOPMENT SUBMITTAL	06/13/08
3	100% DESIGN DEVELOPMENT SUBMITTAL	07/28/08
4	DSA INCREMENT #1: SITE DEMOLITION, EXCAVATION, ROUGH GRADING & UTILITIES	09/25/08
5	DSA INCREMENT #2: 80% REVIEW	10/10/08
6	DSA INCREMENT #2: STRUCTURE & GFRC PANELS	11/11/08
7	DSA INCREMENT #3: 50% REVIEW	11/11/08
8	DSA INCREMENT #1: BACK CHECK	11/19/08
9	DSA INCREMENT #3: 90% REVIEW	12/19/08
10	DSA INCREMENT #3: TENANT IMPROVEMENT AND ROOFING SYSTEM	02/09/09
14	DSA INCREMENT #3: BACKCHECK	05/12/09
	AS-BUILT DRAWINGS	02/07/11

DIVISION OF THE STATE ARCHITECT
APPL # 01-110117
FILE # 41-C1
AC _____ FLS _____
SSS _____ DATE _____
IDENTIFICATION STAMP

Increment 3

SKYLINE COLLEGE

SAN MATEO COUNTY COMMUNITY COLLEGE DISTRICT

CIP2 DESIGN-BUILD PROJECT BUILDING 4 INCREMENT 3

PROJECT NO.: 07055.00 DRAWN BY: CN
DATE: 02/07/11 CHECKED BY: CM
SCALE: 3/32" = 1'-0"

SHEET TITLE:

LEVEL 1 OVERALL FIRE PROTECTION FLOOR PLAN

SHEET NO:

FP-101