

PROJECT TEAM

Table with 3 columns: Construction Management, Architects, Mechanical Engineer, Civil Engineers, Electrical Engineer, Structural Engineers. Lists project team members and contact information.

Cañada College Modernization

CENTRAL PLANT RENOVATION
San Mateo County Community College District

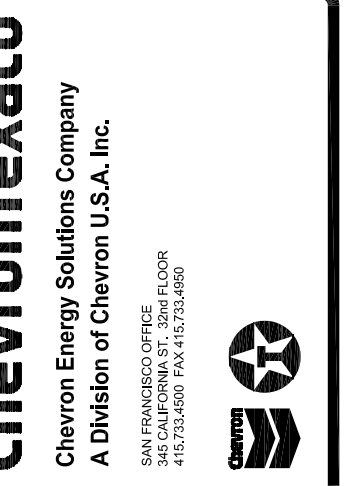


Table with columns: REV, DATE, BY, DESCRIPTION. Revision table for the drawing.

ARCHITECT'S STATEMENT

With the exception of the General (G Series) and Architectural (A Series) these drawings and/or specifications and/or calculations for the items listed above have been prepared by other design professionals or consultants who are licensed and/or authorized to prepare such drawings in this state.


The items listed above have been coordinated with my plans and specifications and are acceptable for incorporation into the construction of this project for which I am the individual designated to be in general responsible charge.

The accepted drawings are listed below.

Christopher Noll, Principal
NOLL & TAM Architects

CA License No C15915 Expiration Date: 12/31/05


GENERAL SITE PLAN

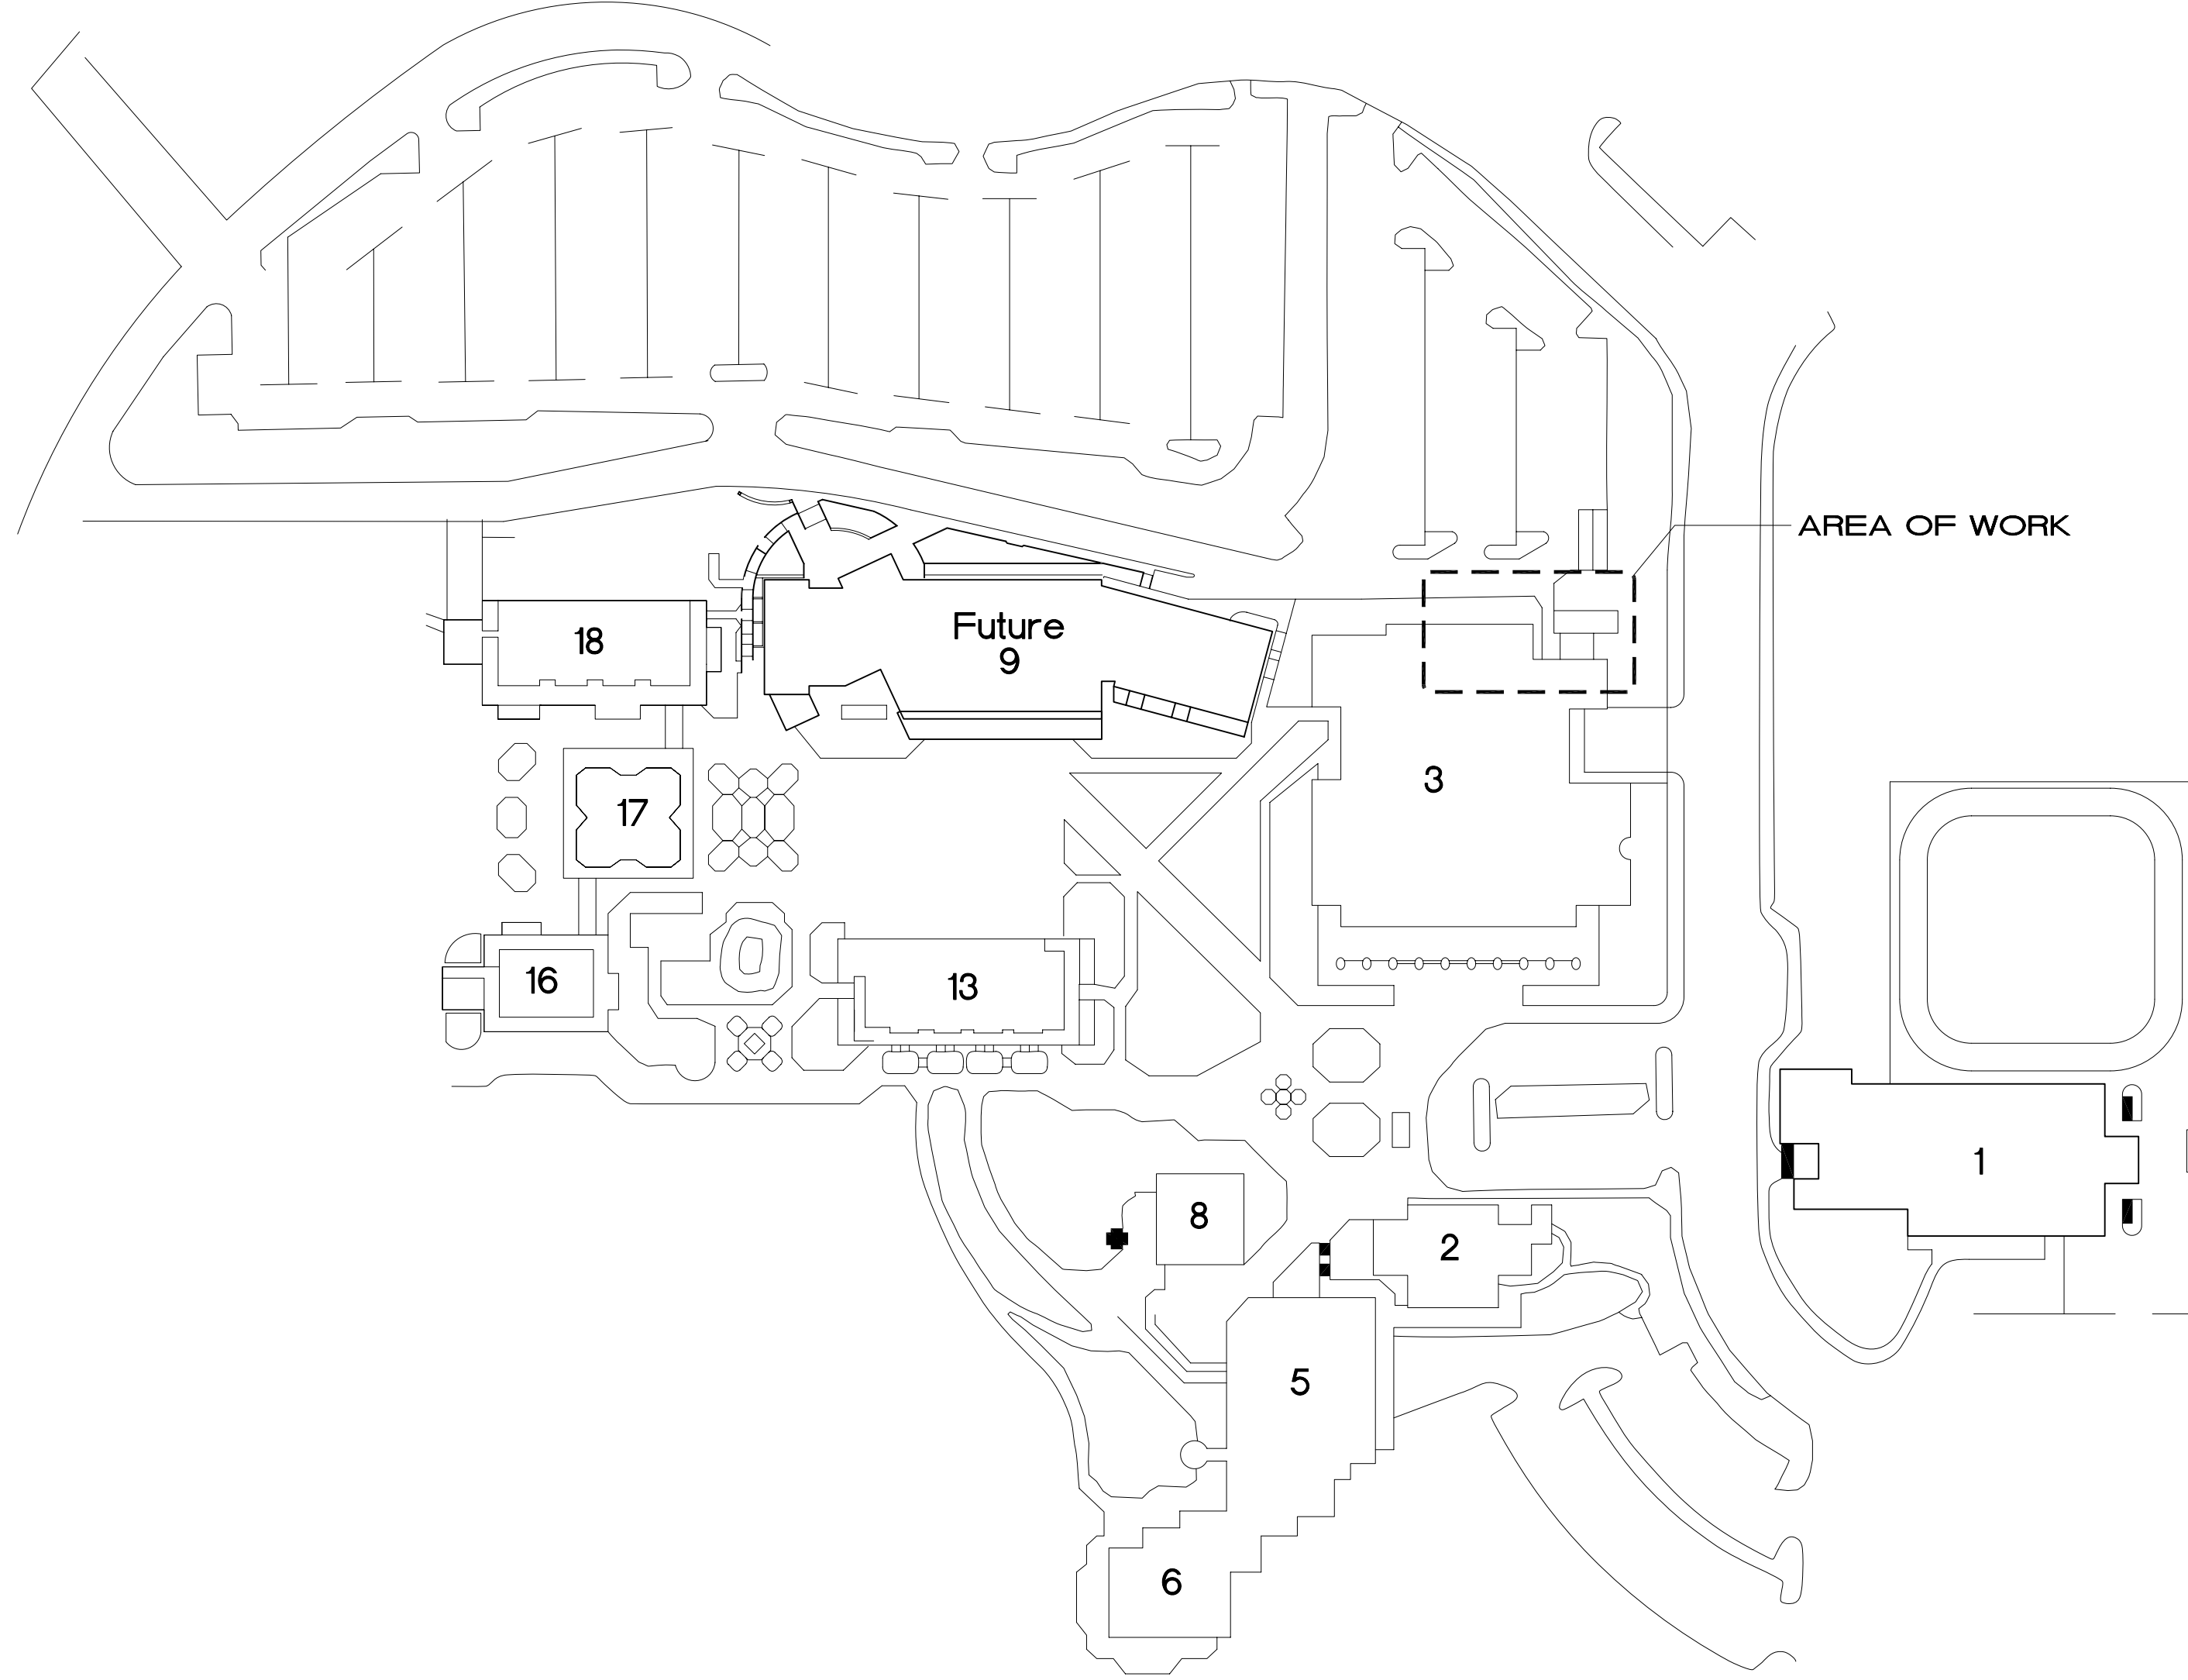

LEGEND
FUTURE BUILDING
EXISTING BUILDINGS

GENERAL SITE PLAN
N.T.S. Reference North

VICINITY MAP

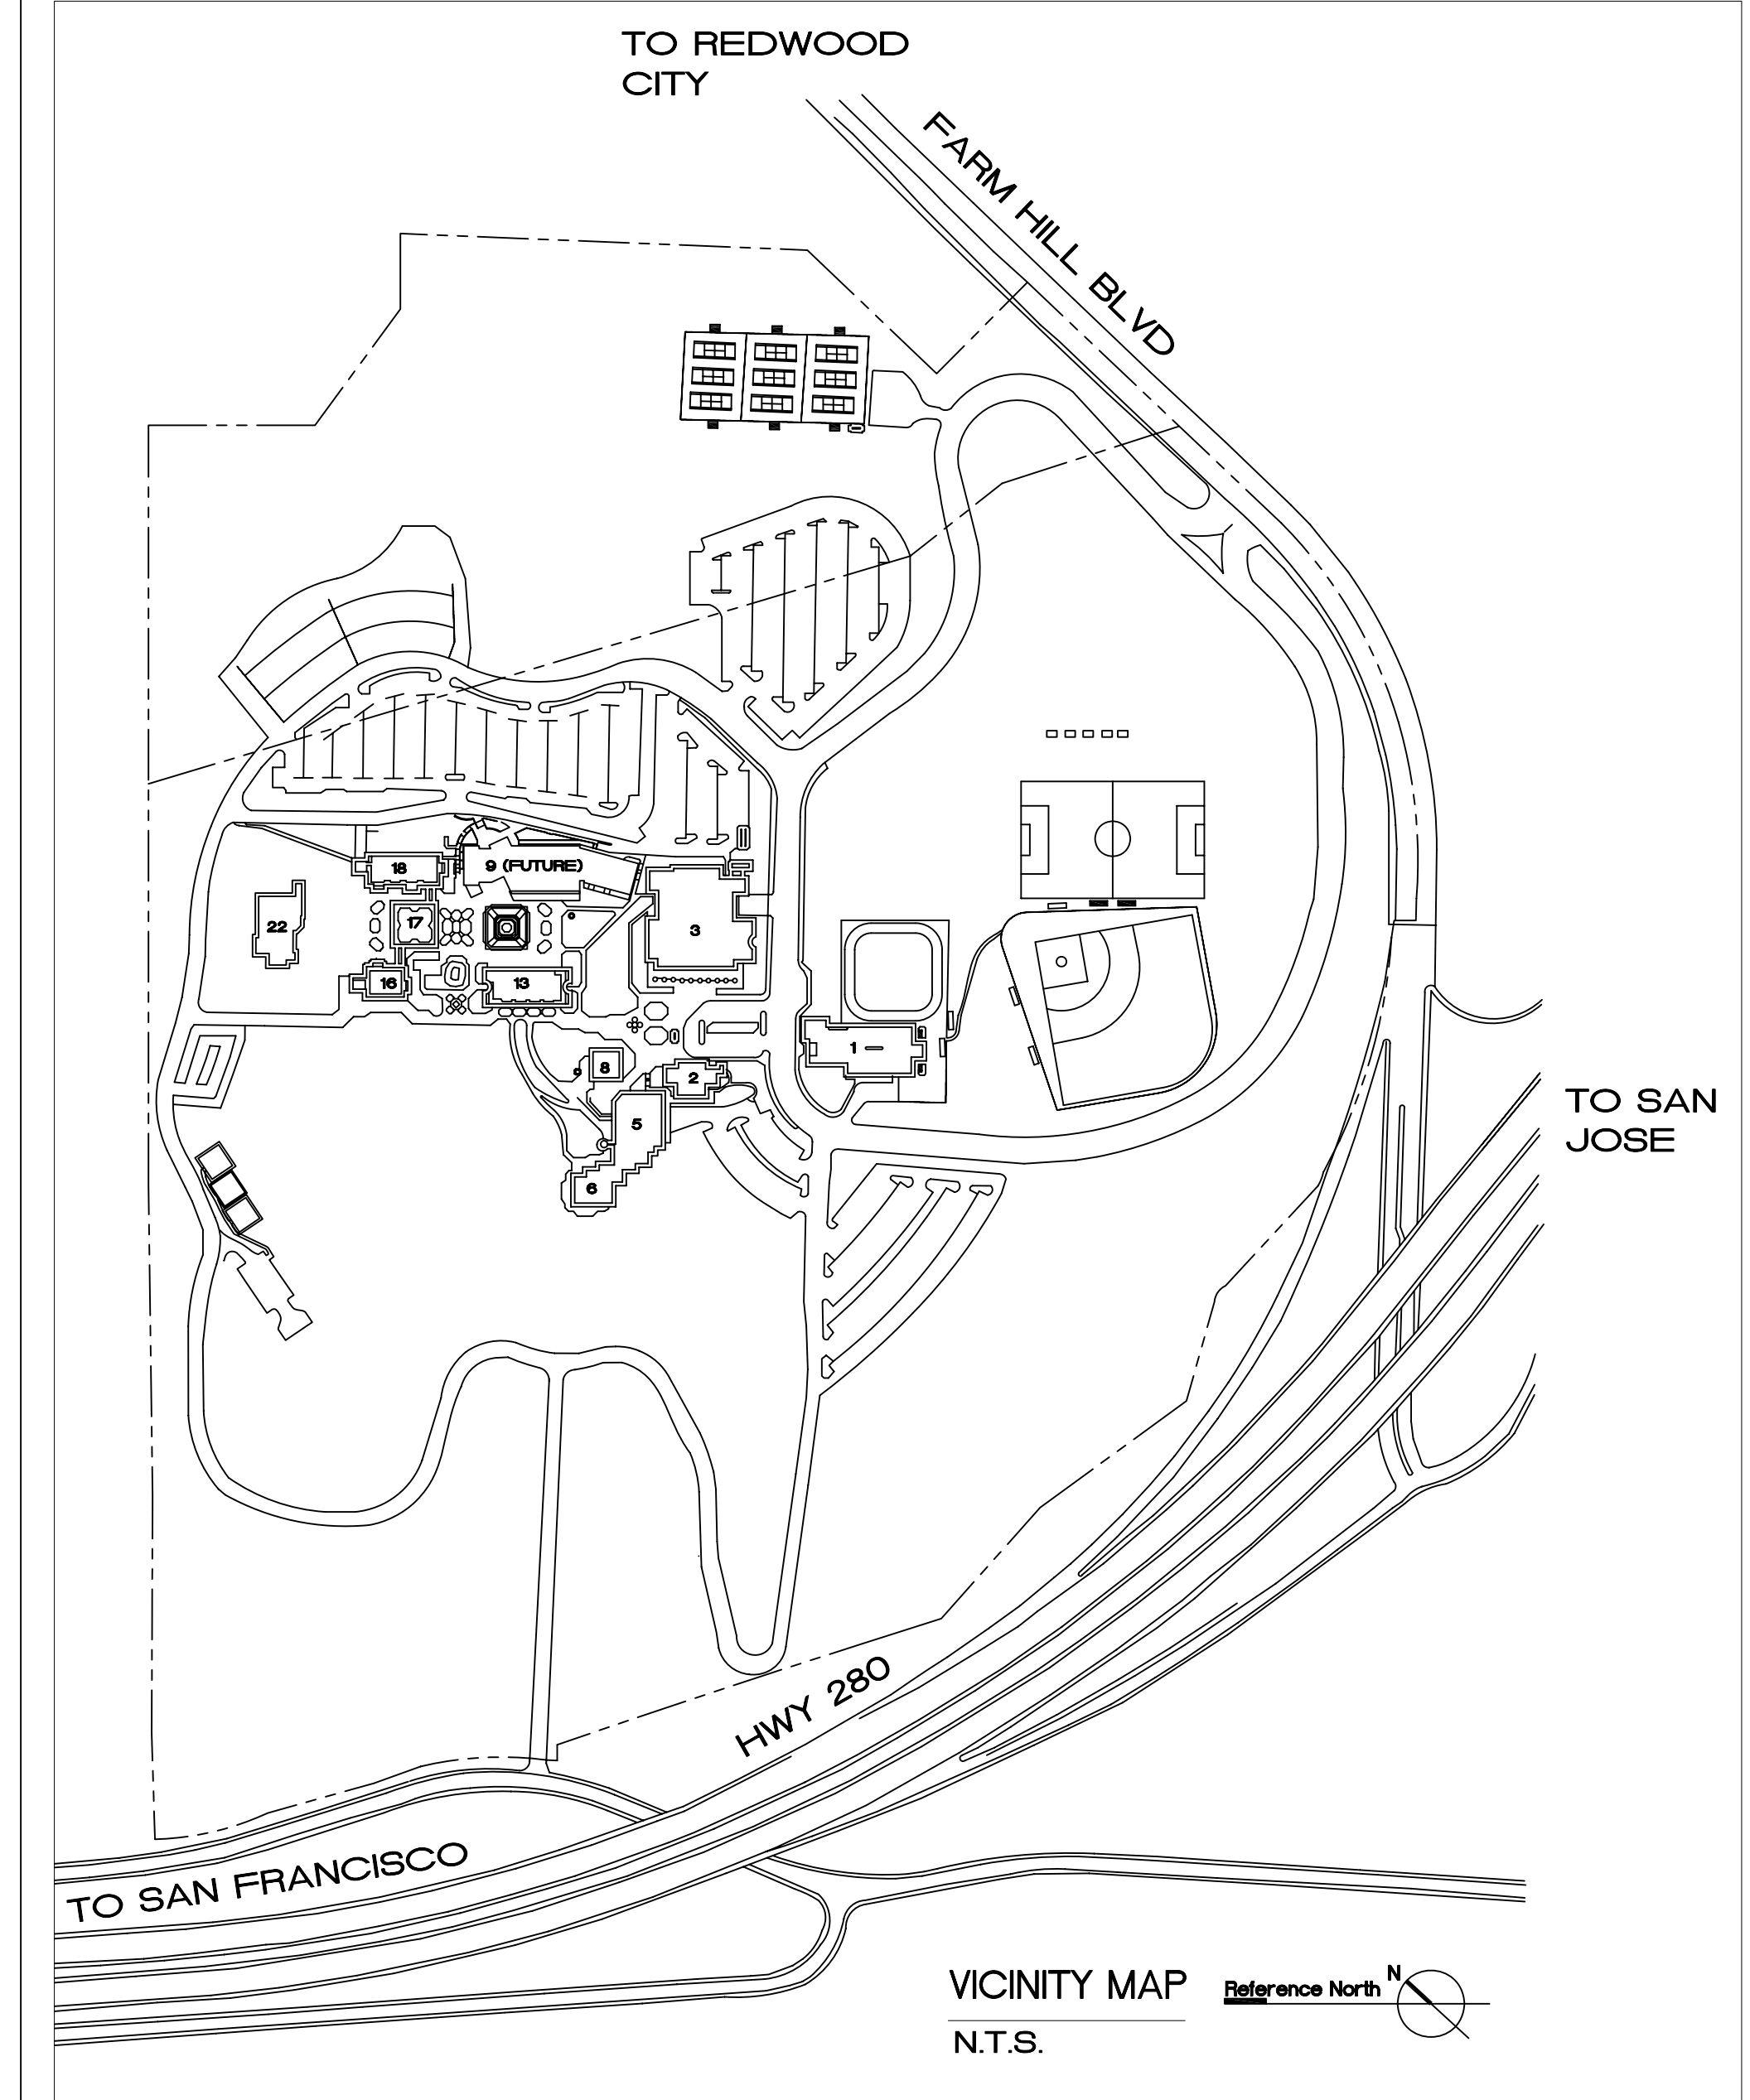

VICINITY MAP
N.T.S. Reference North

INDEX OF DRAWINGS

Table with 2 columns: GENERAL, MECHANICAL, ELECTRICAL. Lists drawing titles and their corresponding sheet numbers (e.g., G0.0 COVER SHEET, M-01 COVER SHEET AND GENERAL NOTES).

ABBREVIATIONS

Table of abbreviations with 3 columns: Abbreviation, Description, and Symbol. Lists terms like ANCHOR BOLT, ASPHALTIC CONC, CONCRETE, etc.

CODE COMPLIANCE

Table of code compliance with 2 columns: Code Title and Description. Lists California codes (2001 CALIFORNIA CODES, CHAPTER 4 PART 1, TITLE 24) and their application to the project.


SCOPE OF WORK

BASE BID: ALTERATION TO BUILDING 3
FURNISH ADDITIONAL CHILLER, NEW COOLING TOWER AND ASSOCIATED ELECTRICAL, SITE AND UTILITY WORK.

PROJECT INFORMATION

Table with 2 columns: DEFERRED APPROVAL ITEMS and DSA APPLICATION NUMBERS. Lists items to be deferred and their corresponding DSA numbers.

CLOSEOUT DOCUMENTS
11/01/06

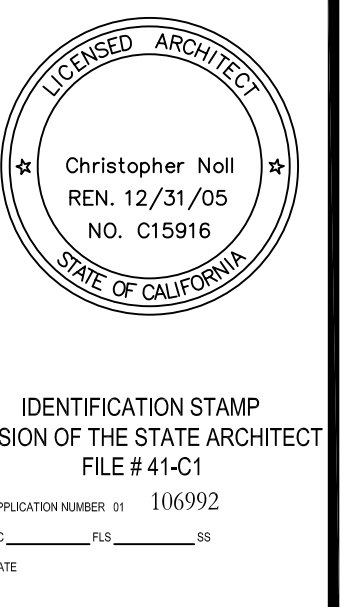

Canada College Modernization
CENTRAL PLANT RENOVATION
San Mateo County Community College District

Cover Sheet

Table with columns: SCALE, SHEET NO., DRAWN BY, CHECKED BY, DATE. Project information table.

