SYMBOLS

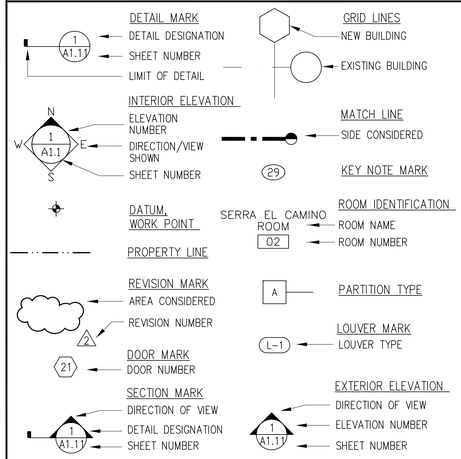

GENERAL NOTES

1. ALL CONSTRUCTION MATERIALS AND WORKMANSHIP SHALL CONFORM TO THE PROJECT SPECIFICATIONS AND WITH THE SMCCCD DESIGN STANDARDS.
2. ALL WORK SHALL MEET OR EXCEED THE MINIMUM STANDARDS OF THE EDITION OF THE CODES AND REGULATIONS LISTED ON G0.00 INCLUDING ALL SUPPLEMENTS.
3. INFORMATION CONTAINED WITHIN THESE DOCUMENTS SHALL NOT BE CONSTRUED TO PERMIT WORK NOT CONFORMING TO THE REFERENCED CODES.
4. CONTRACTOR SHALL EXAMINE THE DOCUMENTS AND SHALL NOTIFY THE ARCHITECT OF ANY DISCREPANCIES WHICH MAY BE FOUND PRIOR TO THE START OF WORK.
5. ALL ADDENDA AND SPECIFICATIONS BOUND SEPARATELY ARE A PART OF THE CONTRACT DOCUMENTS.
6. ITEMS MARKED "N.I.C." ARE NOT IN CONTRACT. SUCH ITEMS ARE INCLUDED IN THE DOCUMENTS WHEN CONTRACTOR'S COORDINATION IS REQUIRED OR FOR CLARIFICATION OF PROJECT LIMITS.
7. DIMENSIONS:
   IN NO CASE SHALL WORKING DIMENSIONS BE SCALED FROM THE DRAWINGS.
   ALL DIMENSIONS ARE TO THE ROUGH OPENING UON.
   ALL DIMENSIONS TO STUD WALLS ARE TO THE FACE OF FINISH, UON.
   CEILING HEIGHT DIMENSIONS ARE FROM FINISHED FLOOR TO FINISHED FACE OF CEILING, UON.
   ALL DIMENSIONS SHALL BE VERIFIED IN THE FIELD BY GENERAL CONTRACTOR AND ALL SUB-CONTRACTORS PRIOR TO PROCEEDING WITH CONSTRUCTION.
   COORDINATE WITH EQUIPMENT CONTRACTORS FOR ROUGH-IN DIMENSIONS AND TEMPLATES.
8. DETAILS MARKED "TYPICAL" SHALL APPLY IN ALL CASES, UON.
   WHERE NO SPECIFIC DETAIL IS SHOWN, THE FRAMING OR CONSTRUCTION SHALL BE IDENTICAL OR SIMILAR TO THAT INDICATED FOR LIKE CASES OF CONSTRUCTION ON THE PROJECT.

ABBREVIATIONS

AB	ANCHOR BOLT
AC	ASPHALTIC CONC
ACC	ACCESS
ACOUS	ACOUSTICAL
AD	AREA DRAIN
ADJ	ADJACENT/ADJUSTABLE
AFF	ABOVE FINISHED FLOOR
AFP	ABOVE FINISHED PAVING
AGG	AGGREGATE
ALT	ALTERNATE
ALUM	ALUMINUM
&	AND
ANOD	ANODIZED
APPROX	APPROXIMATE
@	AT
BO	BOTTOM OF
BD	BOARD
BLDG	BUILDING
BLK	BLOCK
BLKG	BLOCKING
BM	BEAM
BOT	BOTTOM
BUR	BUILT UP ROOFING
CB	CARRIAGE BOLT
CE	CIVIL ENGINEER
CER	CERAMIC
CEM	CEMENT/CEMENTITIOUS
CJ	CONTROL JOINT
CMU	CONCRETE MASONRY UNIT
CO	CLEAN OUT
CAB	CABINET
CI	CAST IRON
CLG	CEILING
CLKG	CAULKING
CLO	CLOSET
CLR	CLEAR
CNTR	COUNTER
COL	COLUMN
CONC	CONCRETE
CONN	CONNECTION
CONT	CONTINUOUS
CONTR	CONTRACTOR
CORR	CORRIDOR
CPT	CARPET
CSMT	CASEMENT
CTR	CENTER
CTSK	COUNTERSINK
D	DEPTH
DEPT	DEPARTMENT
DF	DOUGLAS FIR/DRINKING FOUNTAIN
DH	DOUBLE HUNG
DS	DOWNSPOUT
DBL	DOUBLE
DEMO	DEMOLITION, DEMOLISH
DTL	DETAIL
DIA	DIAMETER
DIM	DIMENSION
DISP	DISPOSAL
DN	DOWN
DR	DOOR
DWR	DRAWER
DWG	DRAWING
E	EAST
(E)	EXISTING
EA	EACH
EJ	EXPANSION JOINT
ELEC	ELECTRICAL
ELEV	ELEVATOR/ELEVATION
EP	ELECTRICAL PANEL
EQ	EQUAL
EQUIP	EQUIPMENT
EWC	ELECTRIC WATER COOLER
EXH	EXHAUST
EXP	EXPANSION
EXT	EXTERIOR
FA	FIRE ALARM
FD	FLOOR DRAIN
FDN	FOUNDATION
FE	FIRE EXTINGUISHER
FEC	FIRE EXTINGUISHER CABINET
FHC	FIRE HOSE CABINET
FOC	FACE OF CONCRETE
FOF	FACE OF FINISH
FOS	FACE OF STUD
FIN	FINISH
FIN FLR	FINISHED FLOOR
FIXT	FIXTURE
FLR	FLOOR
FLUOR	FLUORESCENT
FR	FIRE RESISTANT/RETARDANT
FT	FOOT OR FEET
FTG	FOOTING
FURN	FURNITURE
FX	FIXED
GB	GRAB BAR
GC	GENERAL CONTRACTOR
GFI	GROUND FAULT INTERRUPT
GI	GALVANIZED IRON
GLAM	GLUE LAMINATED
GA	GAUGE
GALV	GALVANIZED
GL	GLASS, GLAZING
GR	GRADE
GSM	GALVANIZED SHEET METAL
GWB	GYPSUM WALLBOARD
GYP	GYPSUM
H	HIGH
HB	HB
HC	HOLLOW CORE
HM	HOLLOW METAL
	HEATING VENTILATING & AIR
HVAC	CONDITIONING
HD	HEAD
HDR	HEADER
HDWD	HARDWOOD
HDW	HARDWARE
HORIZ	HORIZONTAL
HR	HOUR
HT	HEIGHT
ID	INSIDE DIAMETER
IF	INSIDE FACE
INC	INCANDESCENT
INSUL	INSULATION
INT	INTERIOR
JST	JOIST
JAN	JANITOR
J BOX	JUNCTION BOX
JT	JOINT
LAM	LAMINATE
LAV	LAVATORY
LB	LAG BOLT
LF	LINEAR FEET
LKR	LOCKER
LT	LIGHT
MAS	MASONRY
MATL	MATERIAL
MAX	MAXIMUM
MB	MACHINE BOLT
MECH	MECHANICAL
MFR	MANUFACTURER
MH	MANHOLE
MIN	MINIMUM
MISC	MISCELLANEOUS
MTD	MOUNTED
MTL	METAL
MUL	MULLION
N	NORTH
(N)	NEW
NA	NOT APPLICABLE
NIC	NOT IN CONTRACT
NTS	NOT TO SCALE
NO	NUMBER
NOM	NOMINAL
OA	OVERALL
OC	ON CENTER
OD	OUTSIDE DIAMETER/ OVERFLOW DRAIN
OF	OUTSIDE FACE
OFCI	OWNER FURNISH- CONTRACTOR INSTALL
OFF	OFFICE
OP	OPERABLE
OPP HD	OPPOSITE HAND
OPNG	OPENING
OPP	OPPOSITE
PT	PRESSURE TREATED
PVC	POLYVINYLCHLORIDE
PARTN	PARTITION
PL	PLATE
P LAM	PLASTIC LAMINATE
PLAS	PLASTIC
PLY	PLYWOOD
PR	PAIR
PROJ	PROJECT/PROJECTOR
PT	POINT/PRESSURE TREATED
PTD	PAINTED
QTY	QUANTITY
R	RISER
RAD	RADIUS
RD	ROOF DRAIN
REF	REFERENCE
REFR	REFRIGERATOR
REINF	REINFORCING
REG	REGISTER
REQD	REQUIRED
RES	RESILIENT
RO	ROUGH OPENING
REV	REVISION
RM	ROOM
RWL	RAIN WATER LEADER
S	SOUTH
SC	SOLID CORE
SCHED	SCHEDULE
SE	STRUCTURAL ENGINEER
SED	SEE ELECTRICAL DRAWINGS
SF	SUPPLY FAN
SMD	SEE MECHANICAL DRAWINGS
SOG	SLAB ON GRADE
SS	STAINLESS STEEL
SSD	SEE STRUCTURAL DRAWINGS
STD	STANDARD
SEC	SECTION
SH	SINGLE HUNG
SHT	SHEET
SHTG	SHEATHING
SIM	SIMILAR
SLD	SEE LANDSCAPE DRAWINGS
SP	STONE PANEL
SPEC	SPECIFICATION
SQ	SQUARE
SSK	SERVICE SINK
STL	STEEL
STRL	STRUCTURAL
STOR	STORAGE
SUSP	SUSPENDED
SYS	SYSTEM
T	TREAD
TEL	TELEPHONE
TEMP	TEMPERED
T&G	TONGUE & GROOVE
THRESH	THRESHOLD
THK	THICK(NESS)
TJI	TRUSS JOIST
TOC	TOP OF PAVING
TOP	TOP OF CONCRETE/CURB
TOS	TOP OF STEEL
TOW	TOP OF WALL
TS	TUBE STEEL
TYP	TYPICAL
UON	UNLESS OTHERWISE NOTED
UR	URINAL
VCT	VINYL COMPOSITION TILE
VIF	VERIFY IN FIELD
VENT	VENTILATION
VERT	VERTICAL
VEST	VESTIBULE
W	WEST, WIDTH
W/	WITH
W/O	WITHOUT
WC	WATER CLOSET
WD	WOOD
WDO	WINDOW
WH	WATER HEATER
WR	WATER RESISTANT
WT	WEIGHT

ARCHITECT'S STATEMENT

With the exception of the General (G Series) and Architectural (A Series) these drawings and/or specifications and/or calculations for the items listed above have been prepared by other design professionals or consultants who are licensed and/or authorized to prepare such drawings in this state. These documents have been examined by me for design intent and appear to meet the appropriate requirements of Title 24, California Code of Regulations and the project specifications prepared by me.

The items listed above have been coordinated with my plans and specifications and are acceptable for incorporation into the construction of this project for which I am the individual designated to be in general responsible charge.

The accepted drawings are listed above.

Christopher Noll, Principal — Date
NOLL & TAM Architects

CA License No C15916 — Expiration Date: 12/31/11

INDEX OF DRAWINGS

GENERAL

G0.00 COVER SHEET
G0.01 INDEX OF DRAWINGS, GENERAL NOTES, SYMBOLS, ABBREVIATIONS
G0.02 CODE SUMMARY
G0.03 CAMPUS PLAN (FOR REFERENCE ONLY)

CIVIL

C1.01 SITE WORK KEY MAP
C1.02 DETAILED EXISTING CONDITIONS
C2.01 ELECTRICAL ROUTING PLAN
C2.02 DATA, FIRE ALARM, AND COMMUNICATIONS ROUTING PLAN
C2.03 ENLARGED UTILITY PLAN
C3.01 HORIZONTAL PLAN POWER HOUSE
C3.02 HORIZONTAL PLAN BUILDINGS 16 AND 3
C4.01 GRADING AND DRAINAGE PLAN BUILDING 30
C5.01 CONSTRUCTION DETAILS

ARCHITECTURAL

A0.01 OVERALL SITE PLAN
A0.01F OVERALL SITE PLAN WITH LOCAL FIRE AUTHORITY APPROVAL (FOR REFERENCE ONLY)
A2.11 BLDG 30 – PLANS, SCHEDULE
A2.21 BLDG 3 LOAD CENTER #1 – PLAN
A2.31 BLDG 16 LOAD CENTER #2 – PLANS, SCHEDULE
A2.41 BLDG 13 – PLAN
A3.11 BLDG 30 – SECTION, EXTERIOR ELEVATIONS
A3.21 BLDG 16 – SECTIONS, EXTERIOR ELEVATION
A7.11 BLDG 30 – EXT DETAILS
A7.12 EXT DETAILS
A7.13 BLDG 16 – EXT DETAILS

STRUCTURAL

S0.1 GENERAL SPECIFICATIONS
S2.1 POWER HOUSE FOUNDATION AND ROOF FRAMING PLAN
S2.2 BLDG 16 LOAD CENTER #2 FOUNDATION AND ROOF FRAMING PLAN
S3.1 BLDG 30 ELEVATIONS
S3.2 BLDG 16 LOAD CENTER #2 ELEVATION AND SECTION
S5.1 TYPICAL CONCRETE DETAILS
S5.2 CONCRETE DETAILS
S5.3 DETAILS
S7.1 TYPICAL METAL DECK DETAILS
S7.2 DETAILS

MECHANICAL

M0.1 MECHANICAL LEGEND AND NOTES
M1.1 MECHANICAL PARTIAL FLOOR PLANS – BLDG 16

PLUMBING

P0.1 PLUMBING LEGEND AND NOTES
P1.1 PLUMBING PARTIAL FLOOR PLANS – BLDG 3

ELECTRICAL/TELECOM

E1.1 ELECTRICAL GENERAL
E2.1 ELECTRICAL DETAILS
E3.1 ELECTRICAL DETAILS

SECURITY

SY0.01 SYMBOLS LIST AND DRAWING INDEX
SY0.11 BLOCK DIAGRAM ACAMS + VSS
SY2.01 FLOOR PLAN BUILDING 30
SY5.01 INSTALLATION DETAILS

FIRE ALARM

FA-01 COVER/DRAWING INDEX/EQUIPMENT LIST
FA-02 MISCELLANEOUS DETAILS
FA-03 FIRE ALARM PANEL MXLR
FA-04 TYPICAL WIRING OF DEVICES
FA-05 FIRE ALARM RISER BUILDING 30
FA-06 FIRE ALARM PLAN BUILDING 30

noll & tam
architects and planners
729 Heinz Avenue
Berkeley, CA 94710
510.649.8295
fax 510.649.3008

IDENTIFICATION STAMP
DIVISION OF THE STATE ARCHITECT
APPLICATION NUMBER 01- 111618
AC _____ FLS _____ SS _____
DATE

CALIFORNIA STATE FIRE MARSHAL APPROVED
APPROVAL OF THIS PLAN DOES NOT AUTHORIZE OR APPROVE ANY OMISSION OR DEVIATION FROM APPLICABLE REGULATIONS. FINAL APPROVAL IS SUBJECT TO FIELD INSPECTION. ONE SET OF APPROVED PLANS SHALL BE AVAILABLE ON THE PROJECT SITE AT ALL TIMES.
REVIEWED BY: _____ DATE:

CAÑADA COLLEGE

Electrical Infrastructure Replacement Project

4200 Farm Hill Blvd
Redwood City, CA 94061

LICENSED ARCHITECT
CHRISTOPHER NOLL
REN. 12/31/11
C15916
STATE OF CALIFORNIA

RECORD DRAWING

SHEET TITLE
Index of Dwgs, Gen Notes, Symbols, Abbreviations

REVISIONS

NO.	DATE	DESCRIPTION

DATE	July 9, 2012
DRAWN	TC/AL
CHECKED	MM
SCALE	NA
JOB NO.	2921.01

SHEET NUMBER
G0.01