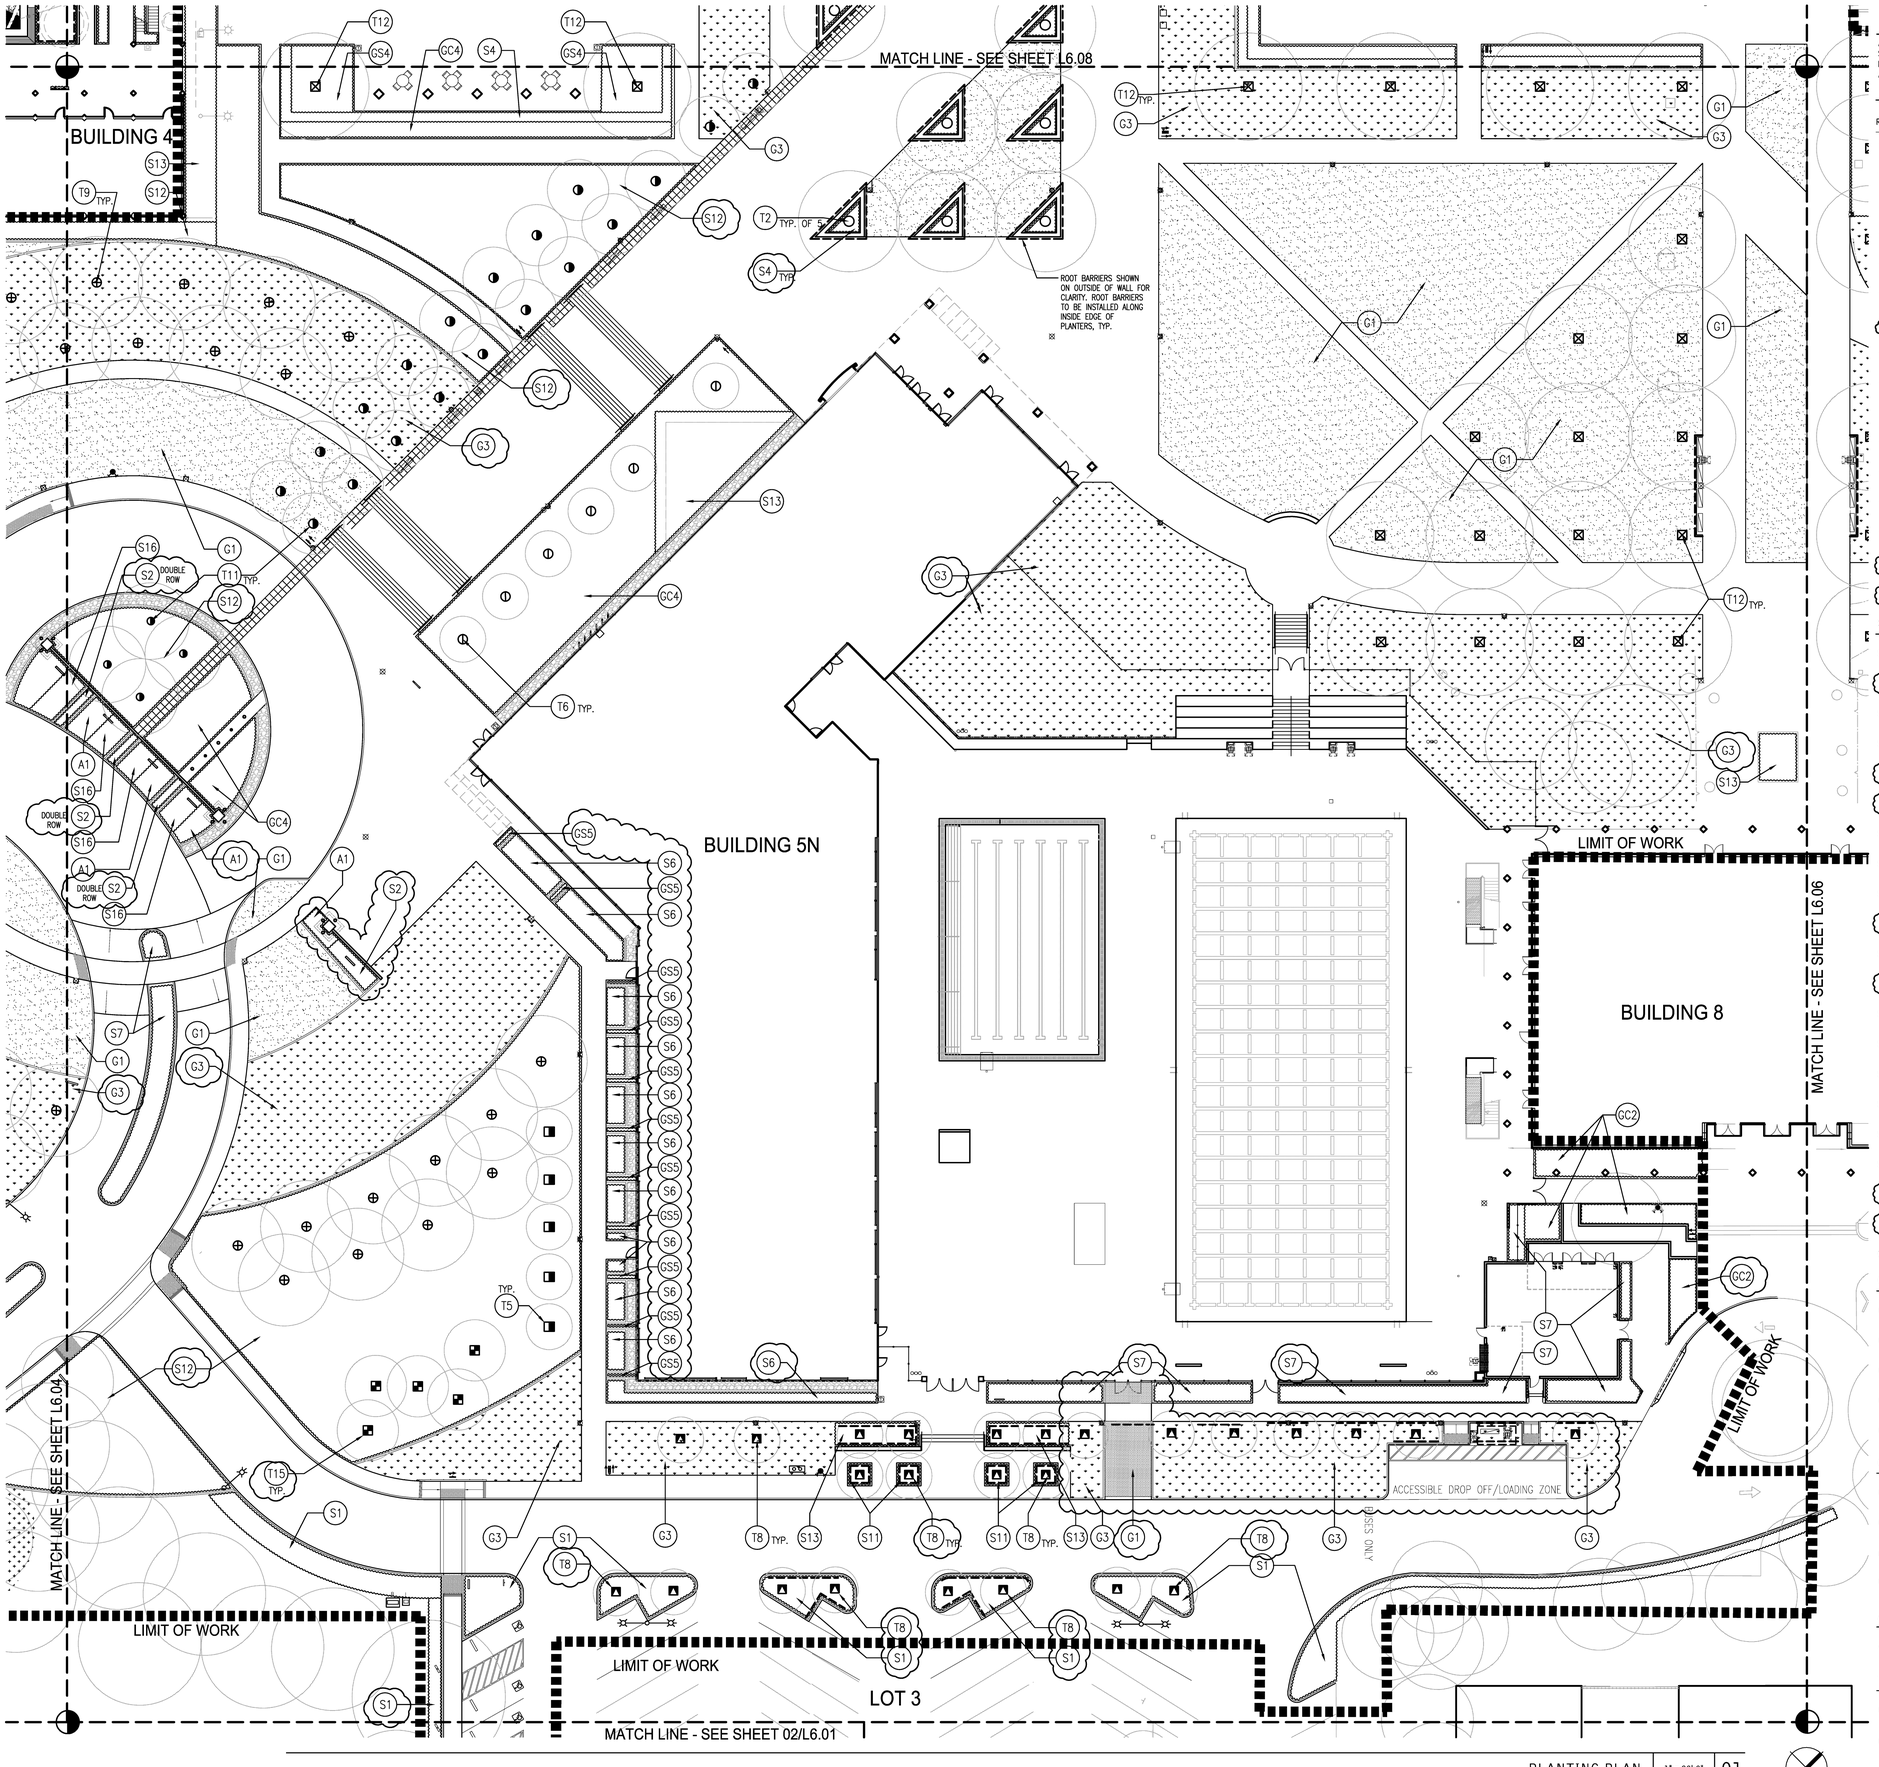

PLANTING LEGEND

ALL PLANTS NOTED IN THE APPROVED COLUMN (A) ARE FROM THE APPROVED PLANT LISTS IN THE DESIGN STANDARDS FOR CAMPUS EXTERIOR DESIGN (VERSION 1, 2007.09.03) & PLANTS NOTED WITH A (B) INDICATE PLANTS HAVE BEEN APPROVED BY CSM ON MEETINGS DATED 10/29/08 & 12/09/08 & (C) INDICATE PLANTS HAVE BEEN APPROVED BY CSM ON 09/23/09.

TREE LIST

(**)– PLANTED IN POTS, SEE 13/L6.20 (NCN.)– NO COMMON NAME

REF.	SYMBOL	QNTY.	BOTANICAL NAME / COMMON NAME	SIZE/TRUNK SPACING	WATER USE	APPROVED	WIDTH/ HEIGHT
T1		–	ACER PALMATUM 'BLOODGOOD' / BLOODGOOD MAPLE	24" BOX/ MULTI AS SHOWN	M	A	20'/15'
T2		5	ACER RUBRUM 'RED SUNSET' / RED SUNSET MAPLE	24" BOX/ AS SHOWN	M	A	20'/40'
T3		–	CALOCEDRUS DECURRENS / CALIFORNIA INCENSE CEDAR	24" BOX/ AS SHOWN	M	B	15'/50'
T4		–	PRUNUS YEDOENSIS 'AKEBONO' / FLOWERING CHERRY	36" BOX/ AS SHOWN	M	A	15'/25'
T5		5	CERCIS CANADENSIS / EASTERN REDBUD	24" BOX/ STD. AS SHOWN	M	A	25'/25'
T6		6	CERCIS CANADENSIS / EASTERN REDBUD (MULTI–TRUNK)	24" BOX/ MULTI AS SHOWN	M	A	25'/25'
(T7)		–	METASEQUOIA GLYPTOSTROBOIDES / DAWN REDWOOD	24" BOX/ AS SHOWN	L	C	20/80'
T8		25	LAGERSTROIEMIA INDICA 'NATCHEZ' / CRAPE MYRTLE	24" BOX/ AS SHOWN	L	A	12'/25'
T9		17	PINUS PINEA / ITALIAN STONE PINE	24" BOX/ AS SHOWN	L	A	40'/60'
T10		–	GINKGO BILOBA 'SARATOGA' / MAIDENHAIR TREE	24" BOX/ AS SHOWN	M	B	30'/40'
T11		23	PYRUS CALLERYANA 'ARISTOCRAT' / ORNAMENTAL PEAR	24" BOX/ AS SHOWN	M	A	20'/35'
T12		18	ZELKOVA SERRATA / SAWLEAF ZELKOVA	24" BOX/ AS SHOWN	M	A	50'/50'
T13		–	CUPRESSUS SEMPERVIRENS ** / ITALIAN CYPRESS	24" BOX/ AS SHOWN	L	A	8'/60'
T14		–	MAGNOLIA SOULANGEANA / SAUCER MAGNOLIA	24" BOX/ AS SHOWN	M	B	25'/20'
T15		5	SEQUOIA SEMPERVIRENS / COAST REDWOOD	36" BOX/ AS SHOWN	M	C	20'/70'
T16		–	QUERCUS AGRIFOLIA / COAST LIVE OAK	24" BOX/ AS SHOWN	M		30/50'

SHRUB / VINE LIST

REF.	SYMBOL	QNTY.	BOTANICAL NAME / COMMON NAME	SIZE/TRUNK SPACING	WATER USE	APPROVED	WIDTH/ HEIGHT
S1		–	ARCTOSTAPHYLOS 'HOWARD MCMINN' / MANZANITA	5 GAL./ 4' O.C.	VL	A	7'/ 5'–6'
S2		–	ANIGOZANTHOS HYBRID 'BUSH SUNSET' / KANGAROO PAW	1 GAL./ 2' O.C.	M	C	3'/ 3'
S3		–	BOUGAINVILLEA 'LA JOLLA' ** / BOUGAINVILLEA	1 GAL./ AS SHOWN	L	B	5'/ 16'
S4		–	BUXUS MICROPHYLLA JAPONICA 'GREEN BEAUTY' / JAPANESE BOXWOOD	5 GAL./ 30" O.C.	M	B	4'/ 6'
(S5)		–	BERGENIA CRASSIFOLIA / WINTER BLOOMING BERGENIA	1 GAL./ 2' O.C.	M	C	3–5'/ 3–5'
(S6)		–	COLEONEMA PULCHELLUM 'AUREA' / BREATH OF HEAVEN	1 GAL./ 4' O.C.	M	C	5'/ 3'
S7		–	DIETES IRIDIOIDES / FORTNIGHT LILY	1 GAL./ 2' O.C.	L	A	3'/ 3'
S8		–	SALVIA LEUCANTHA / MEXICAN BUSH SAGE	1 GAL./ 30" O.C.	M	A	4'/ 3'
S9		–	ESCALLONIA 'JUBILEE' / ESCALLONIA	5 GAL./ 3' O.C.	M	B	6'/ 6'
(S10)		–	LANTANA HYBRID 'RADIATION' / NCN	1 GAL./ 3' O.C.	M	C	3–5'/ 3–5'
S11		–	LIMONIUM PEREZII / STATICE	1 GAL./ 18" O.C.	L	B	2'/ 2'
(S12)		–	NERIUM OLEANDER 'LITTLE RED' / LITTLE RED OLEANDER	1 GAL./ 4' O.C.	M	C	5'/ 3'
S13		–	PHORMIUM TENAX 'YELLOW WAVE' / YELLOW WAVE FLAX	5 GAL./ 3' O.C.	L	B	3'/ 4'
S14		–	RHODODENDRON 'ANNA ROSE WHITNEY' / RHODODENDRON	5 GAL./ 5' O.C.	M	A	6'/ 6'
S15		–	RHODODENDRON 'FIELDERS' WHITE' / SOUTHERN INDICA HYBRID AZALEA	5 GAL./ 4' O.C.	M	A	6'/ 6'
S16		–	PELARGONIUM X HORTORUM / GERANIUM	1 GAL./ 2' O.C.	L	B	2'/ 2'
S17		–	PLUMBAGO AURICULATA / CAPE PLUMBAGO	5 GAL./ 4' O.C.	L	B	6'/ 8'–10'
S18		–	NERIUM OLEANDER 'PETITE PINK' / OLEANDER	5 GAL./ 2' O.C.	L	B	3'–6'/ 3'–6'
(S19)		–	PODOCARPUS M. 'MAKI' / FERN PINE	15 GAL./ 3' O.C.	L	C	4'/ 10'
(S20)		–	PHOTINIA FRASERI / NCN	5 GAL./ AS SHOWN	L	C	6'/ 8'
V1		–	FICUS PUMILA / CREEPING FIG	1 GAL./ AS SHOWN	M	B	15'/ 20'

GRASS LIST

REF.	SYMBOL	QNTY.	BOTANICAL NAME / COMMON NAME	SIZE/TRUNK SPACING	WATER USE	APPROVED	WIDTH/ HEIGHT
GS1		–	MISCANTHUS TRANSMORRISONENSIS ** / EVERGREEN MISCANTHUS	5 GAL./ 4' O.C.	H	B	4'/ 5'
GS2			NOT USED				
GS3		–	PENNISETUM ALOPECUROIDES 'LITTLE BUNNY' / LITTLE BUNNY FOUNTAIN GRASS	1 GAL/ 2' O.C.	L	A	1.5'/ 1.5'
GS4		–	PENNISETUM SETACEUM 'EATON CANYON' / EATON CANYON FOUNTAIN GRASS	1 GAL/ 1' O.C.	L	A	2'/ 1.5'
GS5		–	CALAMAGROSTIS X ACUTIFLORA 'KARL FOERSTER' / FEATHER REED GRASS	1 GAL/ 2' O.C.	M	B	3'/ 2'

GROUND COVER LIST

REF.	SYMBOL	QNTY.	BOTANICAL NAME / COMMON NAME	SIZE/TRUNK SPACING	WATER USE	APPROVED	WIDTH/ HEIGHT
GC1		–	CARPOBROTUS CHILENSIS / ICE PLANT	1 GAL/ 18" O.C.	L	B	8"/ 8'
GC2		–	LANTANA MONTEVIDENSIS 'WHITE LIGHTNIN' / NCN	1 GAL/ 4' O.C.	L	B	3'–6'/ 18"
GC3			NOT USED				
GC4		–	TRACHELOSPERMUM JASMINOIDES / STAR JASMINE	1 GAL/ 2' O.C.	M	B	10'/ 2'

ANNUALS LIST

REF.	SYMBOL	QNTY.	BOTANICAL NAME / COMMON NAME	SIZE/TRUNK SPACING	WATER USE	APPROVED	WIDTH/ HEIGHT
A1		–	DIANTHUS CHINENSIS / DIANTHUS	4" POTS AS SHOWN	L		10"/ 30"

TURF LIST

REF.	SYMBOL	QNTY.	BOTANICAL NAME / COMMON NAME	SIZE/TRUNK SPACING	WATER USE	APPROVED	WIDTH/ HEIGHT
G1			TURF GRASS: 90% FESCUE/10% KENTUCKY BLUEGRASS BLEND	HYDROSEED, SOD TURF PAVERS, SEE SPECS	H	B	–/ –
G2			NOT USED				
G3			FESTUCA RUBRA MOLATE / MOLATE FESCUE	SOD SEE SPECS.	L	B	–/ –

PLANTING PLAN | 1" = 20'-0" | 01

McCarthy Building Companies, Inc
343 Sansome Street, 14th Floor
San Francisco, California 94104
P 415 364-1339
F 415 397-5999

REGISTERED LANDSCAPE ARCHITECT
KEVIN MICHAEL SULLIVAN
Signature
NO. 2188
RENEWAL 5-31-10
04-09-09
Date
STATE OF CALIFORNIA

IDENTIFICATION STAMP
DIV. OF THE STATE ARCHITECT
OFFICE OF REGULATION SERVICE
APPL. # 01-110097
AC. ____ FLS ____ SS ____
DATE ____
FILE NUMBER:

This and all other project documents and all ideas, aesthetics and designs incorporated therein are instruments of service. All project documents are the registered property of LPA, INC. and shall not be reproduced in whole or in part for use on any project or purpose except as described in the contractual agreement between McCarthy and the District. LPA hereby gives formal notice that any such project document use, reproduction or modification (misuse) is not only unlawful but automatically binds all parties involved with misuse to fully indemnify and defend LPA and LPA's Consultants to the maximum legal extent against all losses, demands, claims or liabilities resulting from the defendant's misuse of project misuse. Project documents represent the design intent of work and are not a representation of as-built or existing conditions. LPA and LPA's Consultants make no representations concerning the accuracy of documents and are not responsible for any discrepancies between project documents and the existing conditions.

© Copyright 2008

College of San Mateo
Site Package
San Mateo, CA

Developed for
San Mateo County Community College District

Revision	Description	Date

Revision	Description	Date
	DSA SUBMITTAL	19 SEPT 2008
	DSA FINAL	09 APRIL 2009
	BULLETIN 7 (PLANTING REVS.)	DEC 10 2009

Job. No.	27082.30
Date	09 APRIL 2009
Drawn by	AG, RF
Checked by	SM
Scale	AS SHOWN

0 10 20 40

PLANTING PLAN

L6.05

W:\20073\27082\30\CAD\landscape\L-605LP.dwg, 12/10/2009 1:54:19 PM, kangell