

JOHN CARL WARNEKE & ASSOCIATES
ARCHITECTS AND PLANNING CONSULTANTS
61 NEW MONTGOMERY STREET
SAN FRANCISCO

JOHN CARL WARNEKE AND ASSOCIATES
ARCHITECTS AND PLANNING CONSULTANTS
61 NEW MONTGOMERY STREET
SAN FRANCISCO

Design by
 BRADLEY THOMPSON
 JAMES W. HARRIS
 WELLS & GARDNER
 MECH. & ELEC. ENGINEERS
 CARL E. KIRKER
 CIVIL ENGINEER


Approved by
 APPLICANT: COLLEGE OF SAN MATEO
 PROJECT: 1ST & 2ND LEVEL PLANS
 APPROVED: [Signature]
 DATE: 1/16/1967

BUILDING A
 SCIENCE, TECH./VOC.
 MECHANICAL
 1ST & 2ND LEVEL PLANS
COLLEGE OF SAN MATEO
 SAN BRUNO CALIFORNIA

NO.	REVISION DESCRIPTION	DATE APPROVED

SCALE AS SHOWN
 JOB NO. 64-15
 D.B. J.M.
 CHECK BY G.S.K.
 DATE JAN 16, 1967

SHEET NUMBER
M-A3
 OF 4 SHEETS
 REVISION NO.

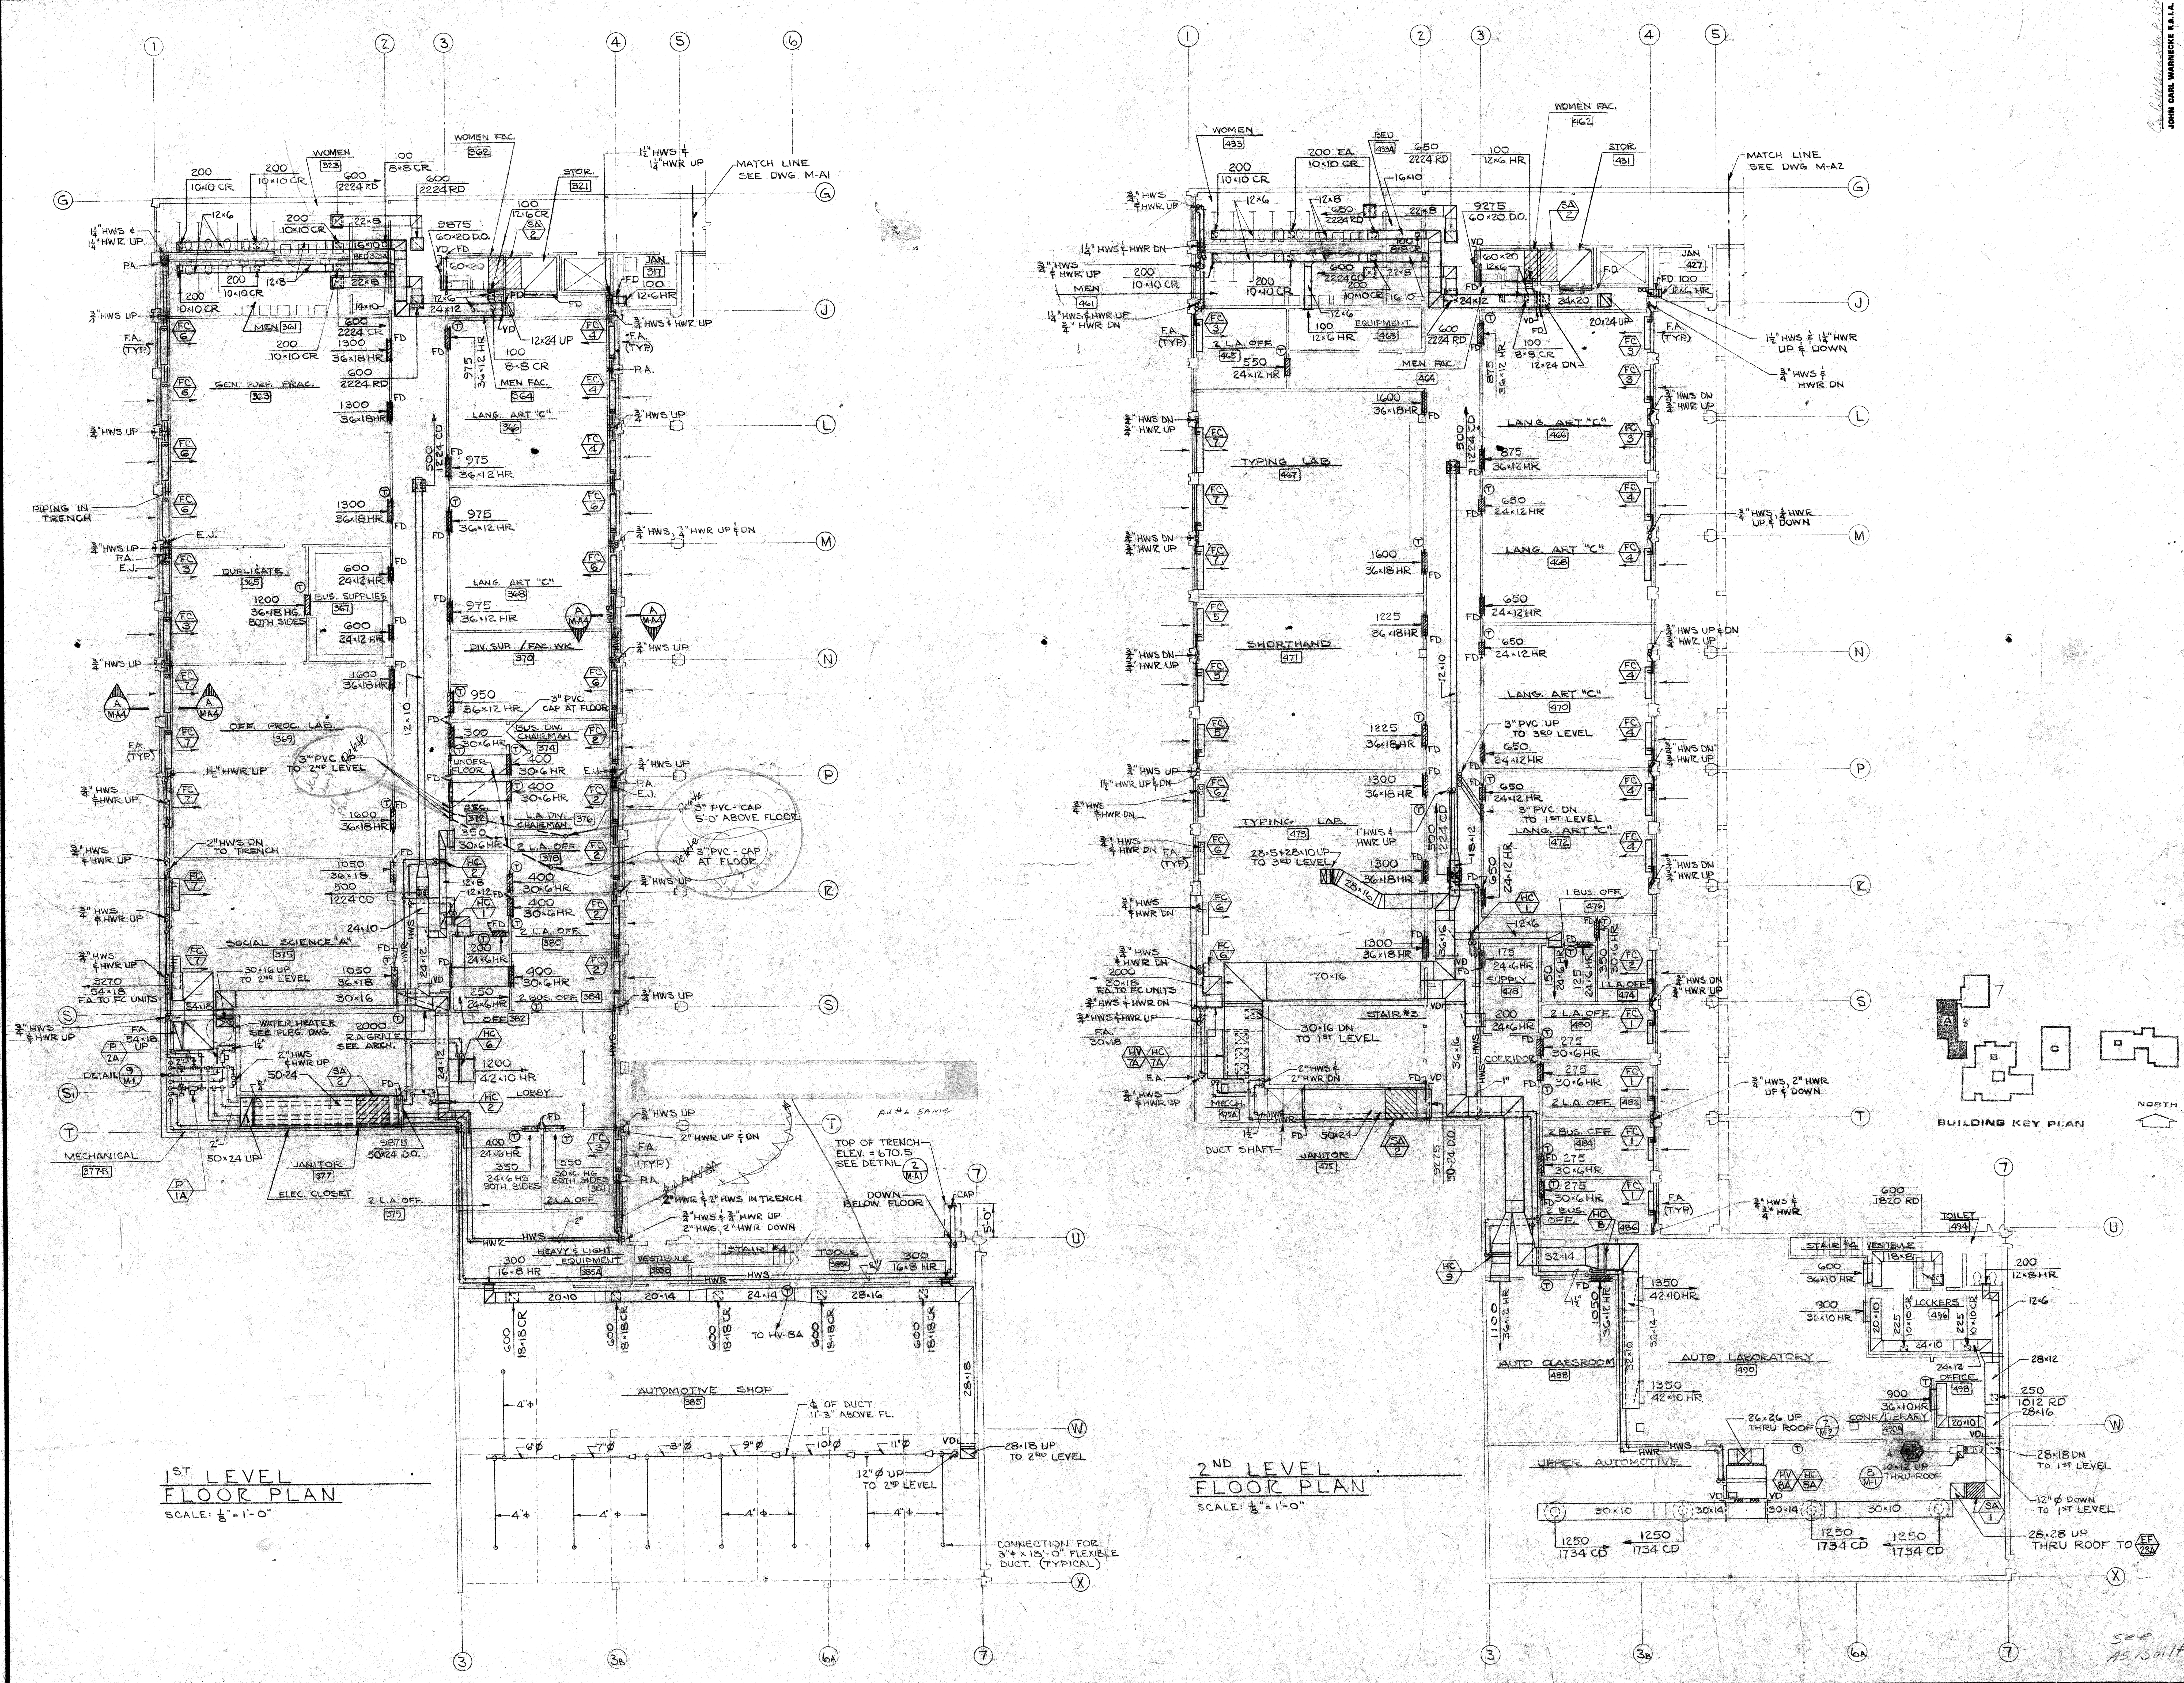

1ST LEVEL FLOOR PLAN
 SCALE: 1/8" = 1'-0"

2ND LEVEL FLOOR PLAN
 SCALE: 1/8" = 1'-0"

BUILDING KEY PLAN

500
 AS 15011