


RFP 50



SK-2

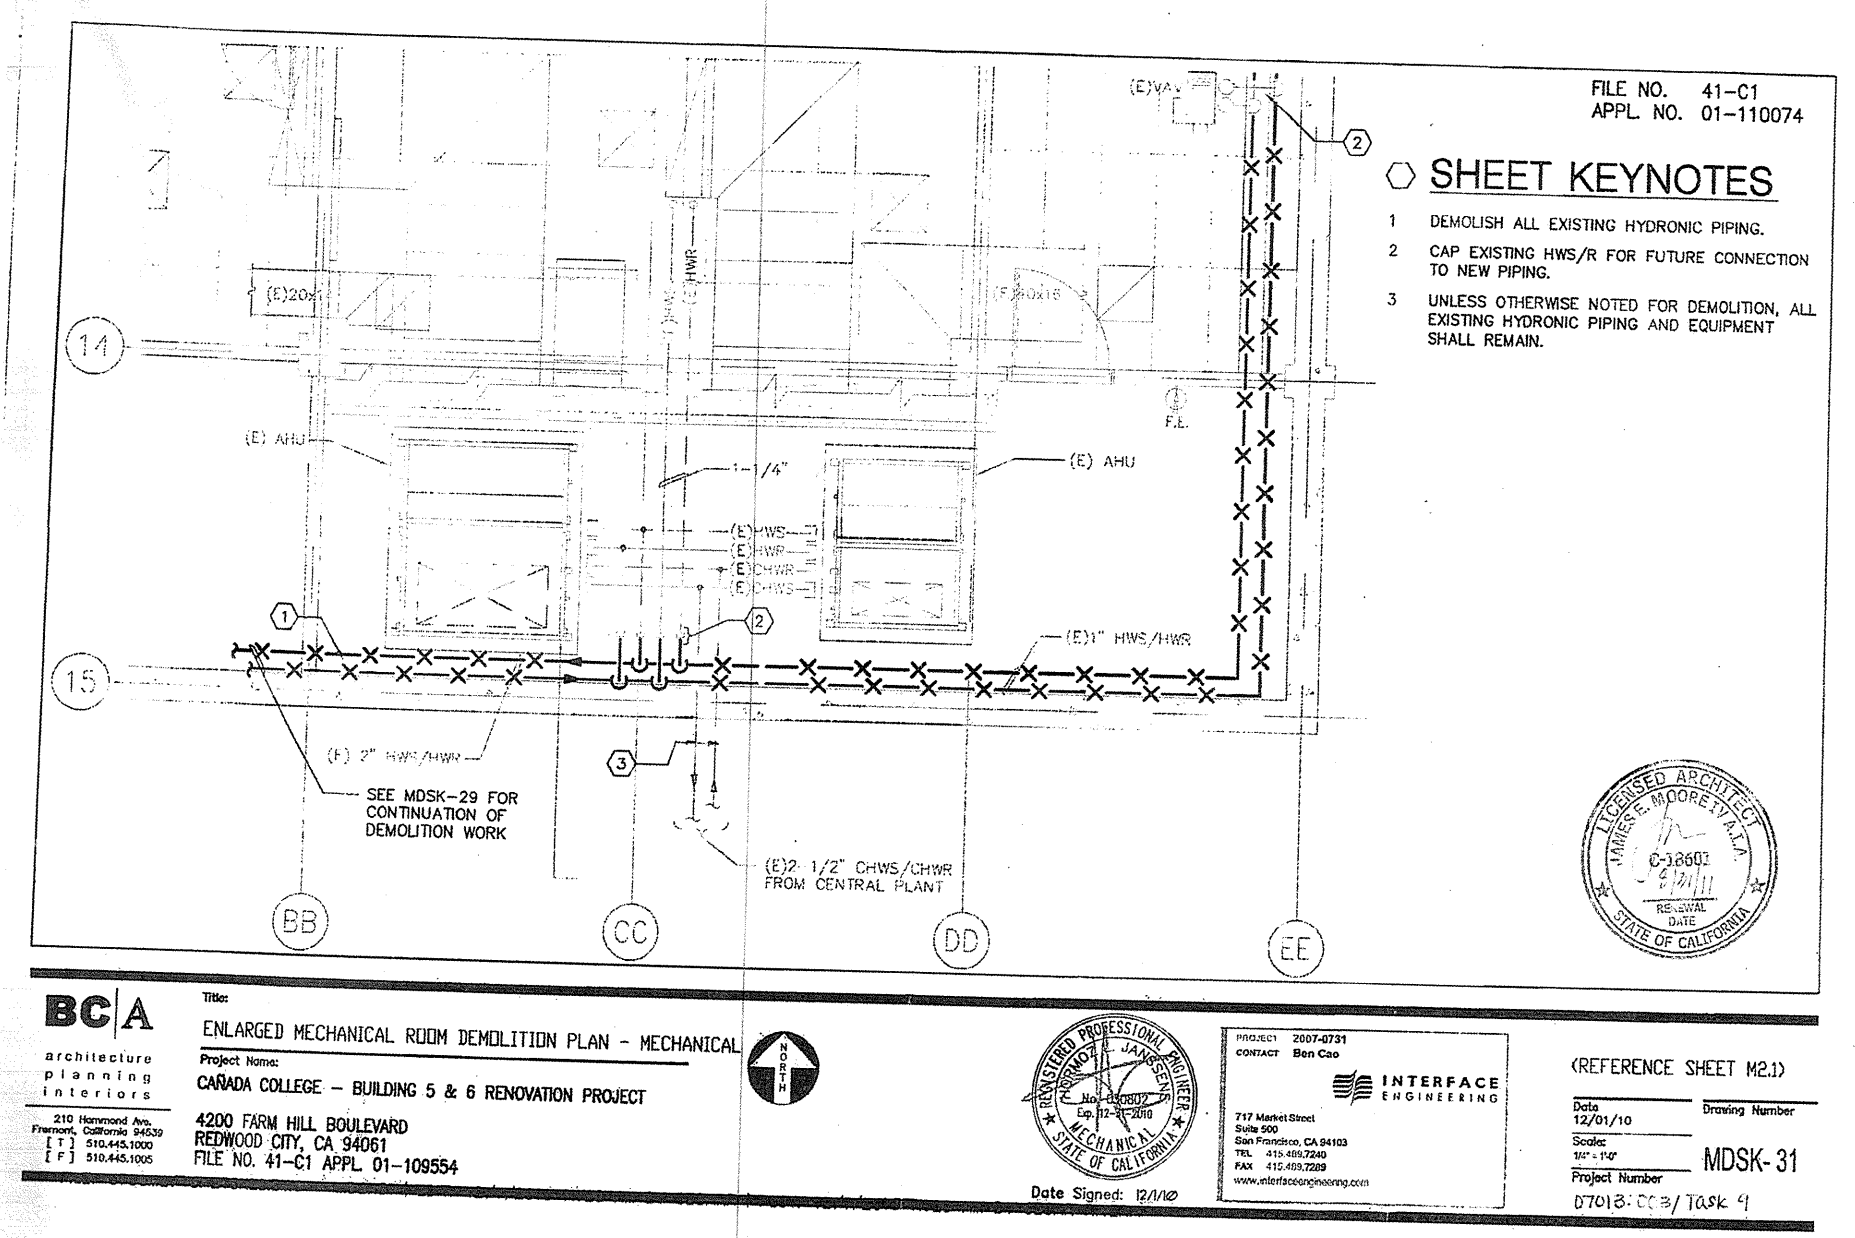