


RFI-073

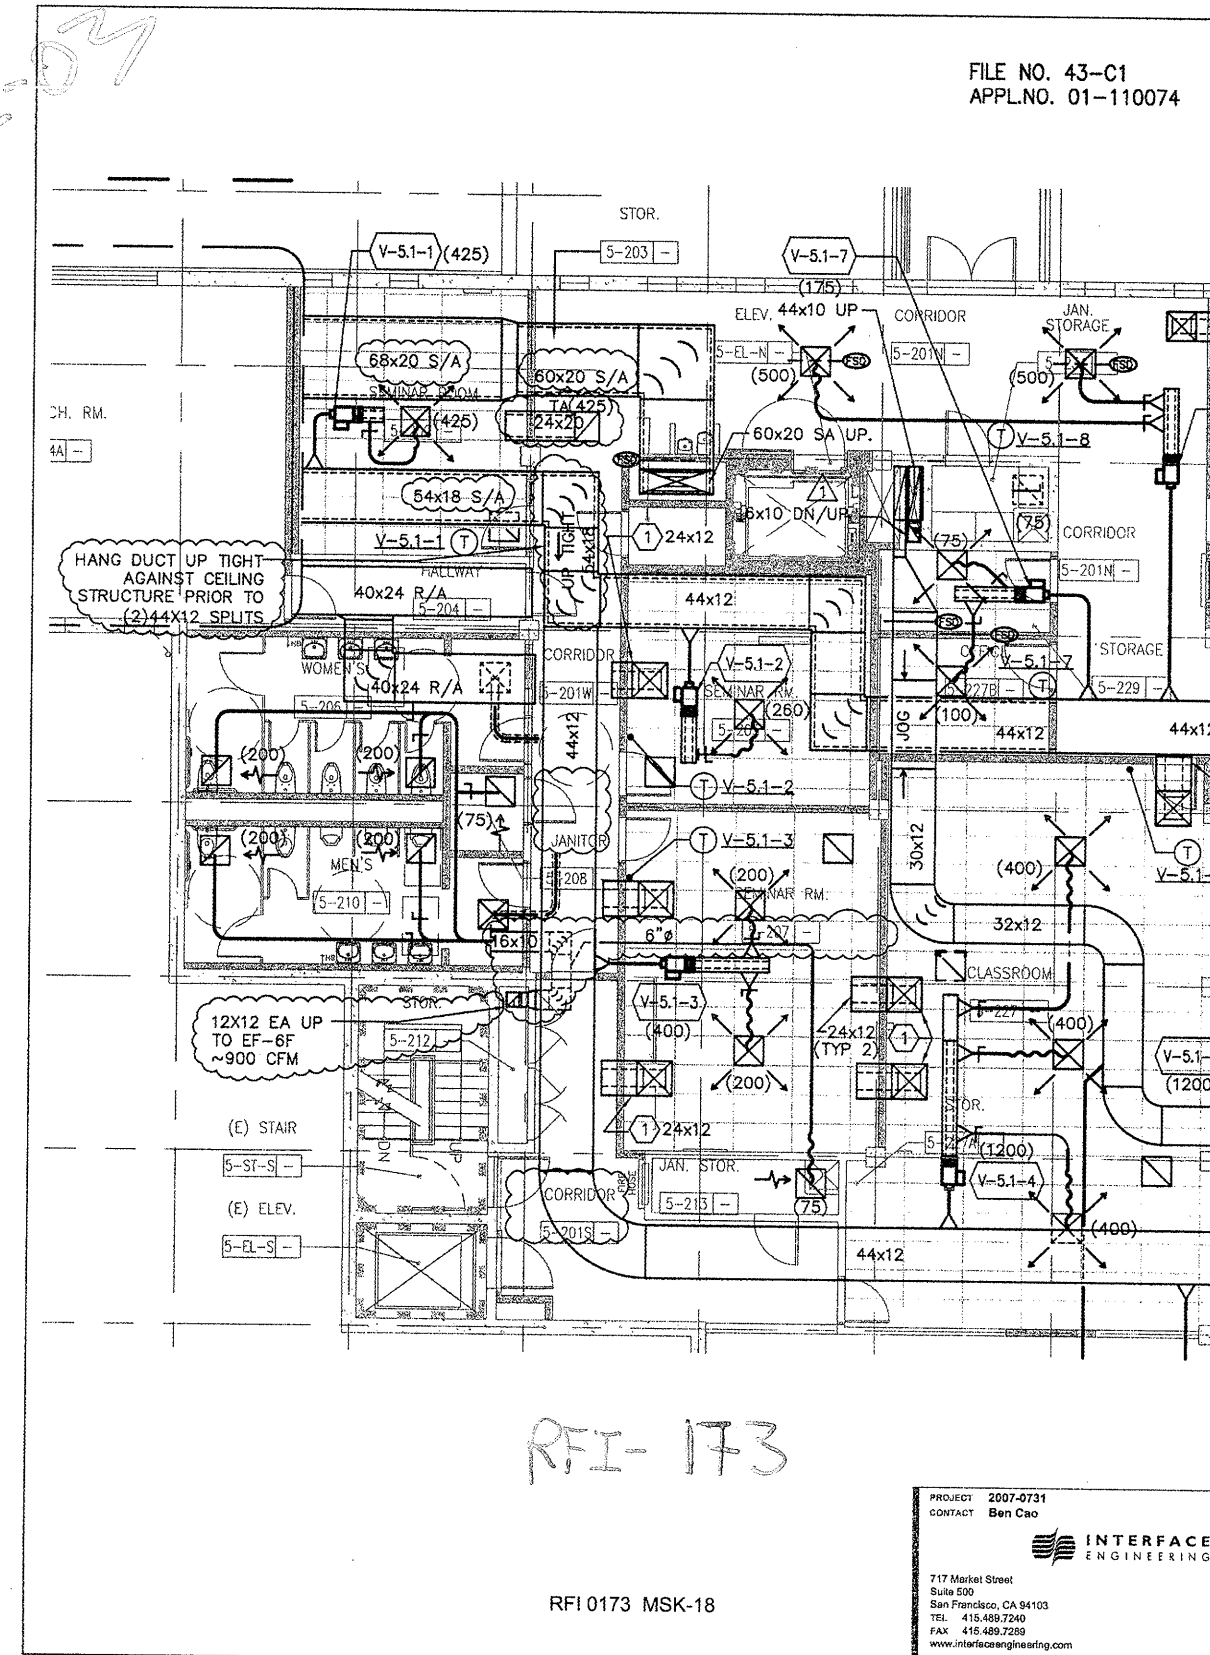


RFI-173

BCA ARCHITECTURE PLANNING INTERIORS
 PROJECT: CANADA COLLEGE - BUILDINGS 5 & 6 RENOVATIONS
 4200 FARM HILL BOULEVARD
 REDWOOD CITY, CA 94061
 FILE NO. 43-C1 APRL 01-110074

INTERFACE ENGINEERING


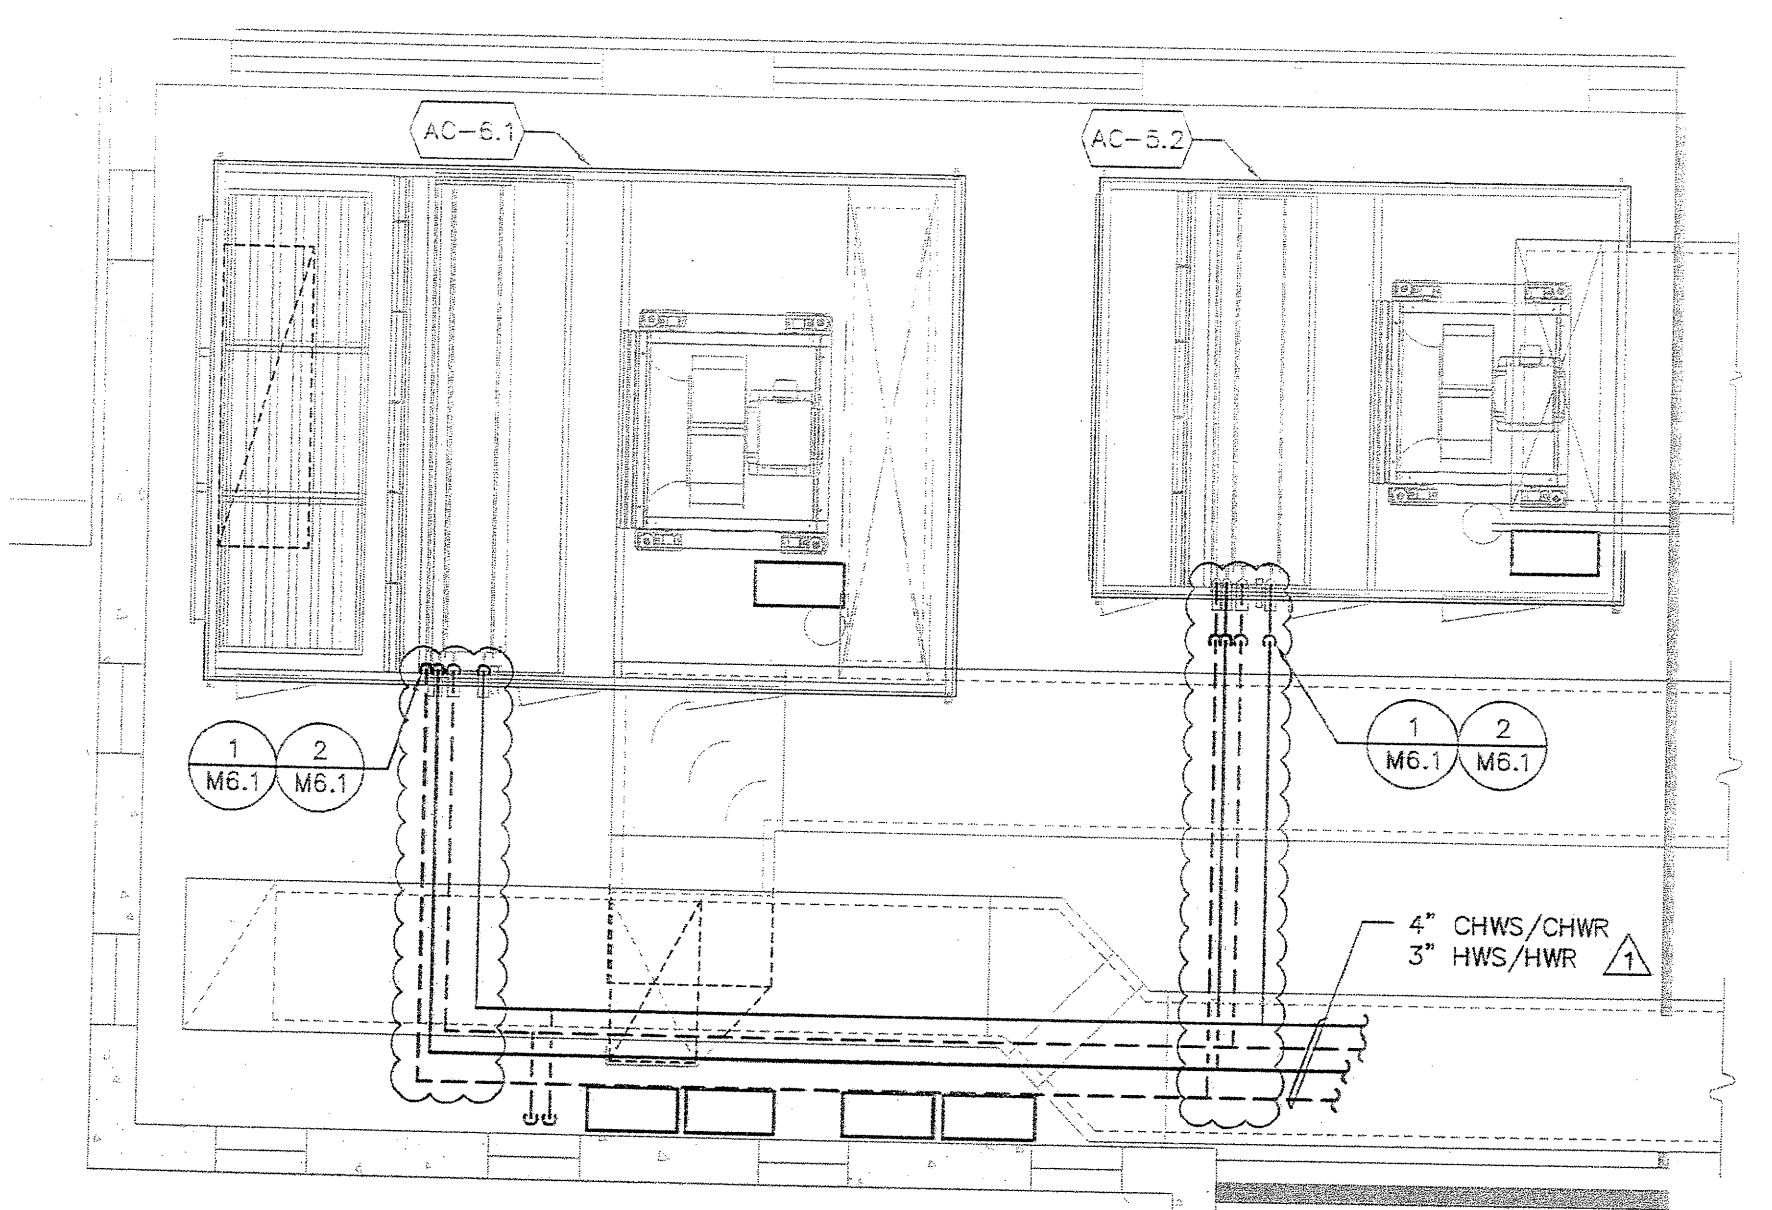

MSK-04

BCA ARCHITECTURE PLANNING INTERIORS
 PROJECT: CANADA COLLEGE - BUILDINGS 5 & 6 RENOVATIONS
 4200 FARM HILL BOULEVARD
 REDWOOD CITY, CA 94061
 FILE NO. 43-C1 APRL 01-110074

MECHANICAL ENGINEER

INTERFACE ENGINEERING

