


**GENERAL SHEET NOTES**

A. FOR VAV PIPING AND VALVE ARRANGEMENT, SEE DETAIL 3 ON SHEET M601.

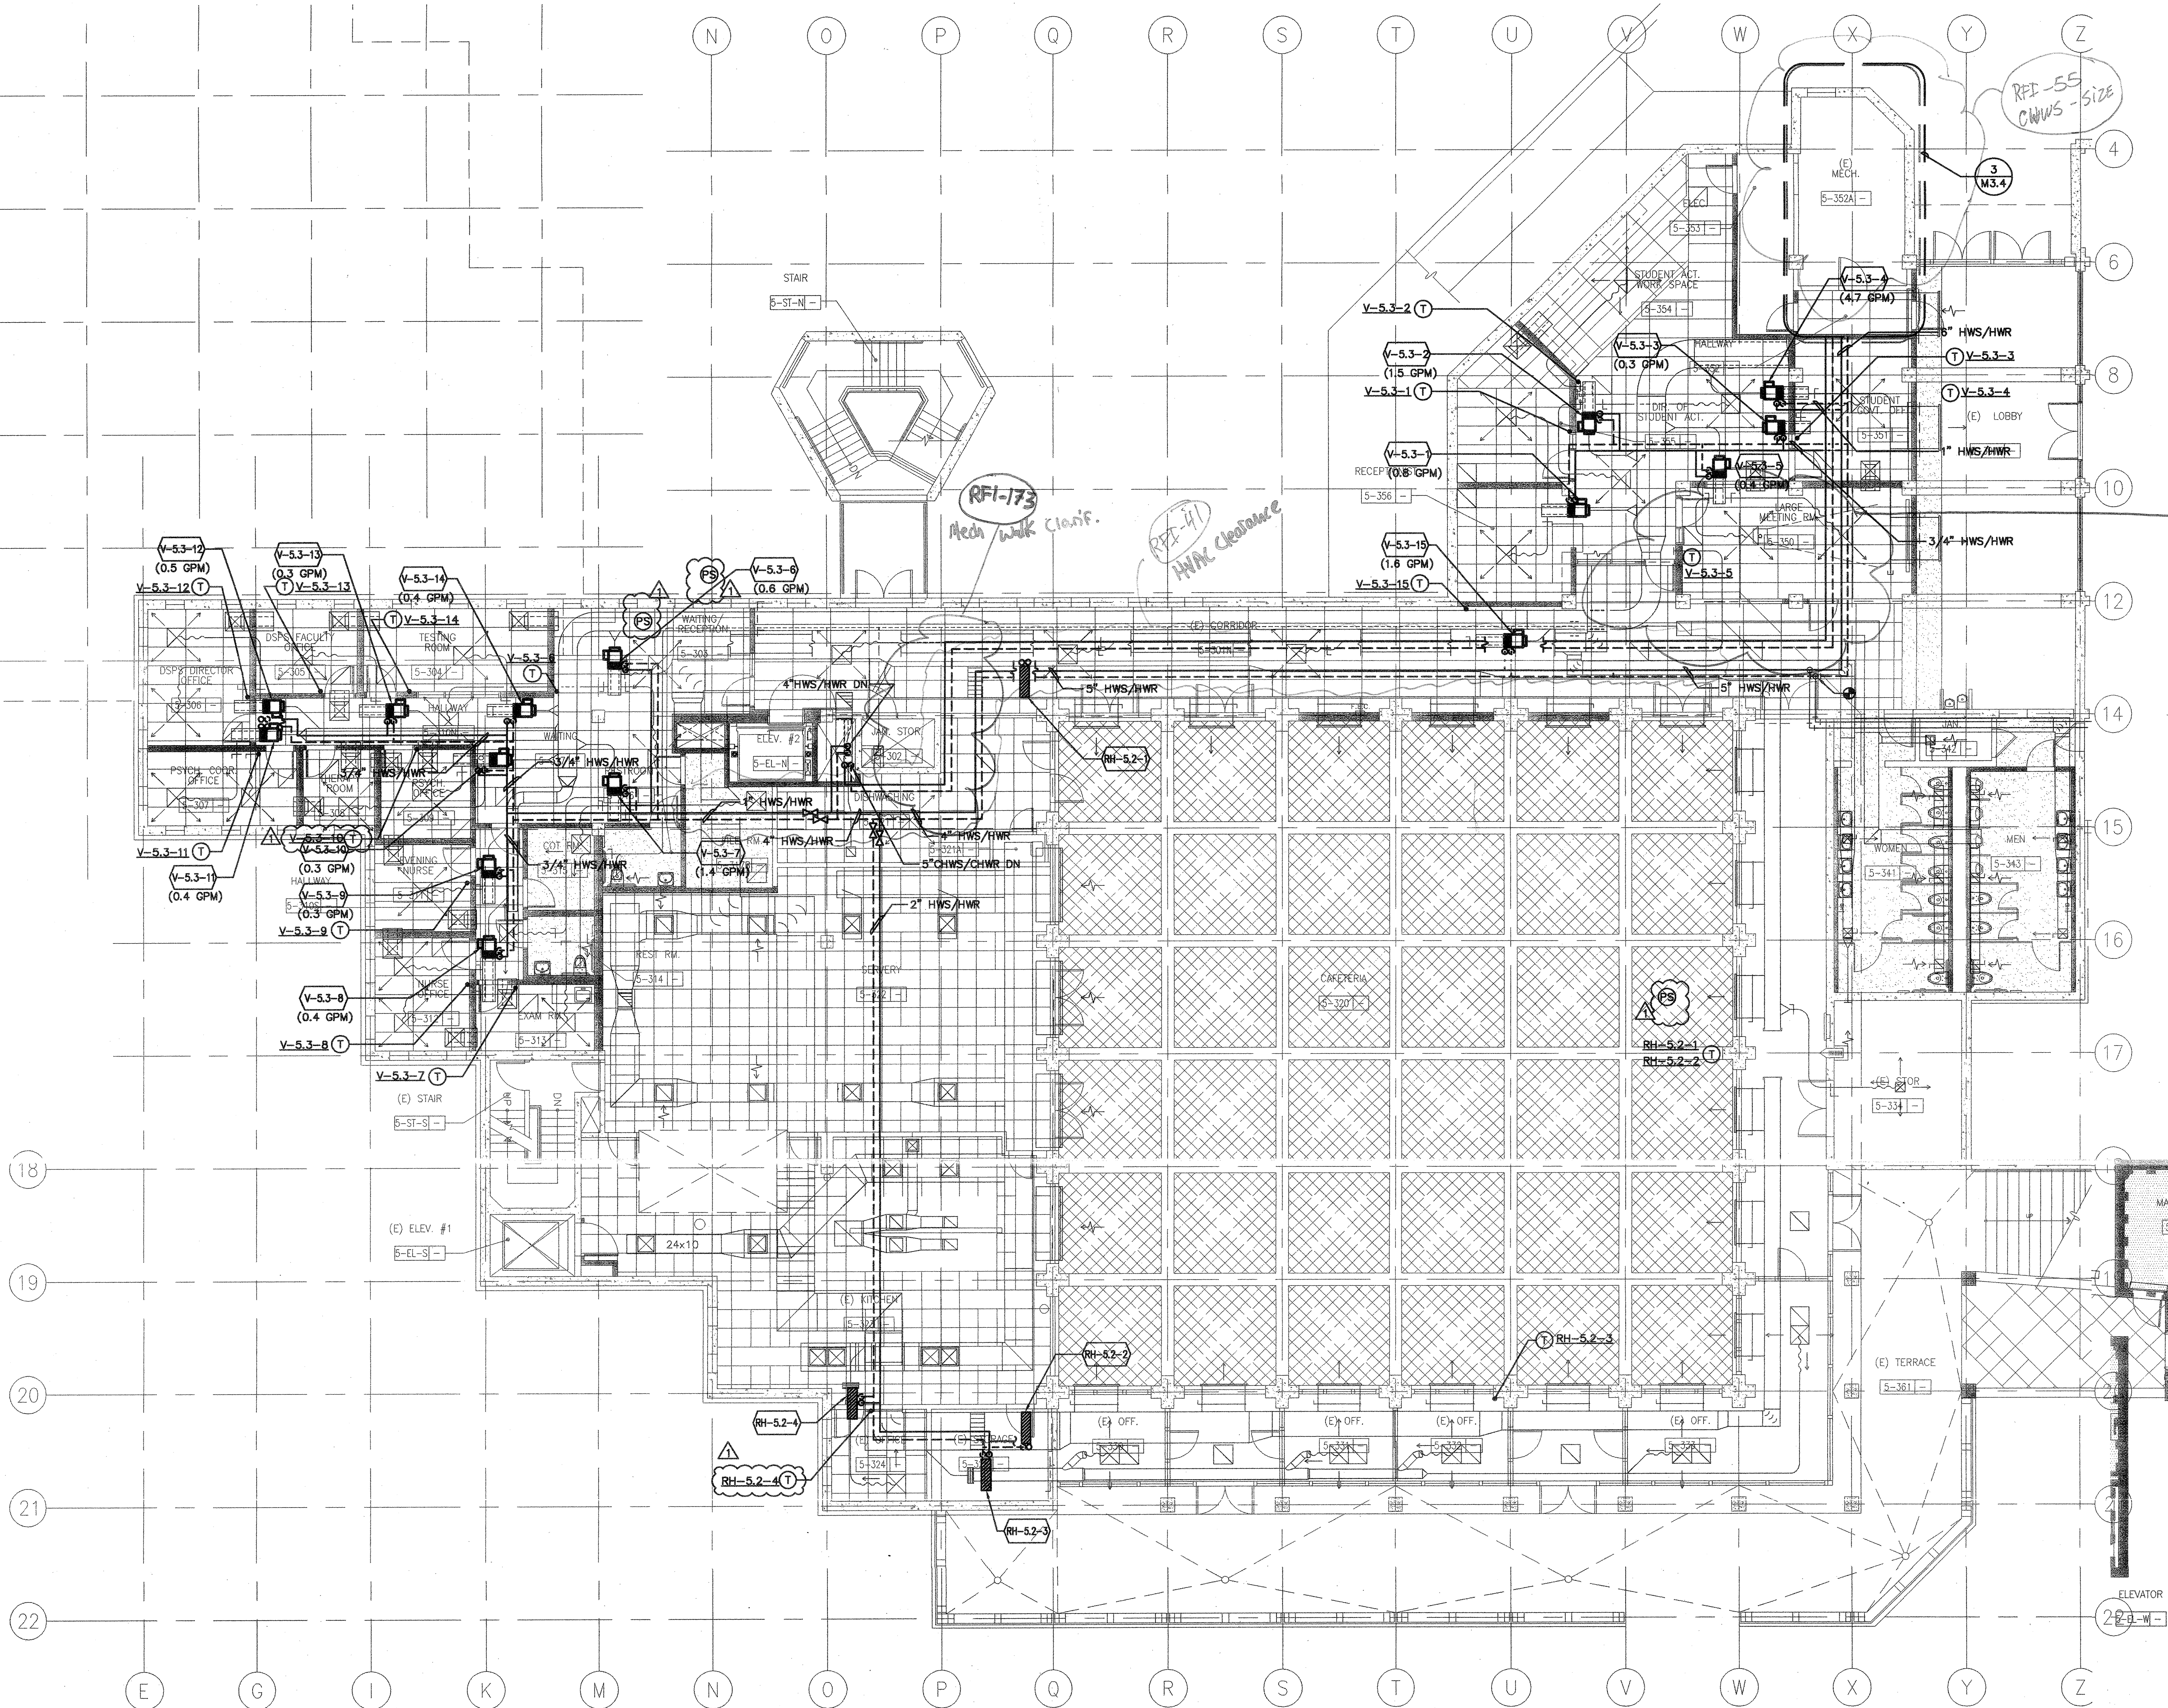

**1 MECHANICAL HYDRONIC PLAN - THIRD FLOOR**  
SCALE: 1/8"=1'-0"

PROJECT 2007-0731  
CONTACT Omar Hawit

**INTERFACE ENGINEERING**  
717 Market Street  
Suite 500  
San Francisco, CA 94103  
TEL: 415.489.7240  
FAX: 415.489.7289  
www.interfaceengineering.com

ARCHITECT: [Stamp]  
ENGINEER: [Stamp]

No. 0018655  
Ren. 09/30/11

- This sheet is part of a set and is not to be used alone.
- This sheet is not to be used for construction unless the architect's stamp and signature appear on the drawings and the status box indicates drawings have been released for construction.
- These plans and prints thereof, as instruments of service, are owned by the architect and are for use on this project only. Reproduction and/or distribution without the prior written consent of the architect is forbidden.
- Copyright Burton Clifford Associates, 2007

REMARKS	DATE
ADDENDUM NO. 1	08/18/09

DRAWING STATUS	DATE
DSAL PLAN CHECK	08/29/08
DSAL BACK CHECK	01/22/09
BIDDING (NO. 000000)	08/18/09
CONSTRUCTION	

FILE NO. 41-C1

IDENTIFICATION STAMP  
DIV. OF THE STATE ARCHITECT

01-110074

AC. PLS. SS. JAC

DATE: 2/17/10

**BUILDINGS 5 & 6 RENOVATIONS**  
San Mateo County Community College District

**BID ADDENDA**

APPROVED  
DIV. OF THE STATE ARCHITECT  
AC 24 PLS. AC. SS. JAC  
APPL. NO. 110074 DATE 2/17/10

**CAÑADA COLLEGE**  
4200 Farm Hill Boulevard  
Redwood City, CA 94061

MECHANICAL  
HYDRONIC PLAN  
THIRD FLOOR

Date	08/29/08	Drawing Number	M2.3h
Scale	AS NOTED	Project Number	07013