

BCA Title: PARTIAL PIPING RISER DIAGRAM
 Project Name: CANADA COLLEGE - BUILDINGS 5 & 6 RENOVATIONS
 210 Hammond Ave., Fremont, California 94538
 510.445.1000
 510.445.1000


4200 FARM HILL BOULEVARD
 REDWOOD CITY, CA 94061
 FILE NO. 43-C1 APPL. 01-110074

Professional Engineer Seal: L. JAMES GIBSON, No. 030802, Exp. 12-31-2009, State of California.

PROJECT: 2007-0731
 CONTACT: Ben Cao
 717 Market Street, Suite 500, San Francisco, CA 94103
 TEL: 415.489.2900
 FAX: 415.489.7289
 www.interfaceengineering.com

Revision: DRAWING M12
 RFI-055
 Date: 05/11/10
 Scale: NO SCALE
 Project Number: MSK-17
 07013

FILE: 0731M32.DWG - MSK17 | EDIT: 5/14/2010 4:08 PM BY NICOLEC | PLOT: 5/14/2010 4:11 PM BY NICOLE CRONE

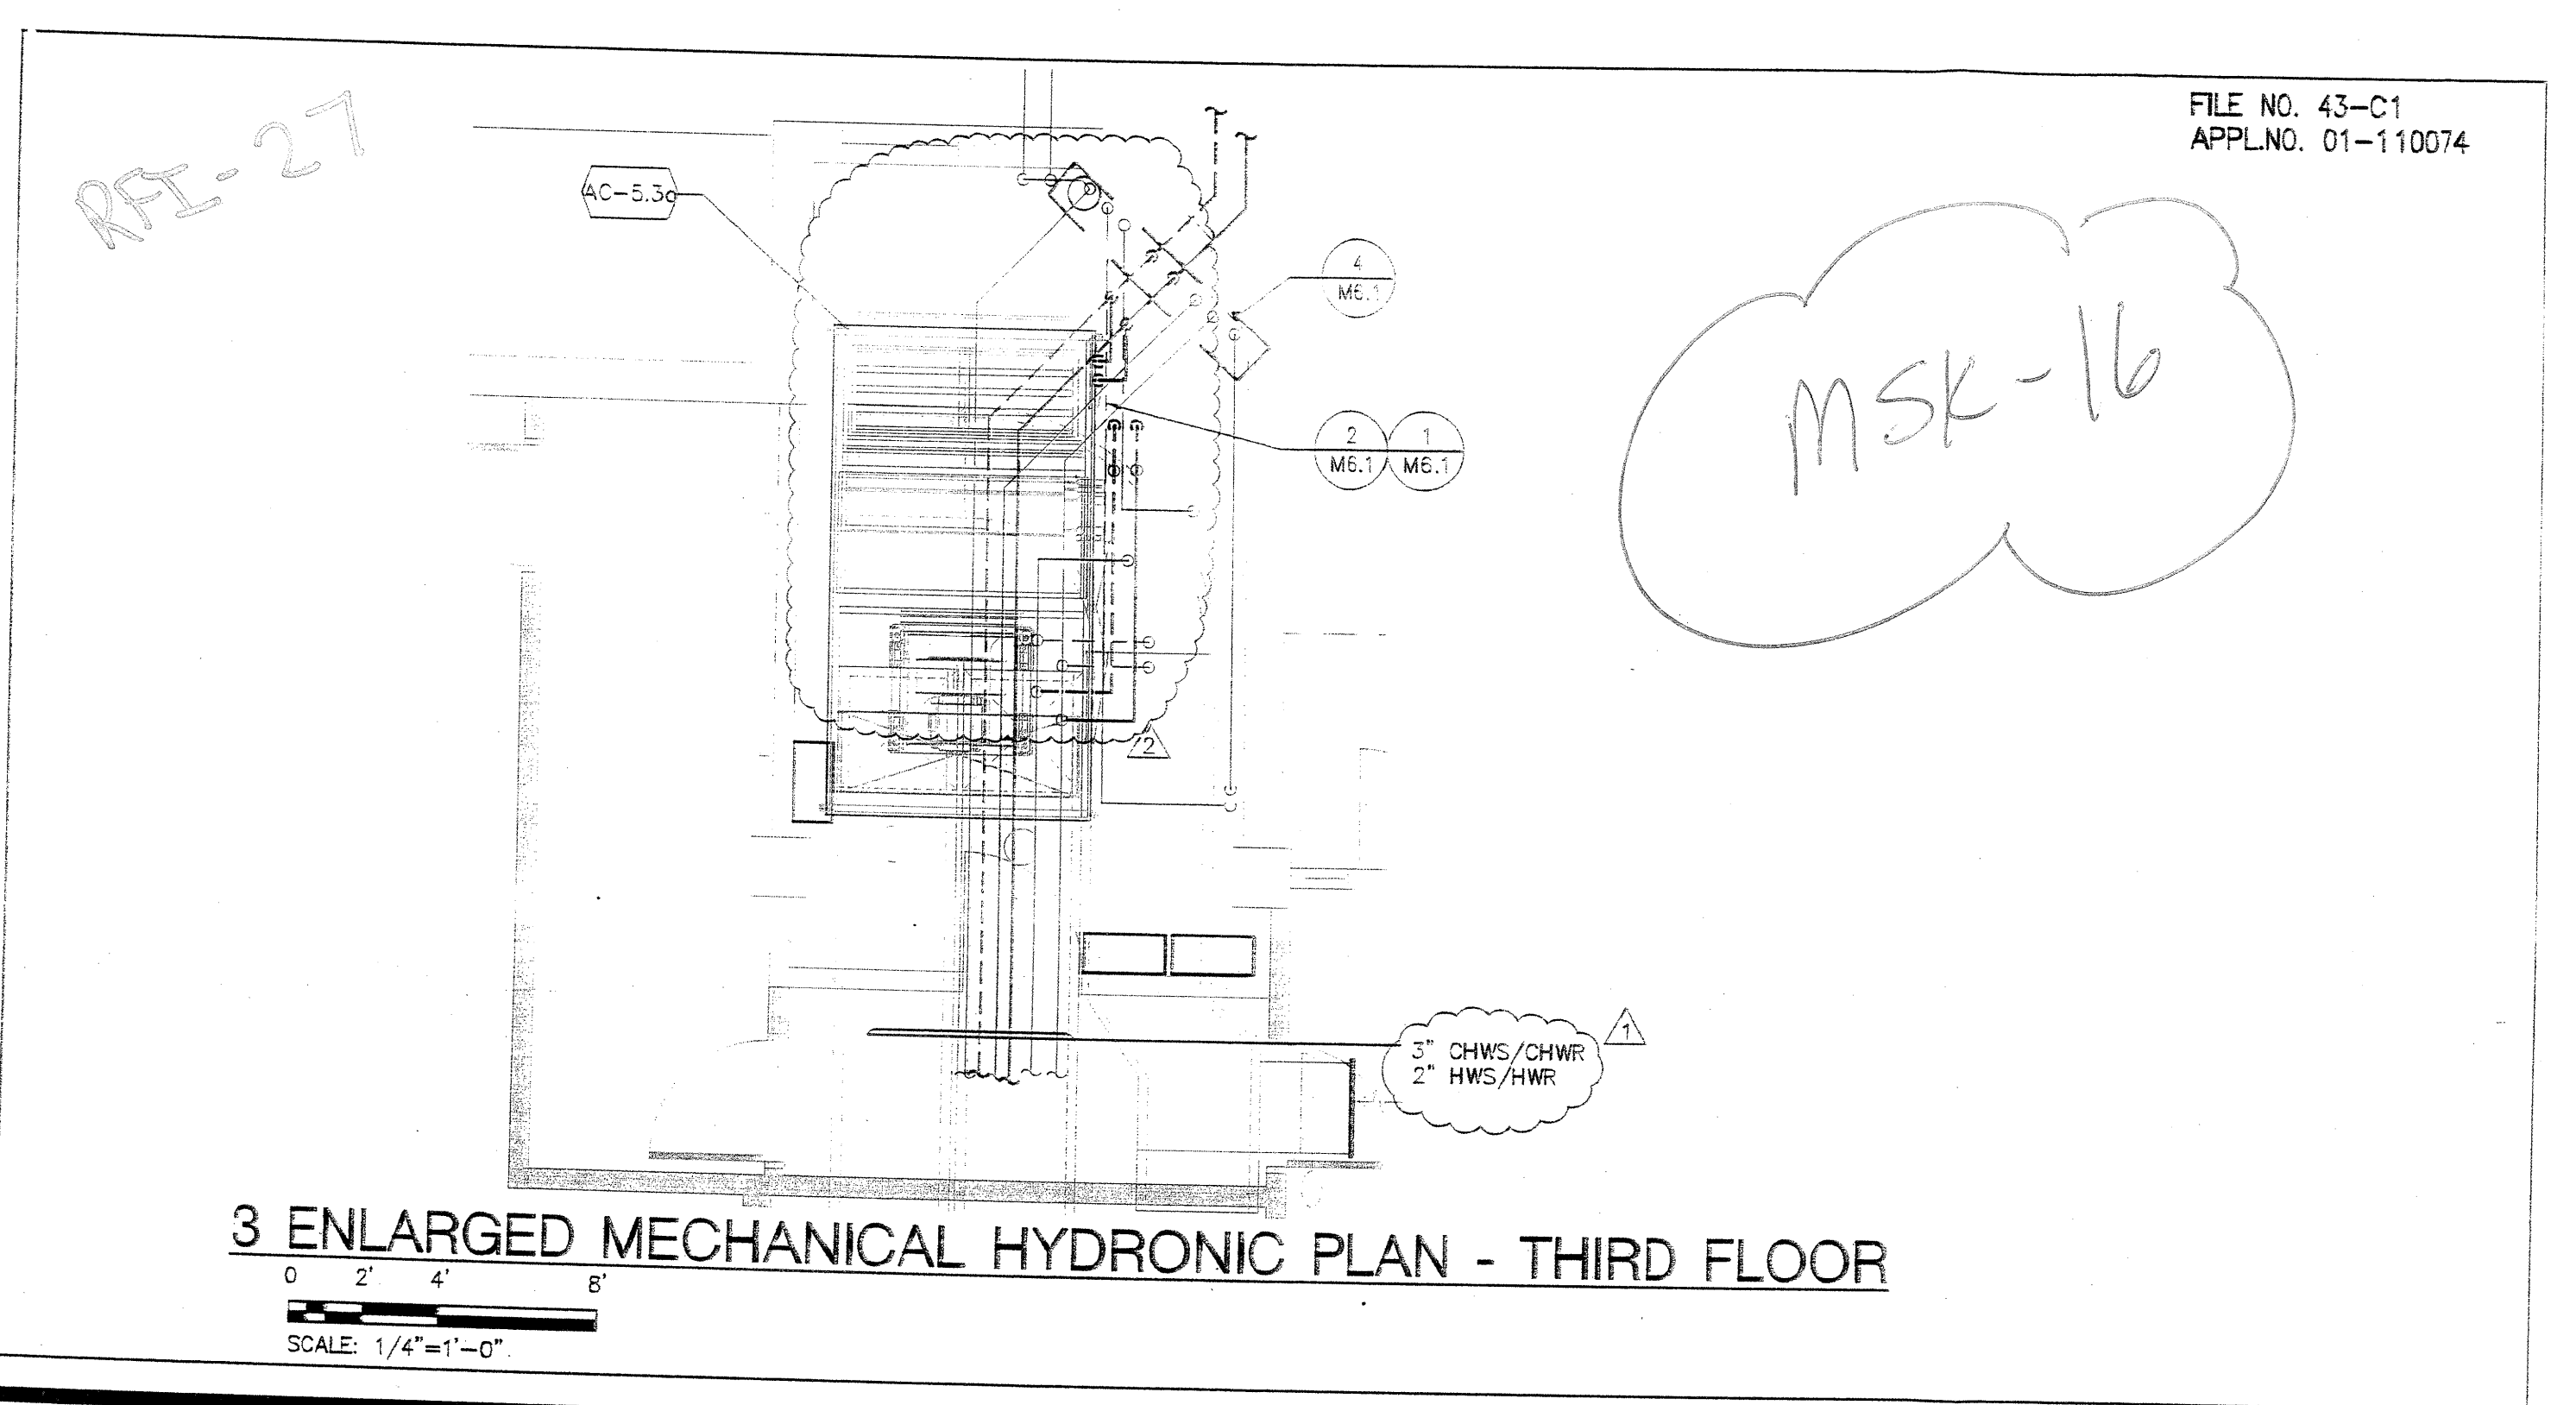

BCA Title: PARTIAL PIPING RISER DIAGRAM
 Project Name: CANADA COLLEGE - BUILDINGS 5 & 6 RENOVATIONS
 210 Hammond Ave., Fremont, California 94538
 510.445.1000
 510.445.1000


4200 FARM HILL BOULEVARD
 REDWOOD CITY, CA 94061
 FILE NO. 43-C1 APPL. 01-110074

Professional Engineer Seal: L. JAMES GIBSON, No. 030802, Exp. 12-31-2009, State of California.

PROJECT: 2007-0731
 CONTACT: Ben Cao
 717 Market Street, Suite 500, San Francisco, CA 94103
 TEL: 415.489.2900
 FAX: 415.489.7289
 www.interfaceengineering.com

Revision: DRAWING M14
 RFI-0027
 Date: 05/11/10
 Scale: NO SCALE
 Project Number: MSK-16
 07013

FILE: 0731M34.DWG - MSK16 | EDIT: 5/12/2010 8:36 AM BY ALLEN L | PLOT: 5/12/2010 8:37 AM BY ALLEN L

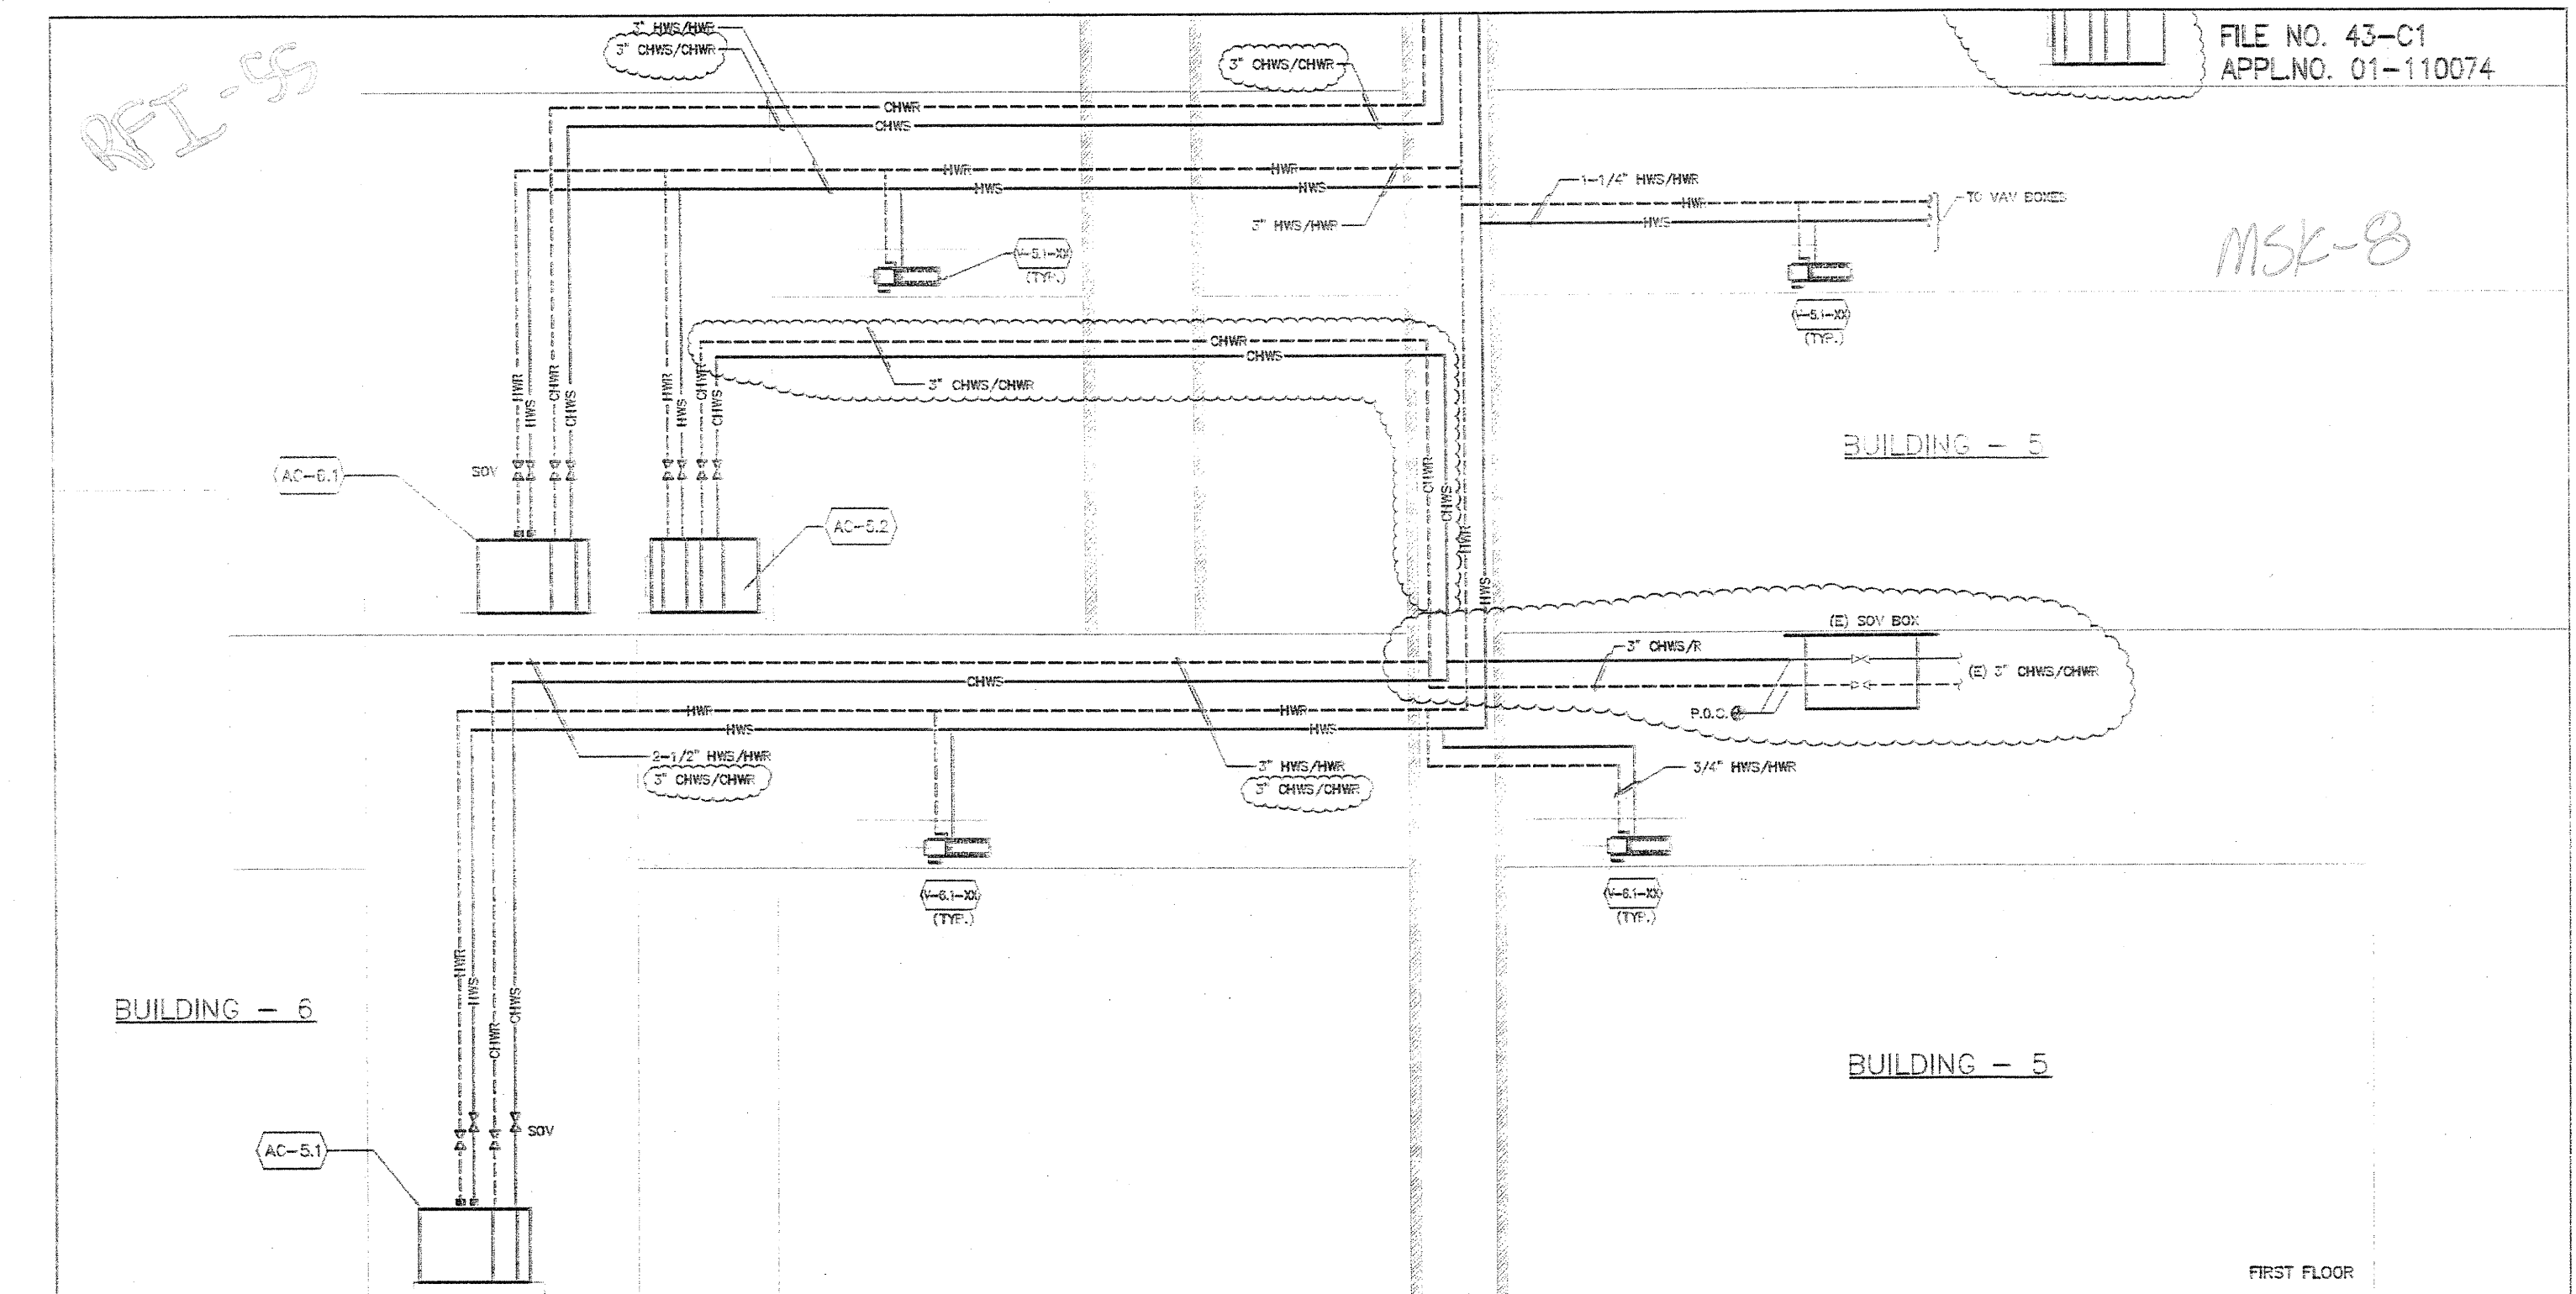

BCA Title: PARTIAL PIPING RISER DIAGRAM
 Project Name: CANADA COLLEGE - BUILDINGS 5 & 6 RENOVATIONS
 210 Hammond Ave., Fremont, California 94538
 510.445.1000
 510.445.1000

4200 FARM HILL BOULEVARD
 REDWOOD CITY, CA 94061
 FILE NO. 43-C1 APPL. 01-110074

Professional Engineer Seal: L. JAMES GIBSON, No. 030802, Exp. 12-31-2009, State of California.

PROJECT: 2007-0731
 CONTACT: Ben Cao
 717 Market Street, Suite 500, San Francisco, CA 94103
 TEL: 415.489.2900
 FAX: 415.489.7289
 www.interfaceengineering.com

Revision: DRAWING M12
 RFI-055
 Date: 05/11/10
 Scale: NO SCALE
 Project Number: MSK-08
 07013

FILE: 0731M32.DWG - MSK08 | EDIT: 5/14/2010 4:06 PM BY NICOLEC | PLOT: 5/14/2010 4:13 PM BY NICOLE CRONE