

REVISION HISTORY	REMARKS	DATE
▲	ADDENDUM NO. 1	08/18/09
▲		
▲		
▲		
▲		
▲		

DRAWING STATUS	DATE
● DESIGN CHECK	08/28/08
● DESIGN BACK CHECK	07/22/09
● BIDDING (RFP #00001)	08/18/09
○ CONSTRUCTION	

FILE NO. 41-C1
IDENTIFICATION STAMP
DIV. OF THE STATE ARCHITECT
01-110074
AC: FLS: SS: SS
DATE:

BUILDINGS 5 & 6 RENOVATIONS

San Mateo County Community College District

BID ADDENDA
APPROVED
DIV. OF THE STATE ARCHITECT
AC: FLS: SS: SS: JFF
APPL. NO. 118274 DATE 2/13/10

CAÑADA COLLEGE
4200 Farm Hill Boulevard
Redwood City, CA 94061

MECHANICAL
DEMOLITION PLAN
SECOND FLOOR


Date: 08/29/08
Drawing Number: MD1.2
Scale: AS NOTED
Project Number: 07013

GENERAL SHEET NOTES

- A. CONTRACTOR SHALL COORDINATE ALL DEMOLITION WORK WITH THE ARCHITECT AND THE COLLEGE PRIOR TO COMMENCEMENT OF WORK.
- B. REMOVE ALL EXISTING MATERIALS CONFLICTING WITH REMODEL WORK INDICATED IN CONSTRUCTION DOCUMENTS AND SUBJECT TO THE CONDITIONS INDICATED.
- C. VERIFY EXISTING CONDITIONS PRIOR TO PROCEEDING WITH THE WORK.
- D. CONTRACTOR TO OBTAIN COPY OF EXISTING RECORD DRAWINGS PRIOR TO BID.
- E. REMOVE ALL EXISTING THERMOSTATS AND WIRING.

SHEET KEY NOTES

- ① DEMOLISH EXISTING AIR HANDLING UNIT AND REMOVE ALL ASSOCIATED APPURTENANCES.
- ② DEMOLISH EXISTING SOUND ATTENUATOR.
- ③ DEMOLISH EXISTING HEATING COIL, HEATING HOT WATER PIPING, VALVES & OTHER APPURTENANCES.

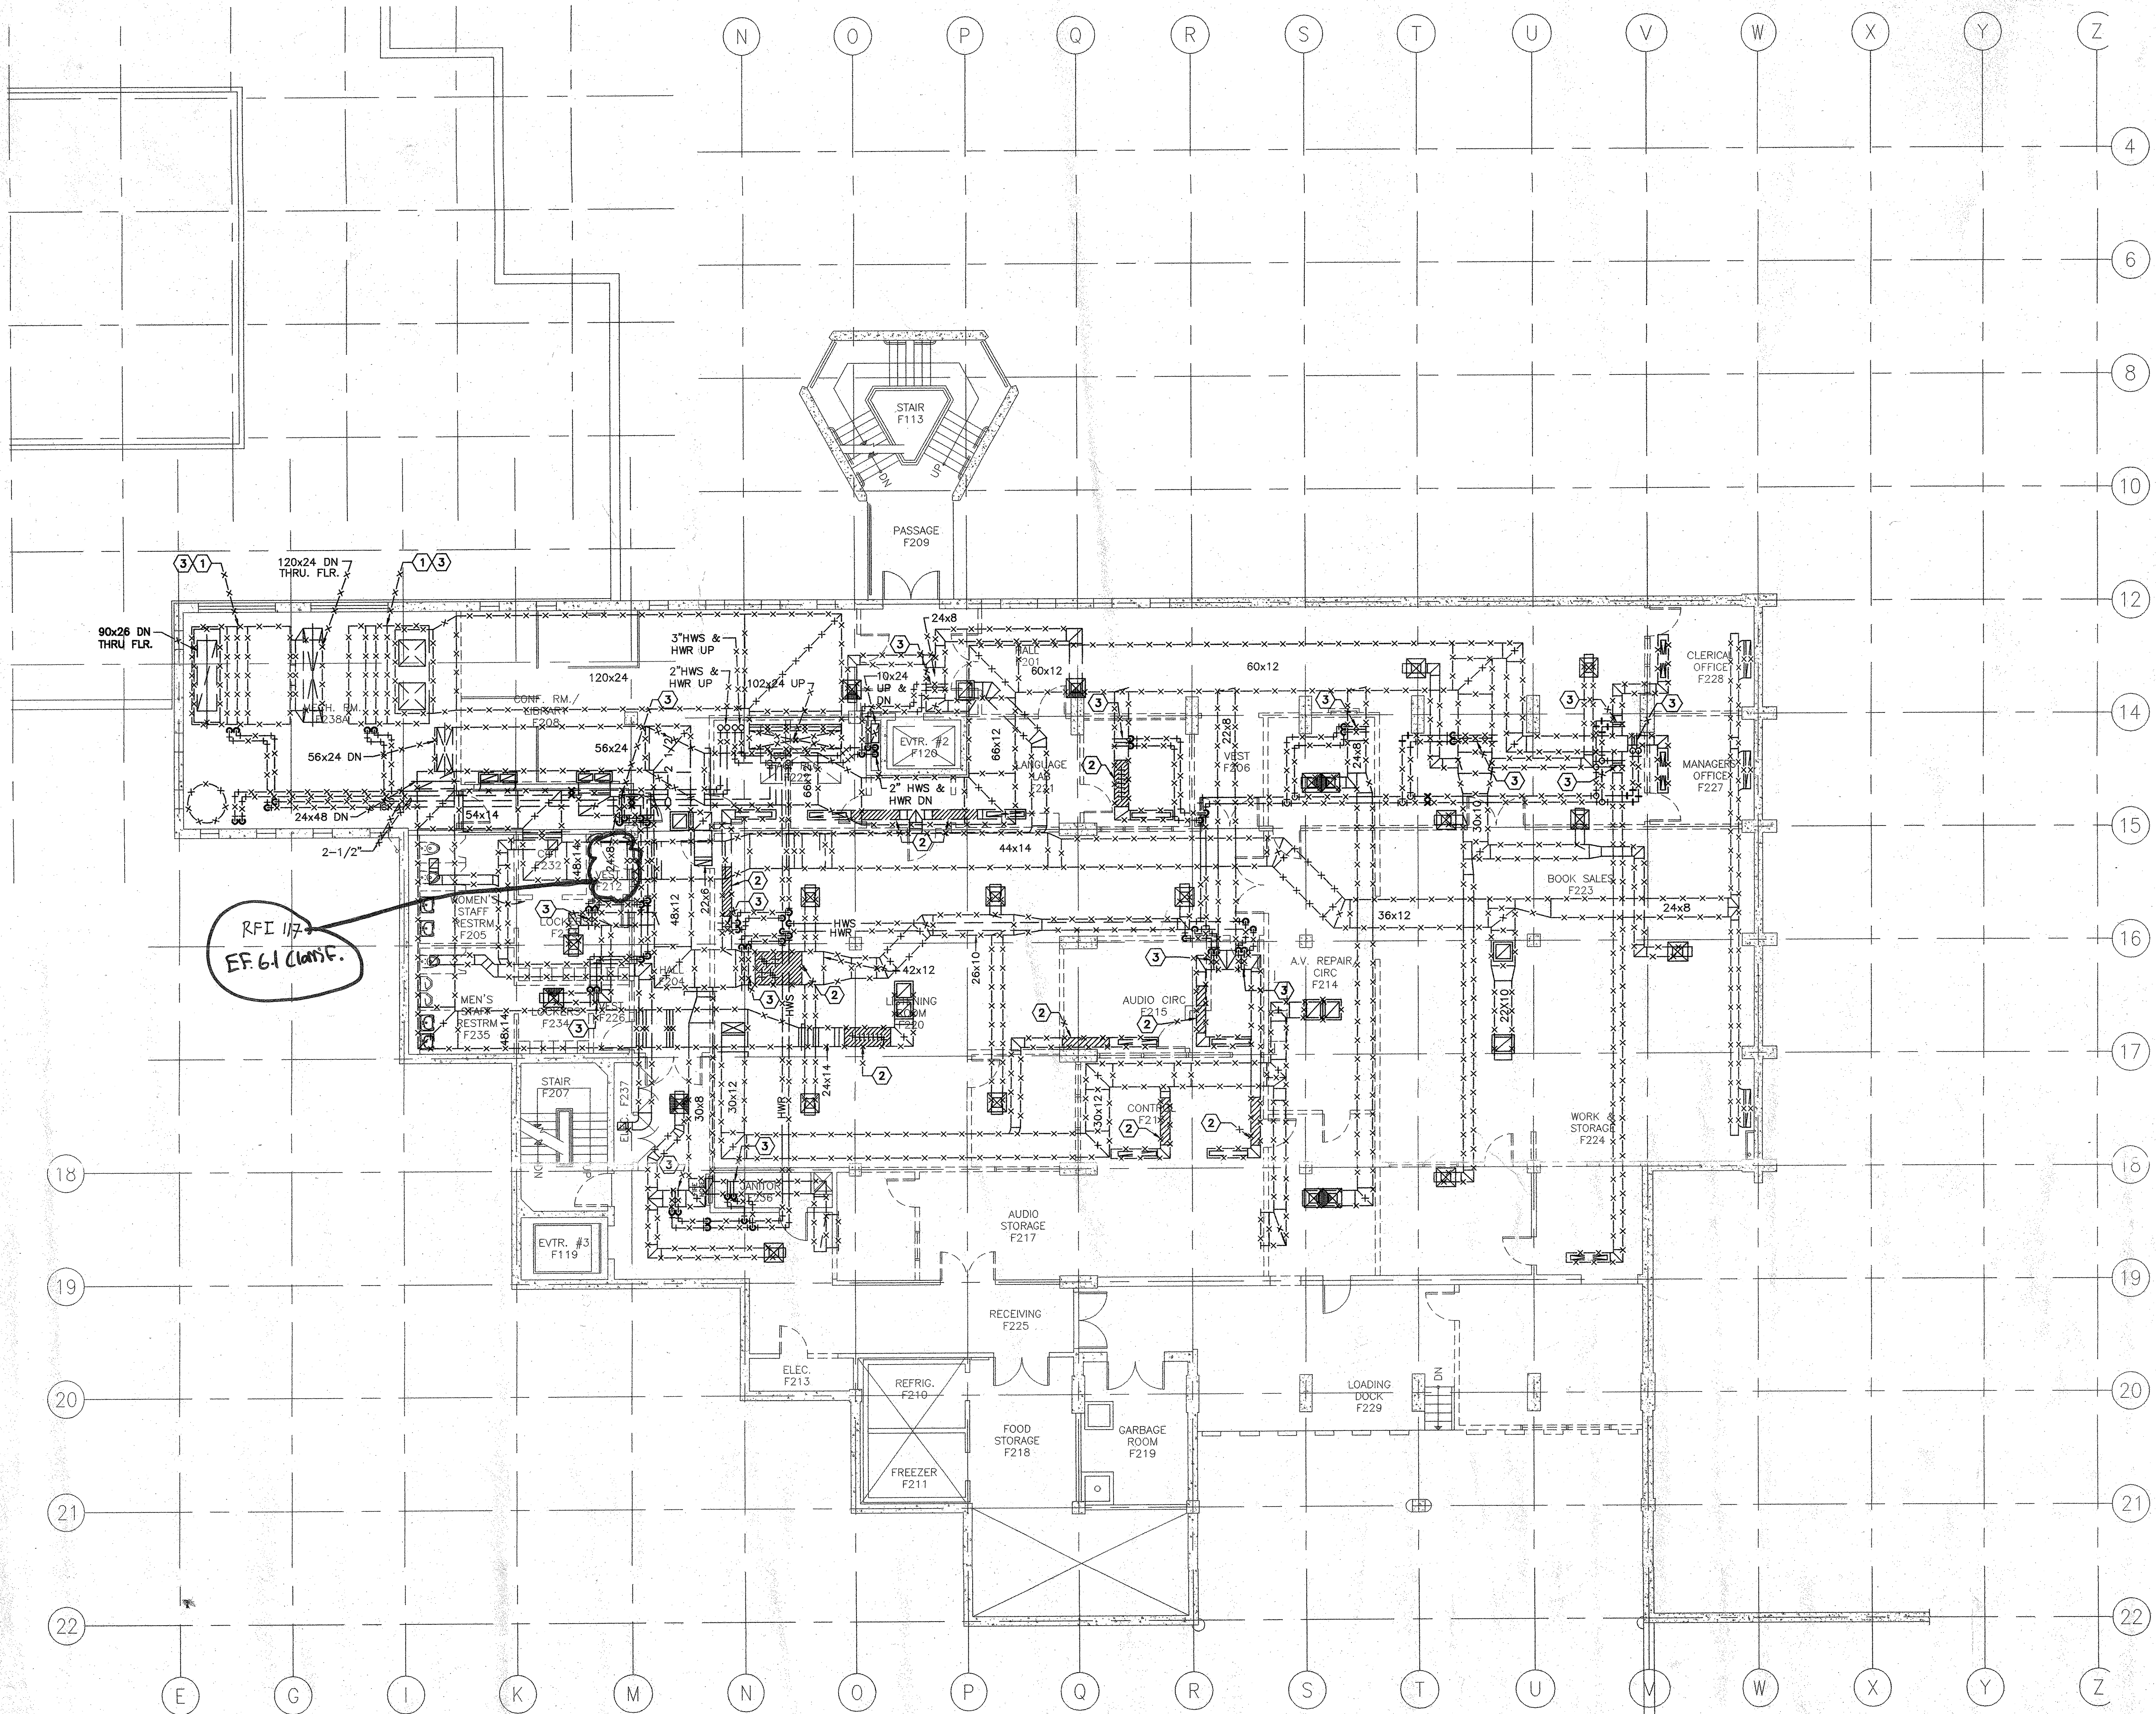

1 MECHANICAL DEMOLITION PLAN - SECOND FLOOR
SCALE: 1/8"=1'-0"