

1. This sheet is part of a set and is not to be used alone.
2. This sheet is not to be used for construction unless the architect's stamp and signature appear on the drawing and the status box indicates drawings have been released for construction.
3. These plans and prints thereof, as instruments of service, are owned by the architect and are for use on this project only. Reproduction and/or distribution without the prior written consent of the architect is forbidden.
4. Copyright Bunton Clifford Associates, 2007

REVISION	DATE
ADDENDUM NO. 1	08/19/08

DATE
08/29/08
08/18/08

FILE NO. 41-C1
IDENTIFICATION STAMP
DIV. OF THE STATE ARCHITECT
01-110074
AC. FLS. SS.
DATE

**BUILDINGS 5 & 6
RENOVATIONS**

San Mateo County Community
College District

BID ADDENDA

APPROVED BY
DIV. OF THE STATE ARCHITECT
AC. *M. P. S. R. C. S. S.*
APPL. NO. 110074 DATE 2/17/10

CAÑADA COLLEGE
4200 Farm Hill Boulevard
Redwood City, CA 94061

MECHANICAL
DEMOLITION PLAN
THIRD FLOOR


Date	08/29/08	Drawing Number	MD1.3
Scale	AS NOTED	Project Number	07013

GENERAL SHEET NOTES

- A. CONTRACTOR SHALL COORDINATE ALL DEMOLITION WORK WITH THE ARCHITECT AND THE COLLEGE PRIOR TO COMMENCEMENT OF WORK.
- B. REMOVE ALL EXISTING MATERIALS CONFLICTING WITH REMODEL WORK INDICATED IN CONSTRUCTION DOCUMENTS AND SUBJECT TO THE CONDITIONS INDICATED.
- C. VERIFY EXISTING CONDITIONS PRIOR TO PROCEEDING WITH THE WORK.
- D. CONTRACTOR TO OBTAIN COPY OF EXISTING RECORD DRAWINGS PRIOR TO BID.
- E. REMOVE ALL EXISTING THERMOSTATS AND WIRING.

SHEET KEY NOTES

- 1 DEMOLISH EXISTING AIR HANDLING UNIT AND REMOVE ALL ASSOCIATED APPURTENANCES.
- 2 DEMOLISH EXISTING SOUND ATTENUATOR.
- 3 DEMOLISH EXISTING HEATING COIL.
- 4 EXHAUST DUCTING AND TRANSFER AIR DUCTING SERVING THE TOILET ROOMS SHALL REMAIN. DEMOLISH EXISTING DIFFUSERS.
- 5 EXHAUST DUCTING AND TRANSFER AIR DUCTING SERVING THE KITCHEN AND SERVERY SHALL REMAIN.
- 6 DEMOLISH EXISTING 36X36 EXHAUST RISER ALL THE WAY UP THROUGH ROOF TO EXISTING EF-5.3 TO BE REMOVED.
- 7 DEMOLISH ALL EXISTING HEATING HOT WATER PIPING IN MECHANICAL ROOM UP TO RISERS AND CAP FOR CONNECTION TO IN NEW WORK.
- 8 CAP EXISTING HEATING HOT WATER PIPING TO REMAIN AT THIS POINT FOR CONNECTION TO IN NEW WORK.

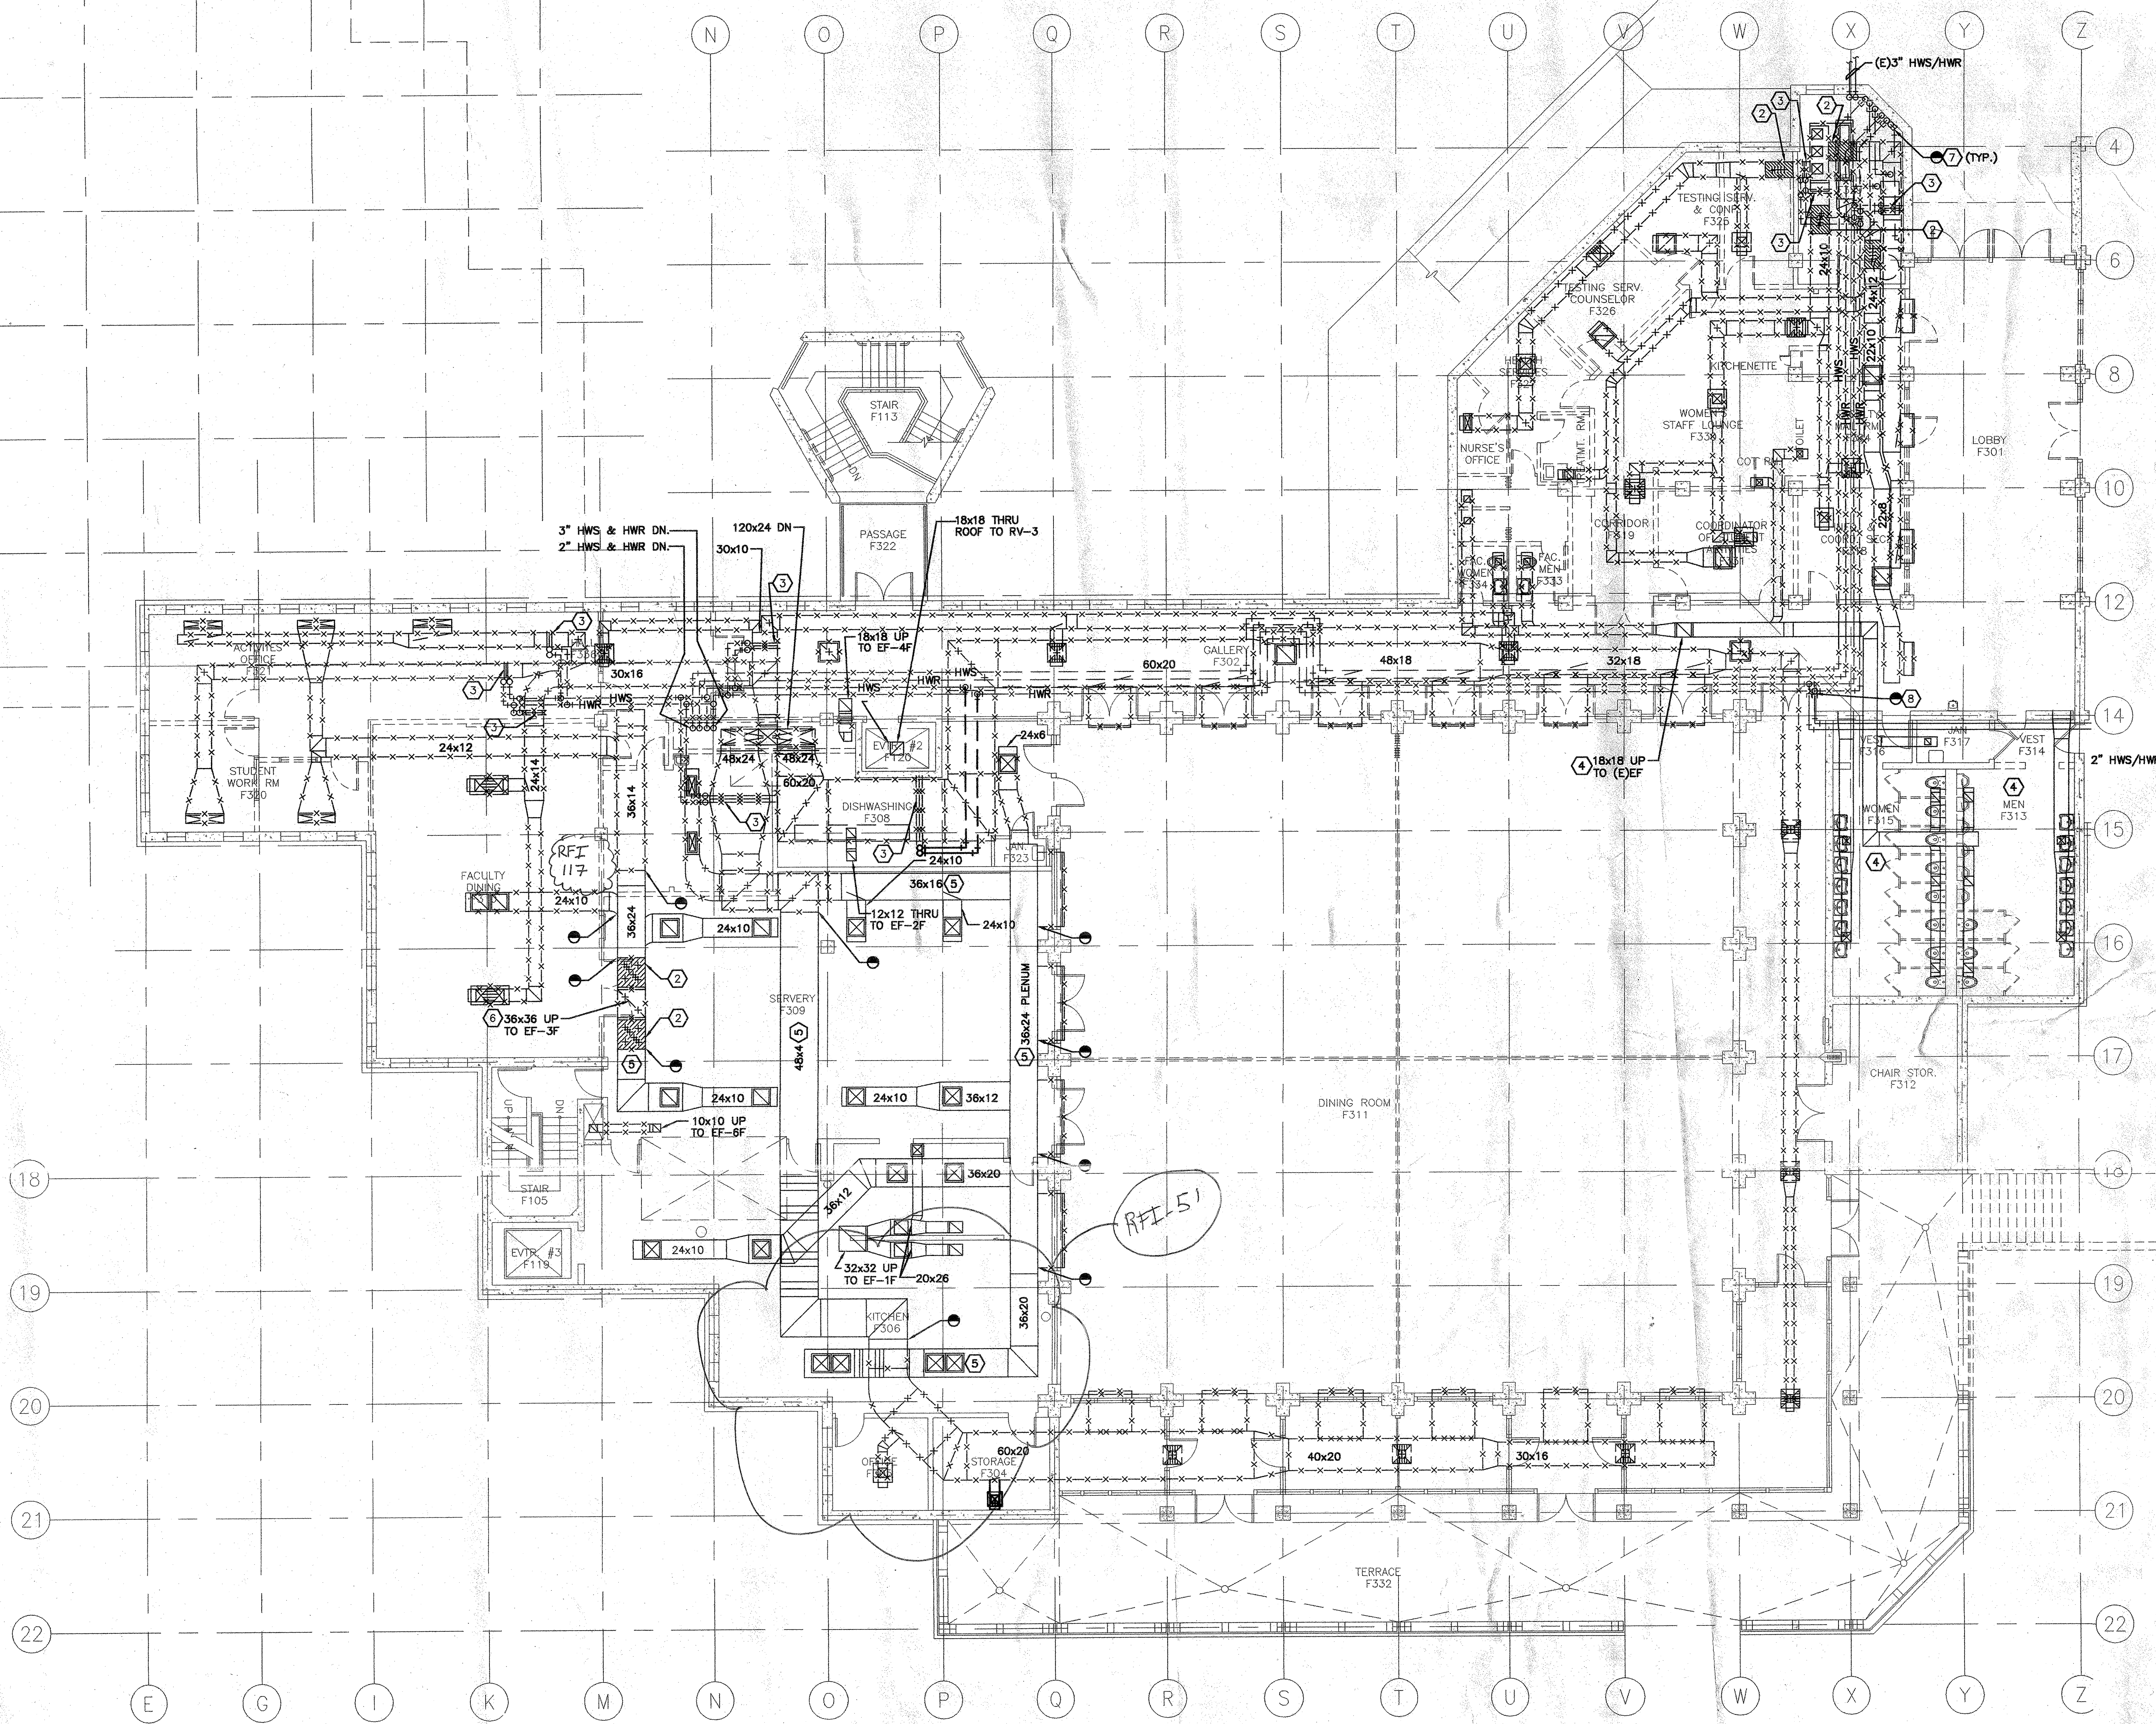

1 MECHANICAL DEMO PLAN - THIRD FLOOR
SCALE: 1/8"=1'-0"