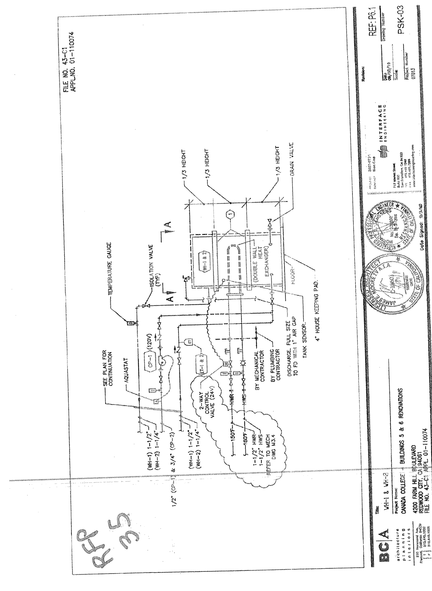
RFP
35
FILE NO. 43-C1
APPL.NO. 01-110074
SEE PLAN FOR CONTINUATION
SOLARTAT
TEMPERATURE GAUGE
ISOLATION VALVE (TYP)
1/2" (OP-2) & 3/4" (OP-2)
2-WAY CONTROL VALVE (SH-1)
BY MECHANICAL CONTRACTOR
BY PLUMBING CONTRACTOR
DISCHARGE FULL SIZE TO 3" AIR GAP
TANK SENSOR
4" HOUSE KEEPING PAD
DRAIN VALVE
1/3 HEIGHT
1/3 HEIGHT
1/3 HEIGHT
A
A
BC|A
VH-1 & VH-2
BUILDINGS 5 & 6 RENOVATIONS
CANADA COLLEGE
4200 FARM HILL BOULEVARD
REDWOOD CITY, CALIFORNIA
FILE NO. 43-C1 APPL. 01-110074
INTERFACE ENGINEERING
Date Signed: 10/3/08
REF-P&1
PSK-03