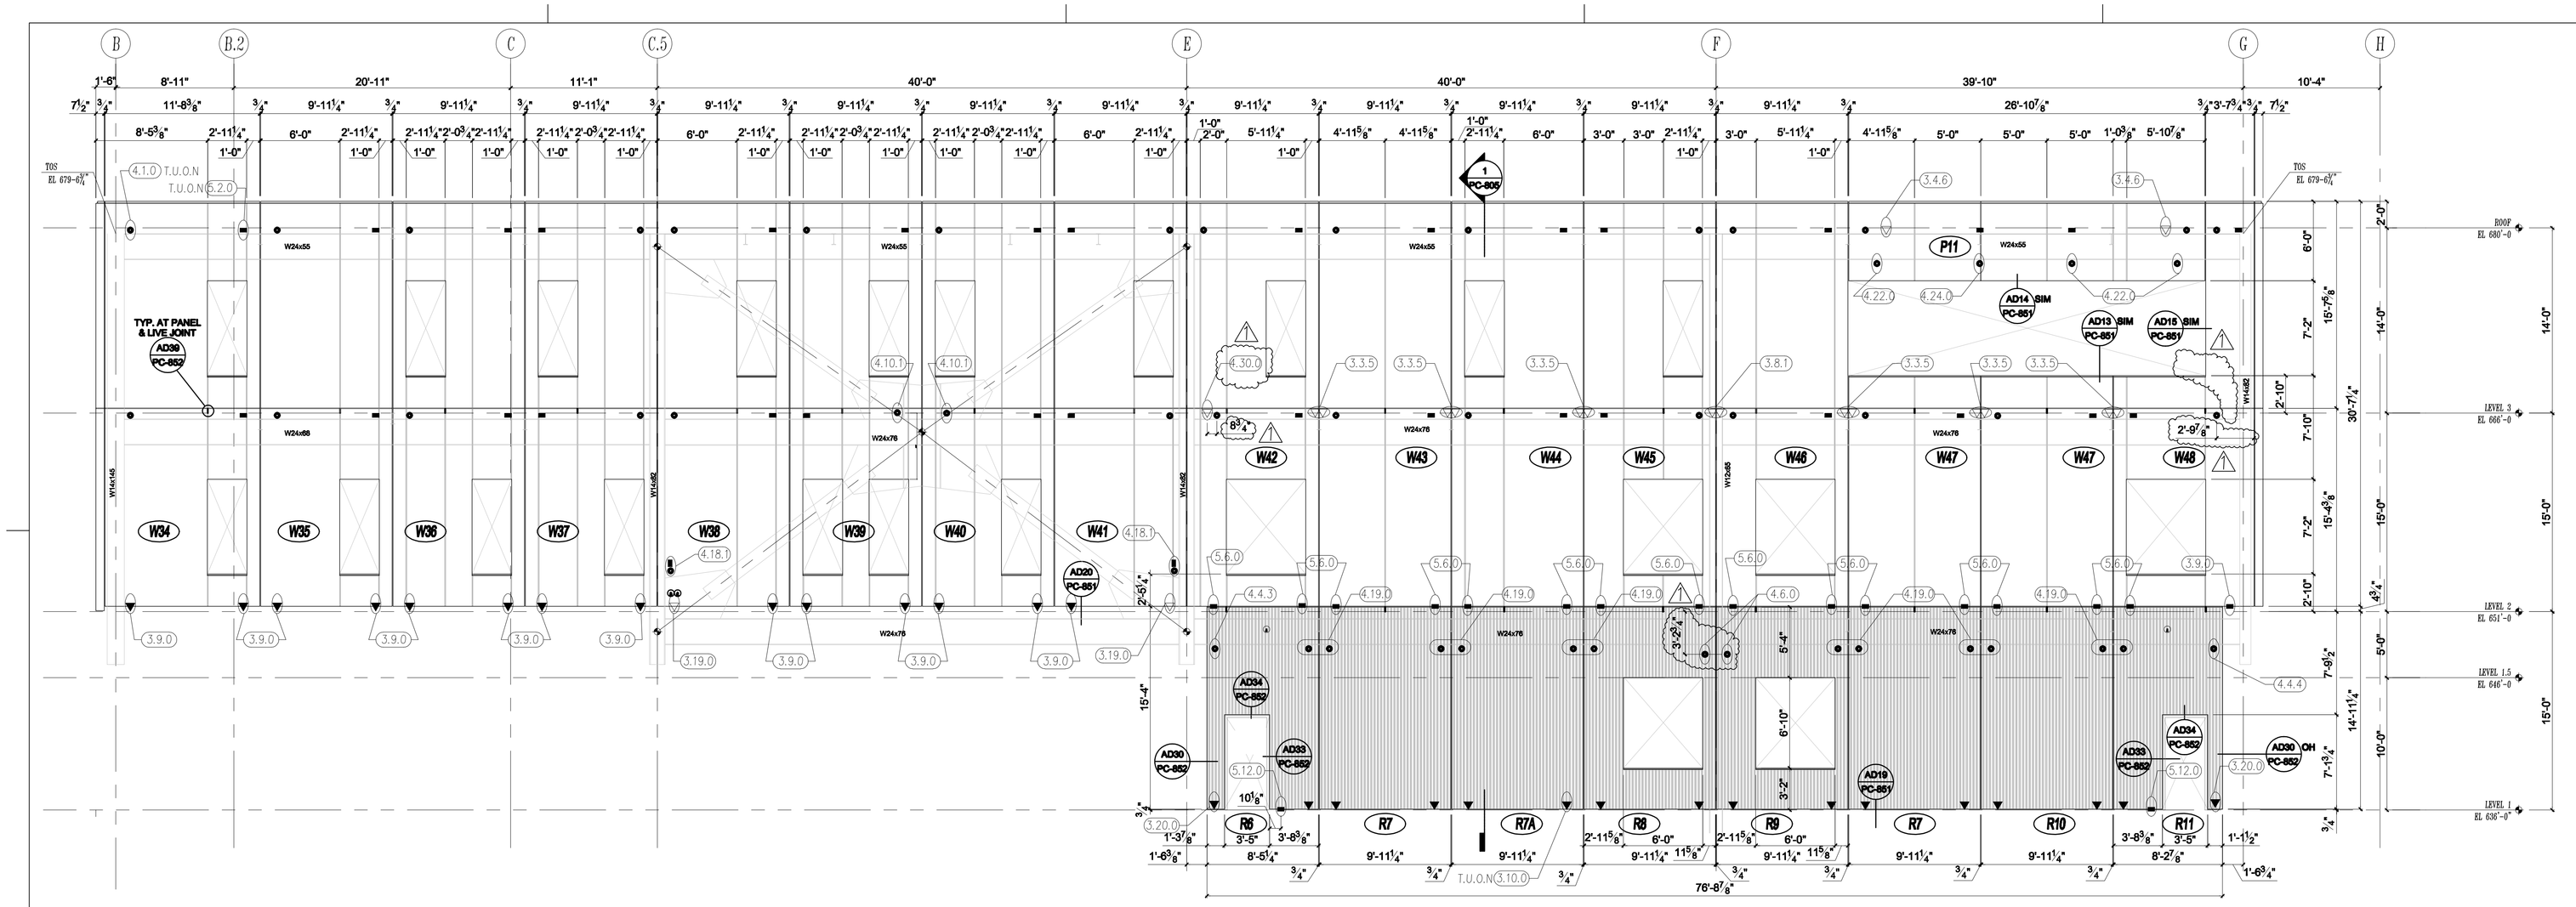

SOUTH ELEVATION ALONG 1
3/16" = 1'-0" (1)

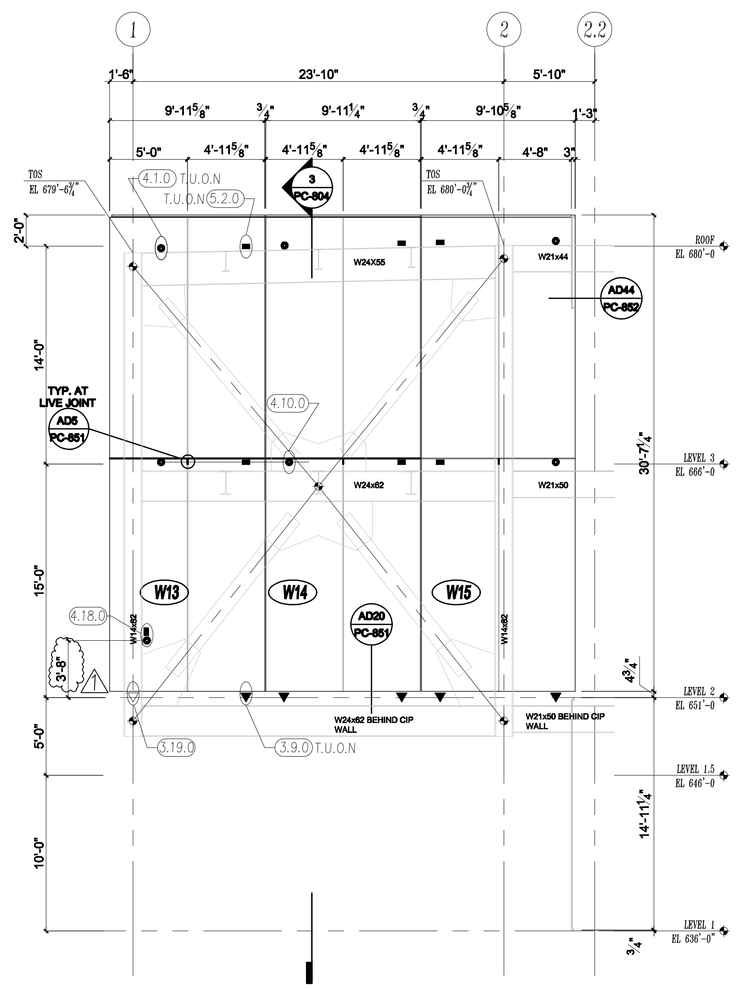

EAST ELEVATION ALONG G
3/16" = 1'-0" (2)

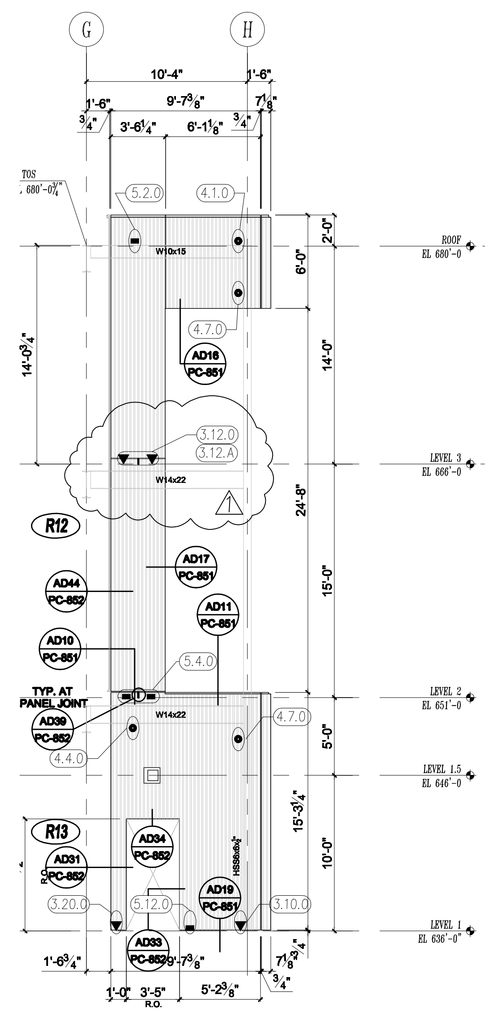

PARTIAL SOUTH ELEVATION ALONG 2.2
3/16" = 1'-0" (3)

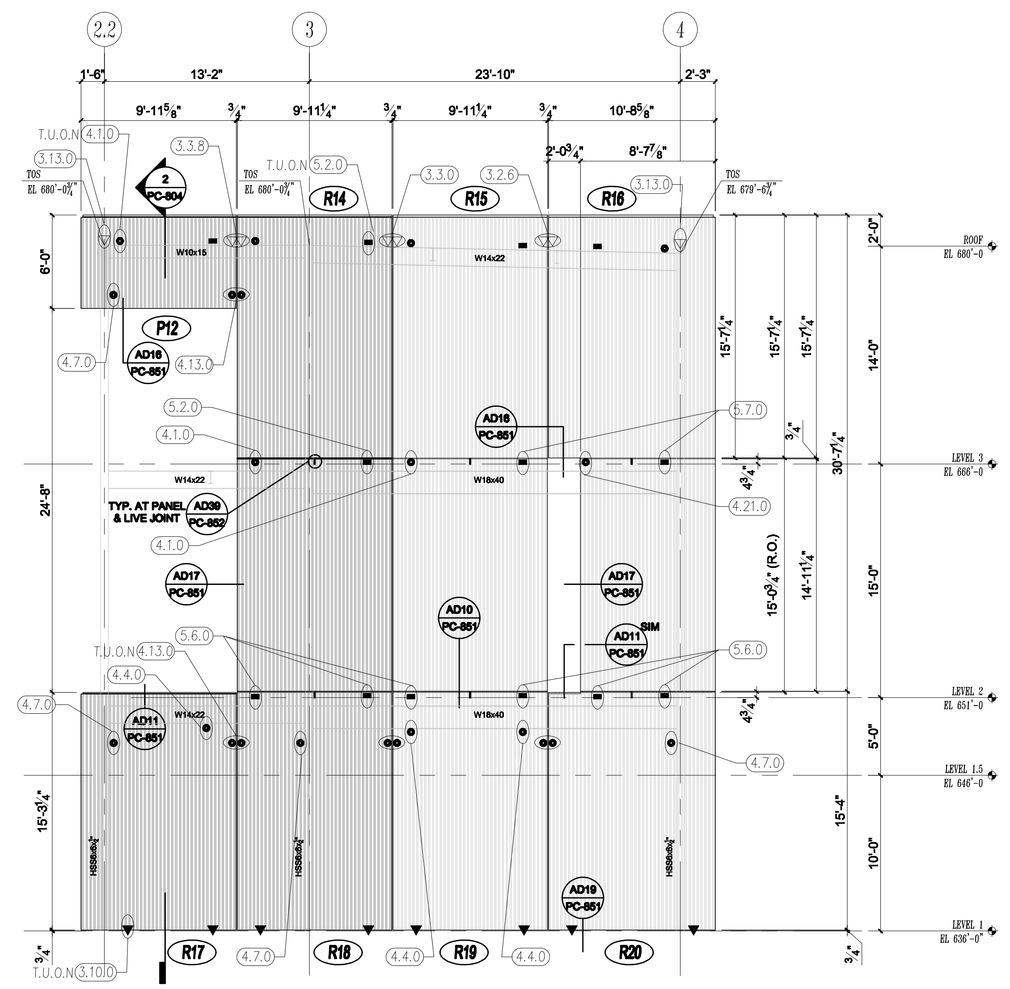

EAST ELEVATION ALONG H
3/16" = 1'-0" (4)

CONNECTION DETAILS START ON PC-831

All drawings and written material appearing herein constitute original and unpublished work of the Architect/Engineer and may not be duplicated, used or disclosed without consent of Architect/Engineer.

If this drawing is not 30"x42", then the drawing has been revised from its original size. Noted scales must be adjusted. This line should be equal to one inch _____

WRNS STUDIO, LLP
501 SECOND STREET
4TH FLOOR, STE. 402
SAN FRANCISCO
CALIFORNIA 94107
415.489.2224 TEL
415.358.9100 FAX
WWW.WRNSSTUDIO.COM

Steinberg Architects

Hensel Phelps Construction Co.

WILLIS CONSTRUCTION CO. INC.
PRE-CAST CONCRETE PRODUCTS
2261 SAN JUAN HIGHWAY, SAN JUAN BAUTISTA, CA 95045.
(831)623-2661 LIC NO. 380146. FAX (831)623-2365

NO.	ISSUES/REVISIONS	DATE
1	100% SCHEMATIC DESIGN SUBMITTAL	04/28/08
2	50 % DESIGN DEVELOPMENT SUBMITTAL	06/13/08
3	100% DESIGN DEVELOPMENT SUBMITTAL	07/25/08
4	DSA INCREMENT # 1: SITE DEMOLITION EXCAVATION ROUGH GRADING & UTILITIES	09/25/08
5	INCREMENT # 2: 90% REVIEW	10/10/08
6	DSA INCREMENT # 2: STRUCTURE & GFRC PANELS	11/11/08
11	DSA INCREMENT # 2: BACKCHECK	03/11/09

REGISTERED PROFESSIONAL ENGINEER
MICHAEL ANDREW
No. C67443
Exp. 06/30/09
CIVIL
STATE OF CALIFORNIA

DIVISION OF THE STATE ARCHITECT
APPL # 01-110117
FILE # 41-C1
AC _____ FLS _____
SSS _____ DATE _____
IDENTIFICATION STAMP

SKYLINE COLLEGE
SAN MATEO COUNTY COMMUNITY COLLEGE DISTRICT

CIP2 DESIGN-BUILD PROJECT BUILDING 4 INCREMENT 2

KEYPLAN

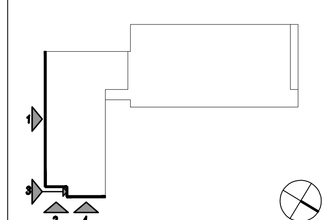

PROJECT NO.: 07012.00 DRAWN BY: JG/CQ
DATE: 04/28/08 CHECKED BY:
SCALE: —

SHEET TITLE:
ENLARGED ELEVATIONS

AS BUILT DRAWINGS
JANUARY 12, 2011
12/02/09

SHEET NO:
PC-323