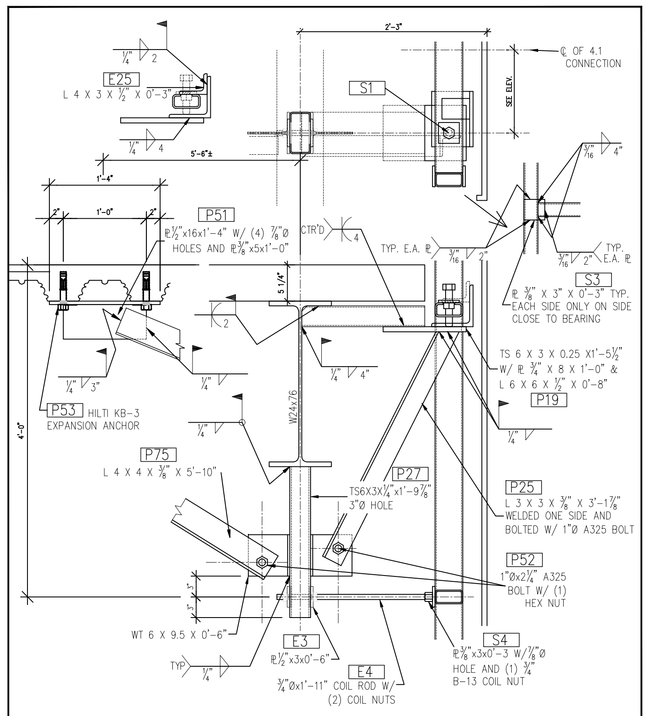

WORK THIS DRAWING WITH DWG 3.6.2

WILLIS CONSTRUCTION CO. INC. PRE-CAST CONCRETE PRODUCTS	JOB NAME: Skyline BLDG 4N	JOB NO. 858
2261 SAN JUAN HIGHWAY • SAN JUAN BAUTISTA, CA. 95045 (831) 623-2900 • FAX (831) 623-2585	BY: M.A.	DATE:
	SUBJECT: CONNECTION	REV: PAGE: 3.6.1

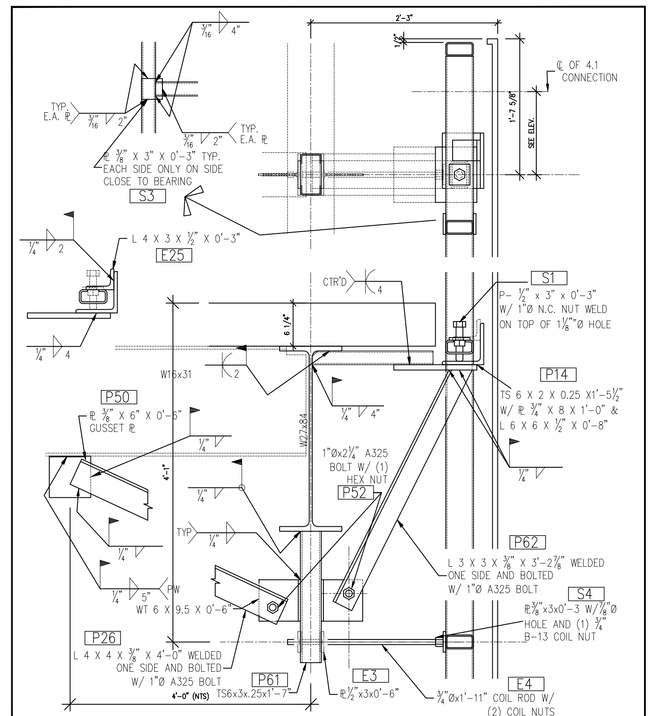

UPPER LEVEL PANEL BEARING

WILLIS CONSTRUCTION CO. INC. PRE-CAST CONCRETE PRODUCTS	JOB NAME: Skyline BLDG 4N	JOB NO. 858
2261 SAN JUAN HIGHWAY • SAN JUAN BAUTISTA, CA. 95045 (831) 623-2900 • FAX (831) 623-2585	BY: M.A.	DATE:
	SUBJECT: CONNECTION	REV: PAGE: 3.6.0

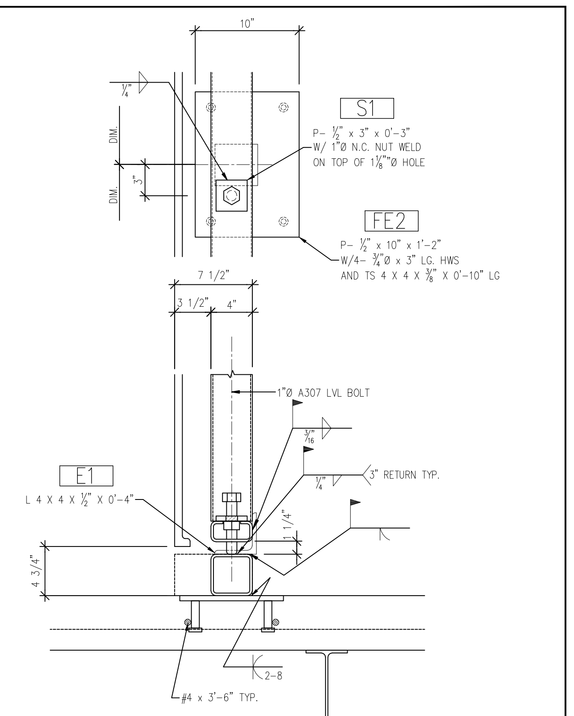

UPPER LEVEL PANEL BEARING

WILLIS CONSTRUCTION CO. INC. PRE-CAST CONCRETE PRODUCTS	JOB NAME: Skyline BLDG 4N	JOB NO. 858
2261 SAN JUAN HIGHWAY • SAN JUAN BAUTISTA, CA. 95045 (831) 623-2900 • FAX (831) 623-2585	BY: M.A.	DATE:
	SUBJECT: CONNECTION	REV: PAGE: 3.5.0

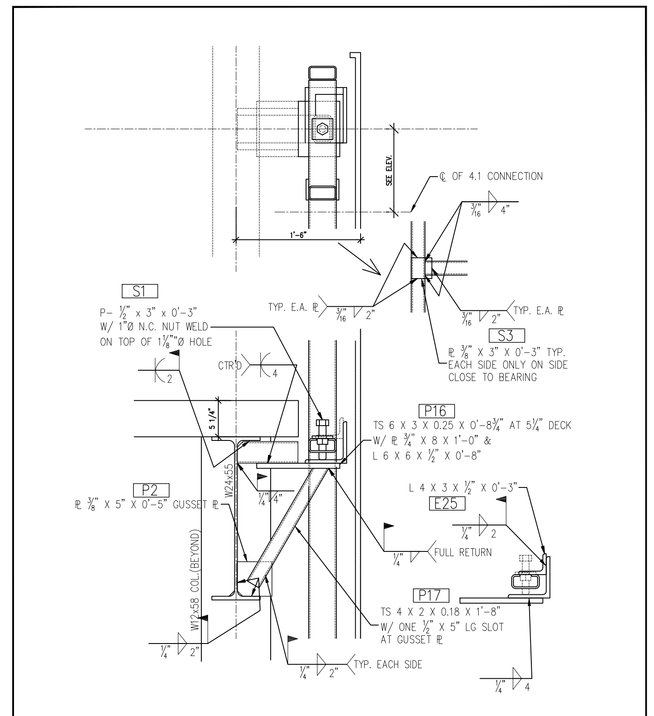

UPPER LEVEL PANEL BEARING

WILLIS CONSTRUCTION CO. INC. PRE-CAST CONCRETE PRODUCTS	JOB NAME: Skyline BLDG 4N	JOB NO. 858
2261 SAN JUAN HIGHWAY • SAN JUAN BAUTISTA, CA. 95045 (831) 623-2900 • FAX (831) 623-2585	BY: M.A.	DATE:
	SUBJECT: CONNECTION	REV: PAGE: 3.4.13

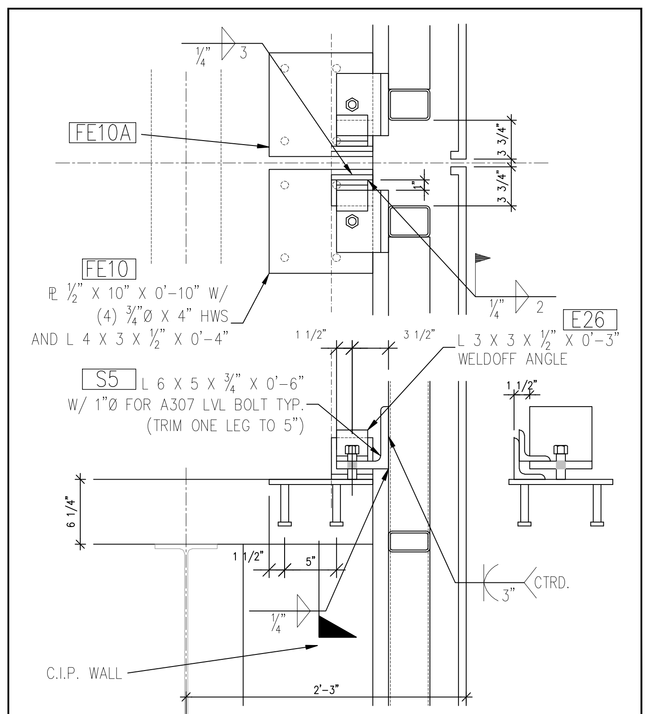

UPPER LEVEL PANEL BEARING

WILLIS CONSTRUCTION CO. INC. PRE-CAST CONCRETE PRODUCTS	JOB NAME: Skyline BLDG 4N	JOB NO. 858
2261 SAN JUAN HIGHWAY • SAN JUAN BAUTISTA, CA. 95045 (831) 623-2900 • FAX (831) 623-2585	BY: M.A.	DATE:
	SUBJECT: CONNECTION	REV: PAGE: 3.7.0

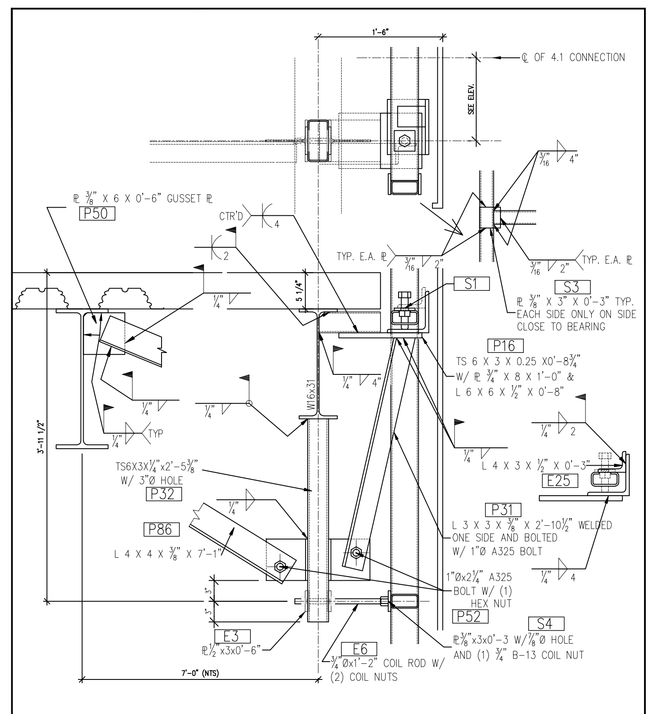

UPPER LEVEL PANEL BEARING

WILLIS CONSTRUCTION CO. INC. PRE-CAST CONCRETE PRODUCTS	JOB NAME: Skyline BLDG 4N	JOB NO. 858
2261 SAN JUAN HIGHWAY • SAN JUAN BAUTISTA, CA. 95045 (831) 623-2900 • FAX (831) 623-2585	BY: M.A.	DATE:
	SUBJECT: CONNECTION	REV: PAGE: 3.6.3

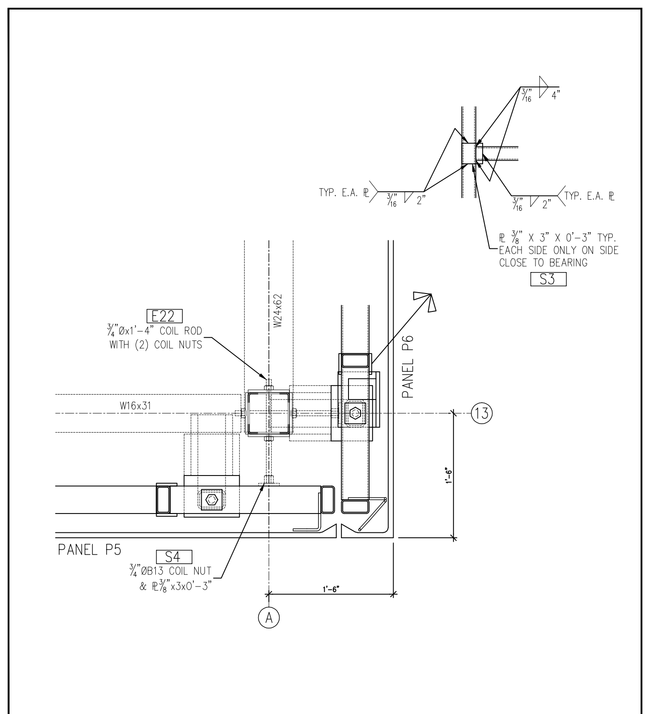

UPPER LEVEL PANEL BEARING

WILLIS CONSTRUCTION CO. INC. PRE-CAST CONCRETE PRODUCTS	JOB NAME: Skyline BLDG 4N	JOB NO. 858
2261 SAN JUAN HIGHWAY • SAN JUAN BAUTISTA, CA. 95045 (831) 623-2900 • FAX (831) 623-2585	BY: M.A.	DATE:
	SUBJECT: CONNECTION	REV: PAGE: 3.6.2A

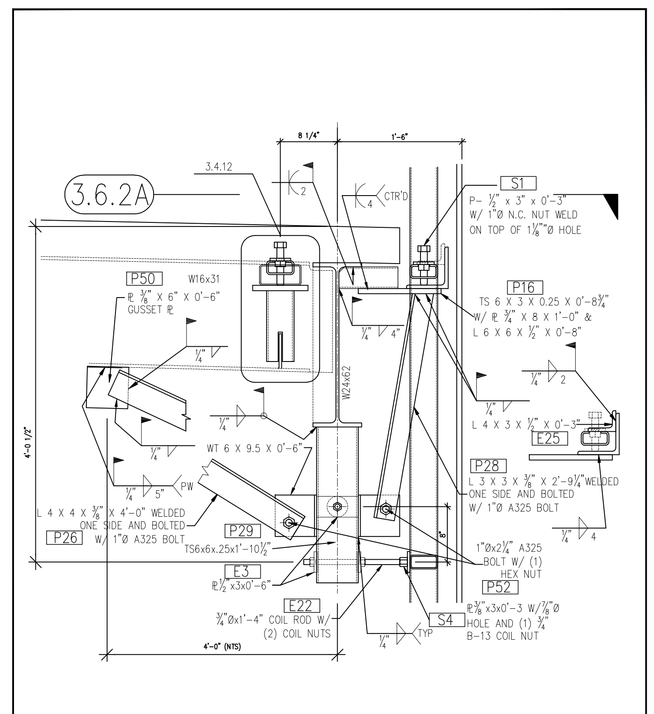

UPPER LEVEL PANEL BEARING

WILLIS CONSTRUCTION CO. INC. PRE-CAST CONCRETE PRODUCTS	JOB NAME: Skyline BLDG 4N	JOB NO. 858
2261 SAN JUAN HIGHWAY • SAN JUAN BAUTISTA, CA. 95045 (831) 623-2900 • FAX (831) 623-2585	BY: M.A.	DATE:
	SUBJECT: CONNECTION	REV: PAGE: 3.6.2

All drawings and written material appearing herein constitute original and unpublished work of the Architect/Engineer and may not be duplicated, used or disclosed without consent of Architect/Engineer.

If this drawing is not 30"x42", then the drawing has been revised from its original size. Noted scales must be adjusted. This line should be equal to one inch

WRNS STUDIO, LLP
501 SECOND STREET
4TH FLOOR, STE. 402
SAN FRANCISCO
CALIFORNIA 94107
415.489.2224 TEL
415.358.9100 FAX
WWW.WRNSSTUDIO.COM

Steinberg Architects

Hensel Phelps Construction Co.

WILLIS CONSTRUCTION CO. INC.
PRE-CAST CONCRETE PRODUCTS
2261 SAN JUAN HIGHWAY. SAN JUAN BAUTISTA, CA 95045.
(831)623-2900 LIC. NO. 380618. FAX (831)623-2585

NO.	ISSUES/REVISIONS	DATE
1	100% SCHEMATIC DESIGN SUBMITTAL	04/28/08
2	50 % DESIGN DEVELOPMENT SUBMITTAL	06/13/08
3	100% DESIGN DEVELOPMENT SUBMITTAL	07/28/08
4	DSA INCREMENT # 1: SITE DEMOLITION EXCAVATION ROUGH GRADING & UTILITIES	09/25/08
5	INCREMENT # 2: 90% REVIEW	10/10/08
6	DSA INCREMENT # 2: STRUCTURE & GFRC PANELS	11/11/08
11	DSA INCREMENT # 2: BACKCHECK	03/11/09

REGISTERED PROFESSIONAL ENGINEER MITCH ANDRUS No. C67443 Exp. 06/30/09 CIVIL STATE OF CALIFORNIA

DIVISION OF THE STATE ARCHITECT
APPL # 01-110117
FILE # 41-C1
AC _____ FLS _____
SSS _____ DATE _____
IDENTIFICATION STAMP

SKYLINE COLLEGE

SAN MATEO COUNTY COMMUNITY COLLEGE DISTRICT

CIP2 DESIGN-BUILD PROJECT BUILDING 4 INCREMENT 2

KEYPLAN

PROJECT NO.: 07012.00 DRAWN BY: JG/CQ
DATE: 04/28/08 CHECKED BY:
SCALE: —

SHEET TITLE:
CONNECTION DETAILS

AS BUILT DRAWINGS
JANUARY 12, 2011

SHEET NO:
PC-835