



RFP 42

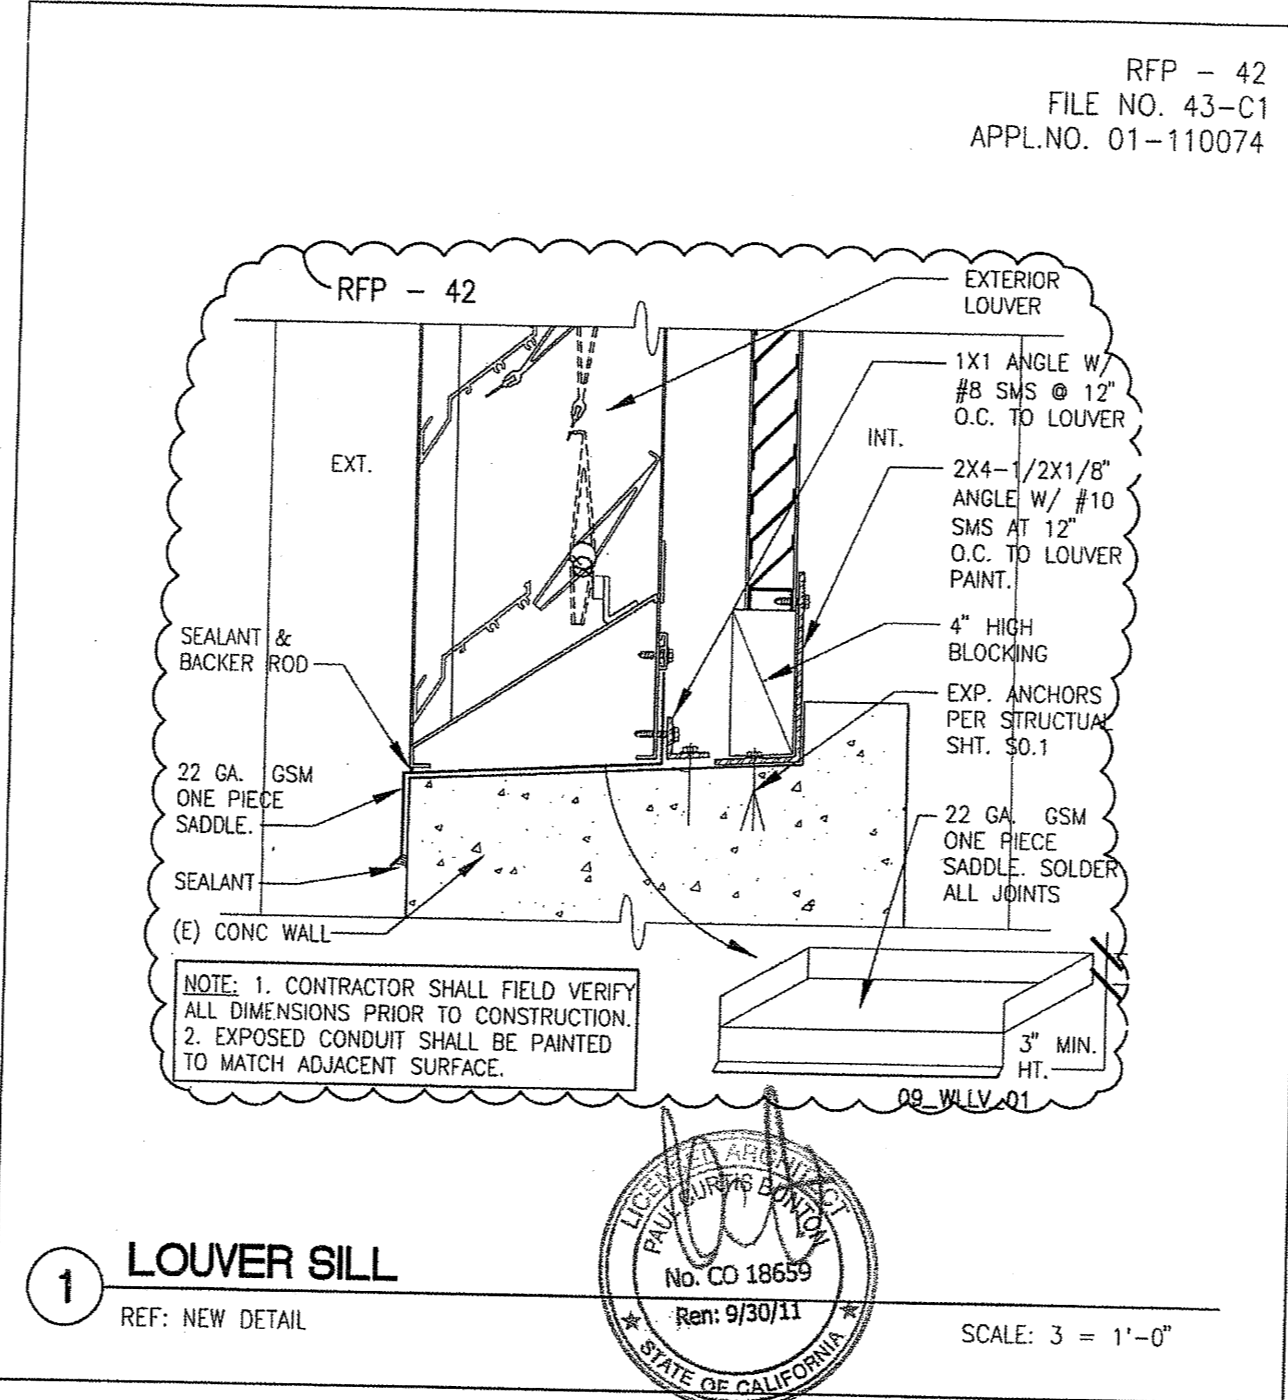

**1 LOUVER SILL**  
REF: NEW DETAIL  
SCALE: 3" = 1'-0"

<b>BCA</b> architecture planning interiors	File: LOUVER DETAILS Project Name: CANADA COLLEGE - BUILDINGS 5 & 6 RENOVATIONS SAN MATEO COUNTY COMMUNITY COLLEGE DISTRICT FILE NO. 43-C1 APPL. 01-110074 4200 FARM HILL BOULEVARD REDWOOD CITY, CA 94061	Date: 10.18.2010 Scale: AS NOTED Project Number: ASK-21A Sheet: 0703
---	---	---


RFP42

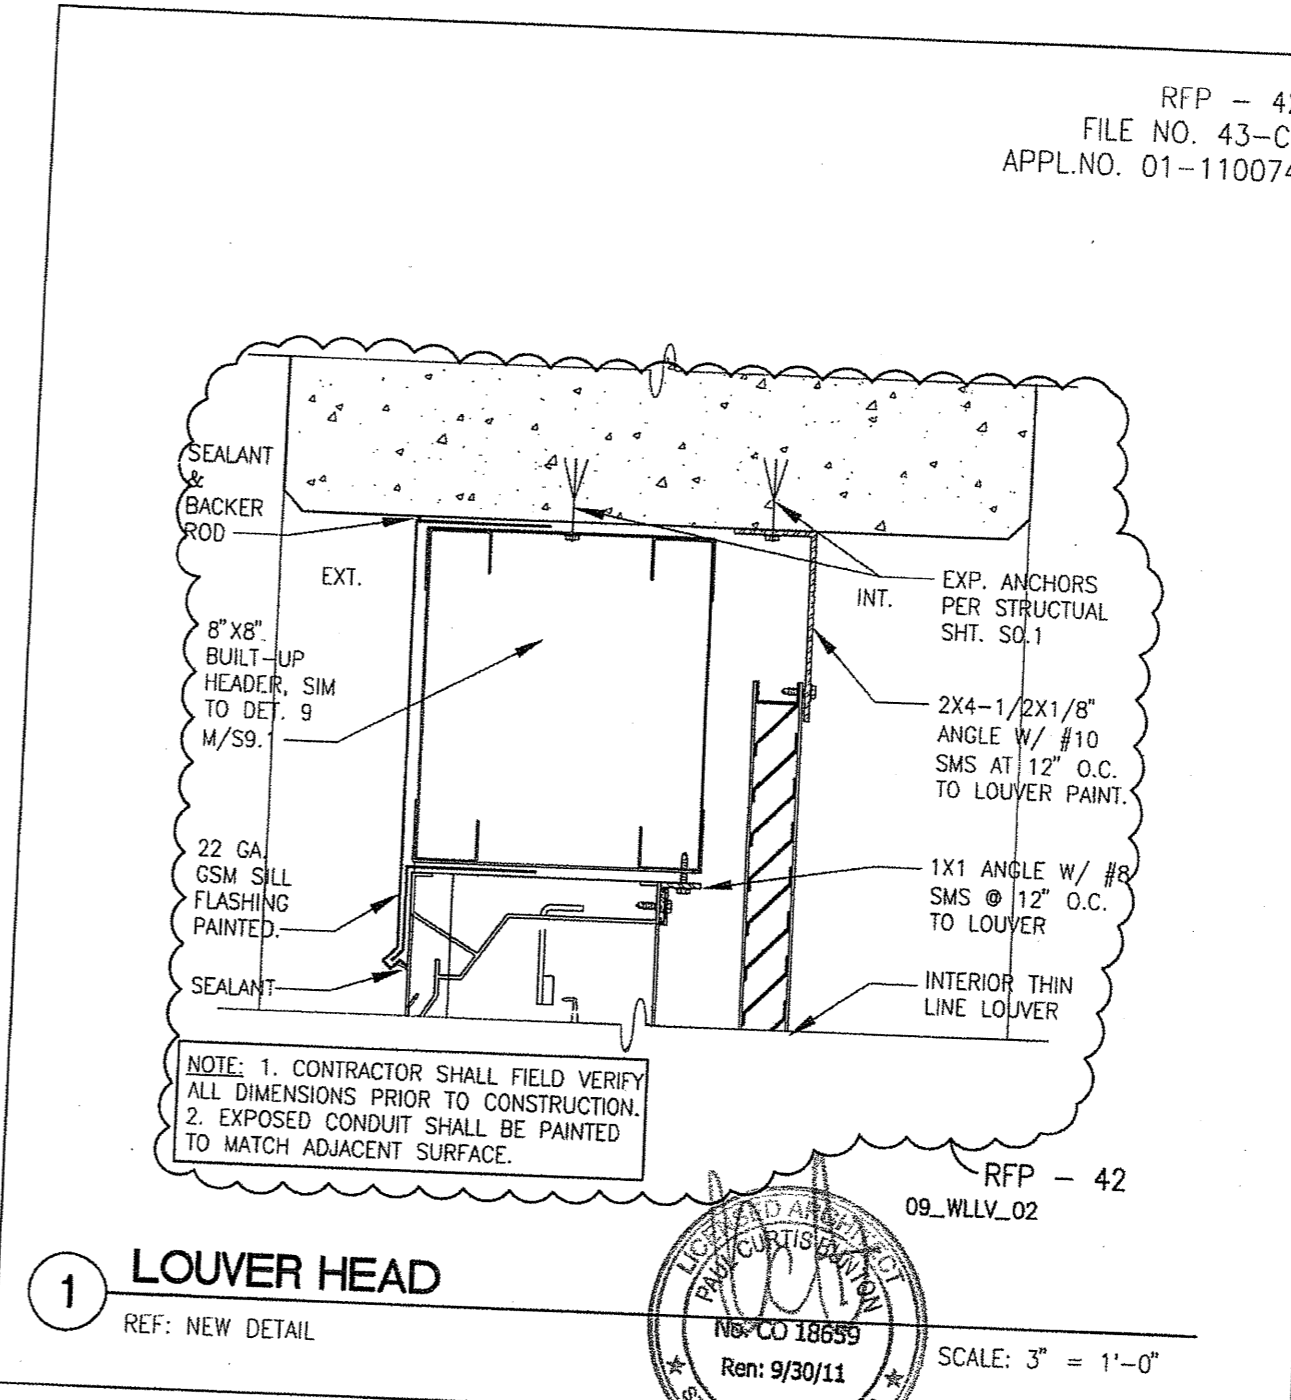

**1 LOUVER HEAD**  
REF: NEW DETAIL  
SCALE: 3" = 1'-0"

<b>BCA</b> architecture planning interiors	File: LOUVER DETAILS Project Name: CANADA COLLEGE - BUILDINGS 5 & 6 RENOVATIONS SAN MATEO COUNTY COMMUNITY COLLEGE DISTRICT FILE NO. 43-C1 APPL. 01-110074 4200 FARM HILL BOULEVARD REDWOOD CITY, CA 94061	Date: 10.18.2010 Scale: AS NOTED Project Number: ASK-21B Sheet: 0703
---	---	---


RFP42

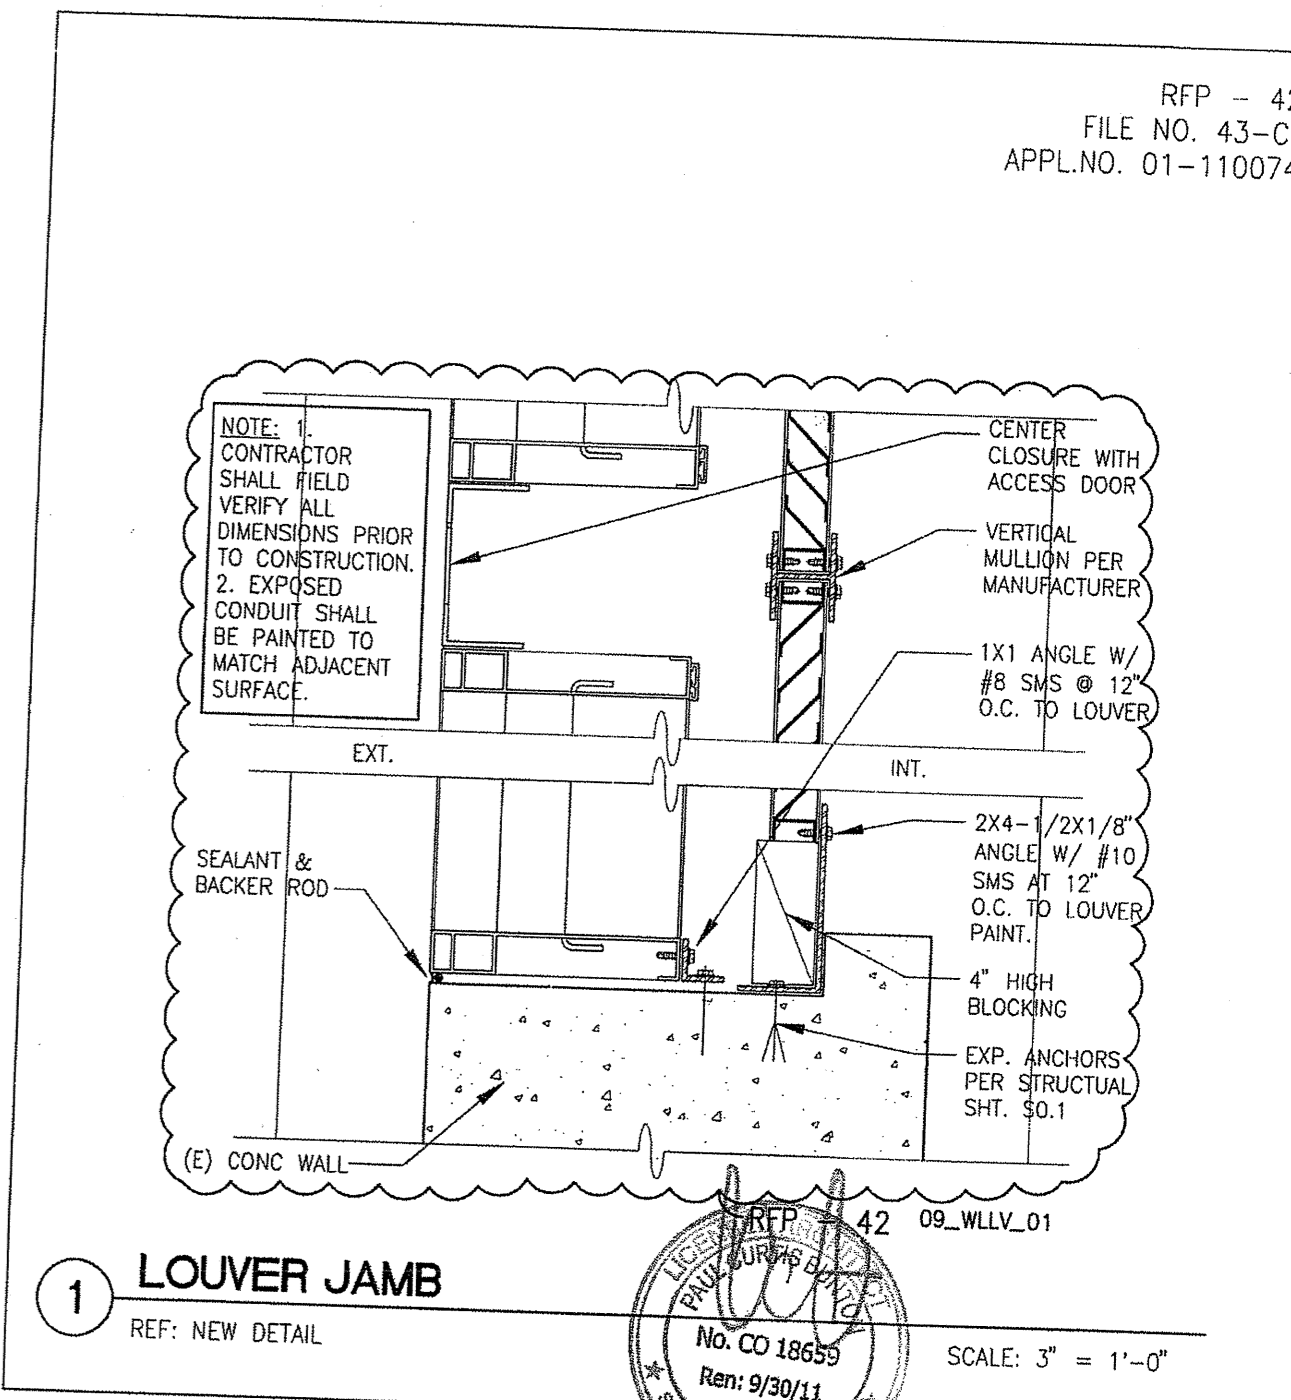

**1 LOUVER JAMB**  
REF: NEW DETAIL  
SCALE: 3" = 1'-0"

<b>BCA</b> architecture planning interiors	File: LOUVER DETAILS Project Name: CANADA COLLEGE - BUILDINGS 5 & 6 RENOVATIONS SAN MATEO COUNTY COMMUNITY COLLEGE DISTRICT FILE NO. 43-C1 APPL. 01-110074 4200 FARM HILL BOULEVARD REDWOOD CITY, CA 94061	Date: 10.18.2010 Scale: AS NOTED Project Number: ASK-21C Sheet: 0703
---	---	---

RFP 60

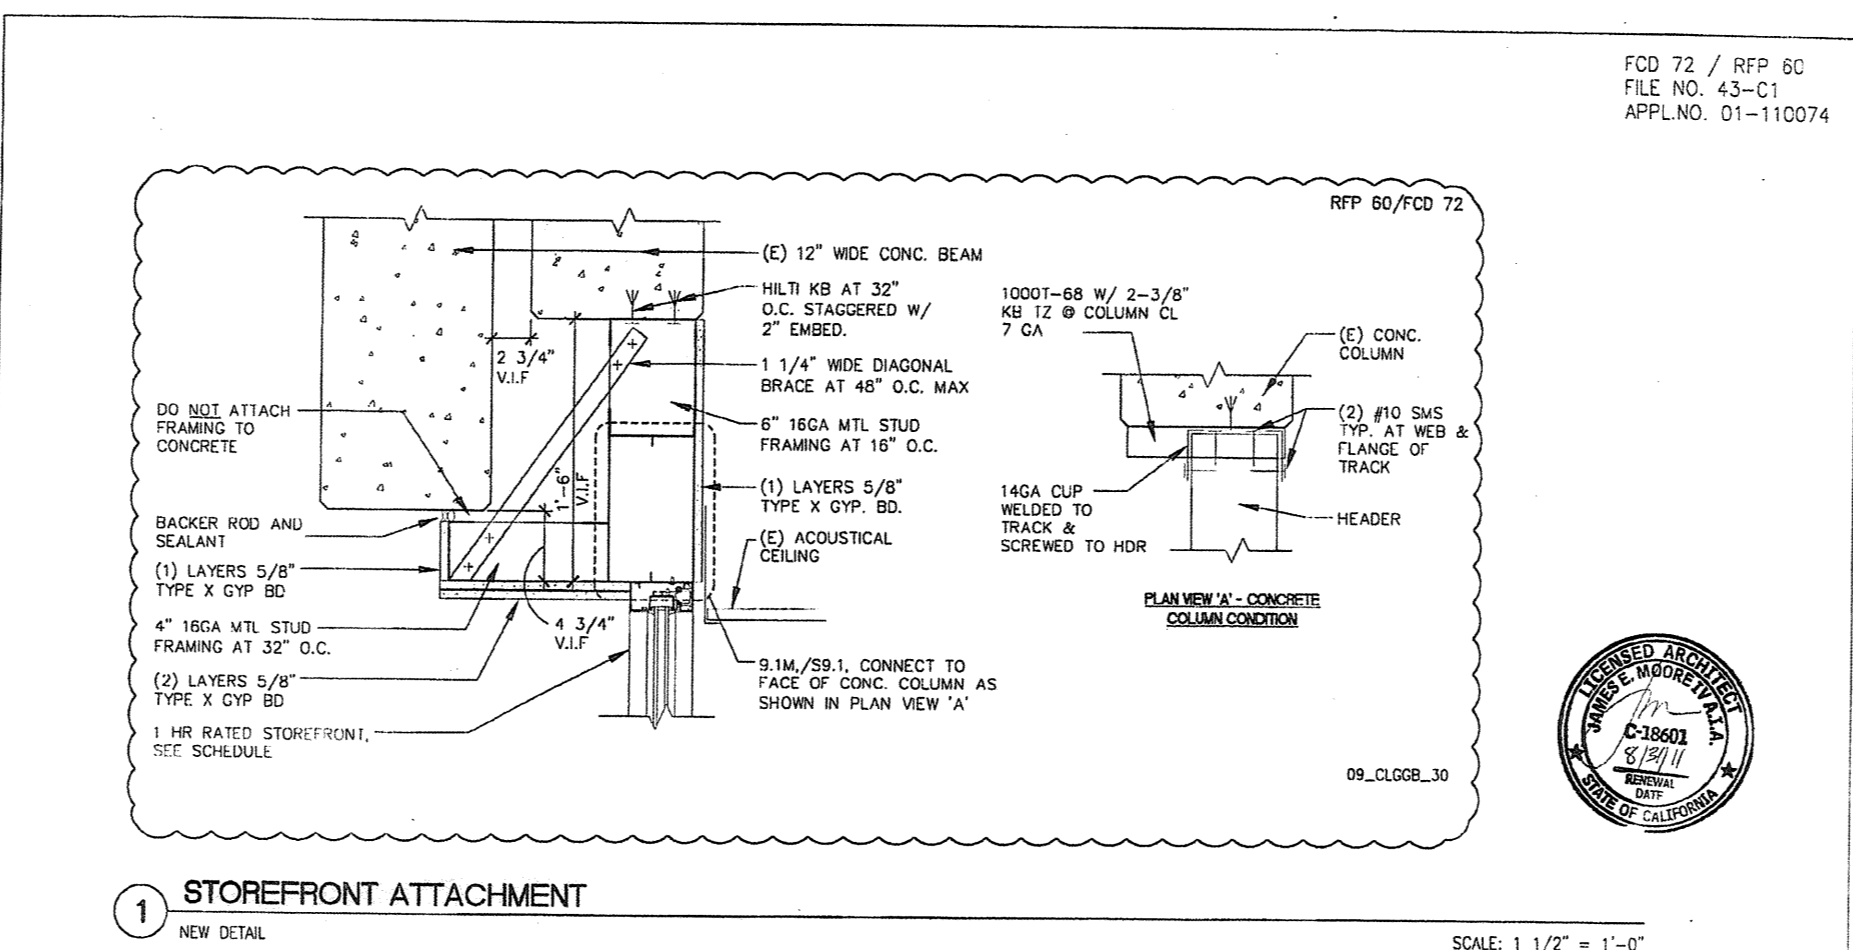

**1 STOREFRONT ATTACHMENT**  
REF: NEW DETAIL  
SCALE: 1 1/2" = 1'-0"

<b>BCA</b> architecture planning interiors	File: STOREFRONT 5-301, 5-302, AND 5-303 Project Name: CANADA COLLEGE - BUILDINGS 5 & 6 RENOVATIONS SAN MATEO COUNTY COMMUNITY COLLEGE DISTRICT FILE NO. 43-C1 APPL. 01-110074 4200 FARM HILL BOULEVARD REDWOOD CITY, CA 94061	Date: 10.18.2010 Scale: AS NOTED Project Number: ASK-34 Sheet: 0703
---	---	--