
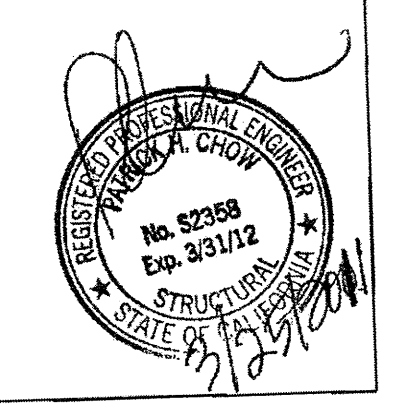


RFP-75

FILE NO. 43-C1  
APPL. NO. 01-110074

**TERRACE ROOF REPAIR NOTES**

1. SEE GENERAL NOTES ON SHEET SO.1
2. FOR INFILL OF OPENING USE NORMAL WEIGHT SANDED GROUT WITH COMPRESSION STRENGTH OF 5000 PSI MIN. PROVIDE W/C RATIO 0.49 OR LESS AND CONCRETE MIX SLUMP 4.5".
3. USE MECHANICAL COUPLERS PROVIDING 125% OF STRENGTH OF SPLICED BARS. USE BAR-LOCK COUPLERS PER EB-3064.
4. ROUGHEN ALL SURFACES TO RECEIVE NEW CONCRETE TO 1/4" AMPLITUDE. CLEAN THESE SURFACES. PROVIDE 10 DEGREES MIN SLOPE AROUND THE OPENING PERIMETER. APPLY BONDING AGENT.
5. SPECIAL INSPECTION IS REQUIRED DURING REBAR SPLICING.

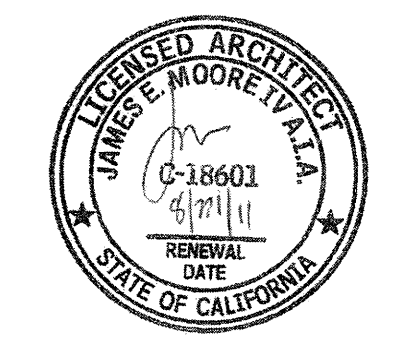

<b>BCA</b> <small>ARCHITECTURE PLANNING INTERIORS</small> <small>1100 California Street San Francisco, CA 94108 415.443.1000</small>	<small>Title</small> <b>EXHIBIT 30-LEVEL 3 TERRACE OPENING STRUCTURAL INFILL</b>	<small>Revision</small> <b>S5.3</b>	
	<small>Project Name</small> <b>CANADA COLLEGE - BUILDINGS 5 &amp; 6 RENOVATIONS SAN MATEO COUNTY COMMUNITY COLLEGE DISTRICT 4200 FARM HILL BOULEVARD REDWOOD CITY, CA 94061</b>	<small>Date</small> <b>03/29/11</b>	<small>Drawing Number</small> <b>SSK-15.0</b>
	<small>Project Number</small> <b>FILE NO. 43-C1 APPL. 01-110074</b>	<small>Scale</small> <b>NO SCALE</b>	<small>Project Number</small> <b>07013</b>
	<small>File No.</small> <b>FILE NO. 43-C1 APPL. 01-110074</b>	<small>Scale</small> <b>NO SCALE</b>	<small>Project Number</small> <b>07013</b>