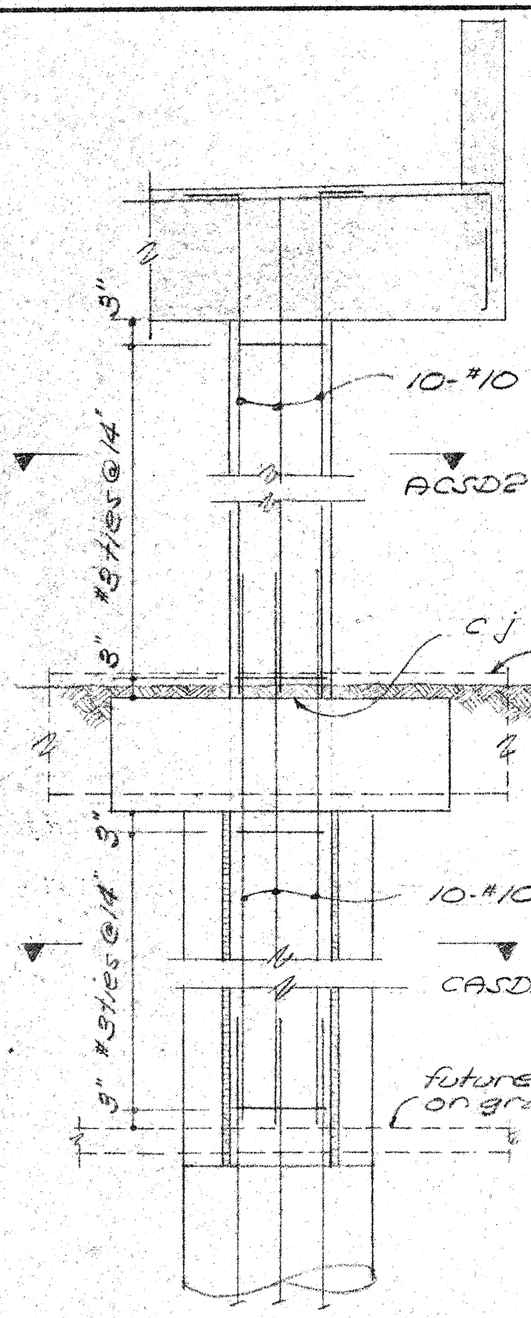

For bal & details not shown see ASD2

ASD2 REVISED

DSD102

1/2" = 1'-0"

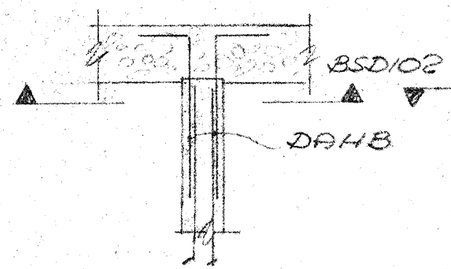

PLAN

CSD102

3/8" = 1'-0"

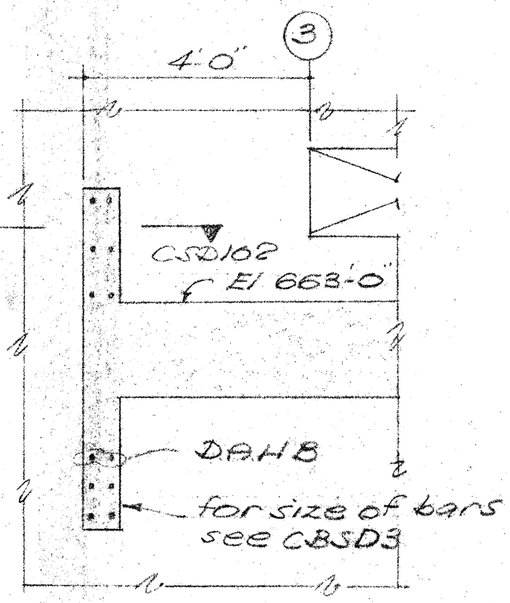

For bal & details not shown see CASD11

CASD11 REVISED

BSD102

3/8" = 1'-0"

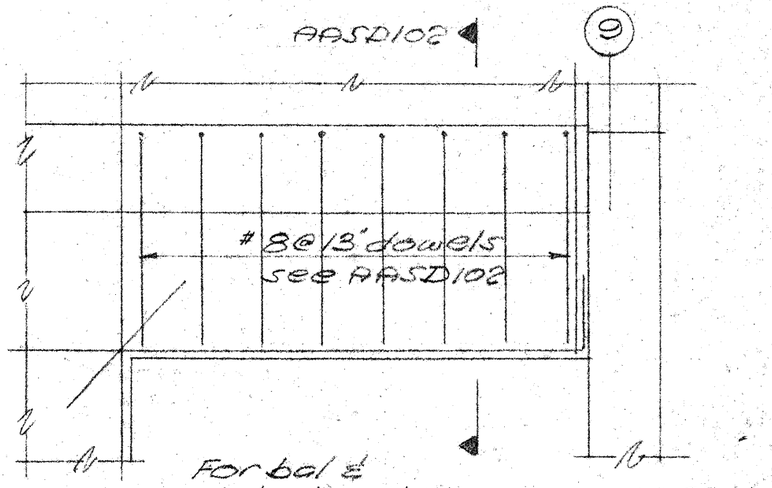

For bal & details not shown see AASD11

AASD11 REVISED

ASD102

3/8" = 1'-0"

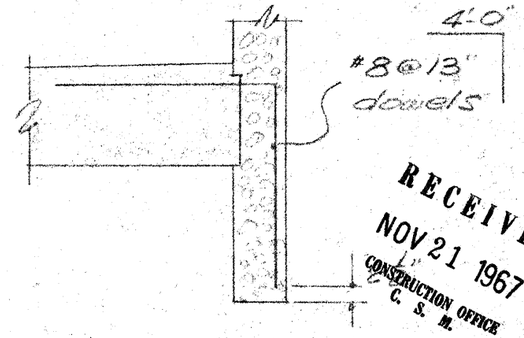

RECEIVED
NOV 21 1967
CONSTRUCTION OFFICE
C. S. M.

For bal. & details not shown see DSD12

DSD12 REVISED

AASD102

3/8" = 1'-0"

Tentative OK 11-21-67 cjc

STATE OF CALIFORNIA — DEPARTMENT OF GENERAL SERVICES
OFFICE OF ARCHITECTURE AND CONSTRUCTION

27746 APPROVED

BASD102

REVISION NOTES

At CASD11 change dimension at top of panel at line (1) from "1'-0 1/2" to "1'-2 1/2" "

At AASD11 change overall dimension of wall from "23'-4 3/4" " to "24'-5 3/4" ".

BUILDING D - PHYSICAL EDUCATION
COLLEGE OF SAN MATEO
SAN BRUNO CALIFORNIA

DATE		JOB NO.
11-8-67	JOHN CARL WARNECKE AND ASSOCIATES	1804
DRAWN	ARCHITECTS AND PLANNING CONSULTANTS	DWG NO.
H.H.	61 NEW MONTGOMERY ST. - SAN FRANCISCO	SD102

Posted 12-27 27746

PRINTED ON DIEPO NO. 1000R CLEARPRINT 3/67