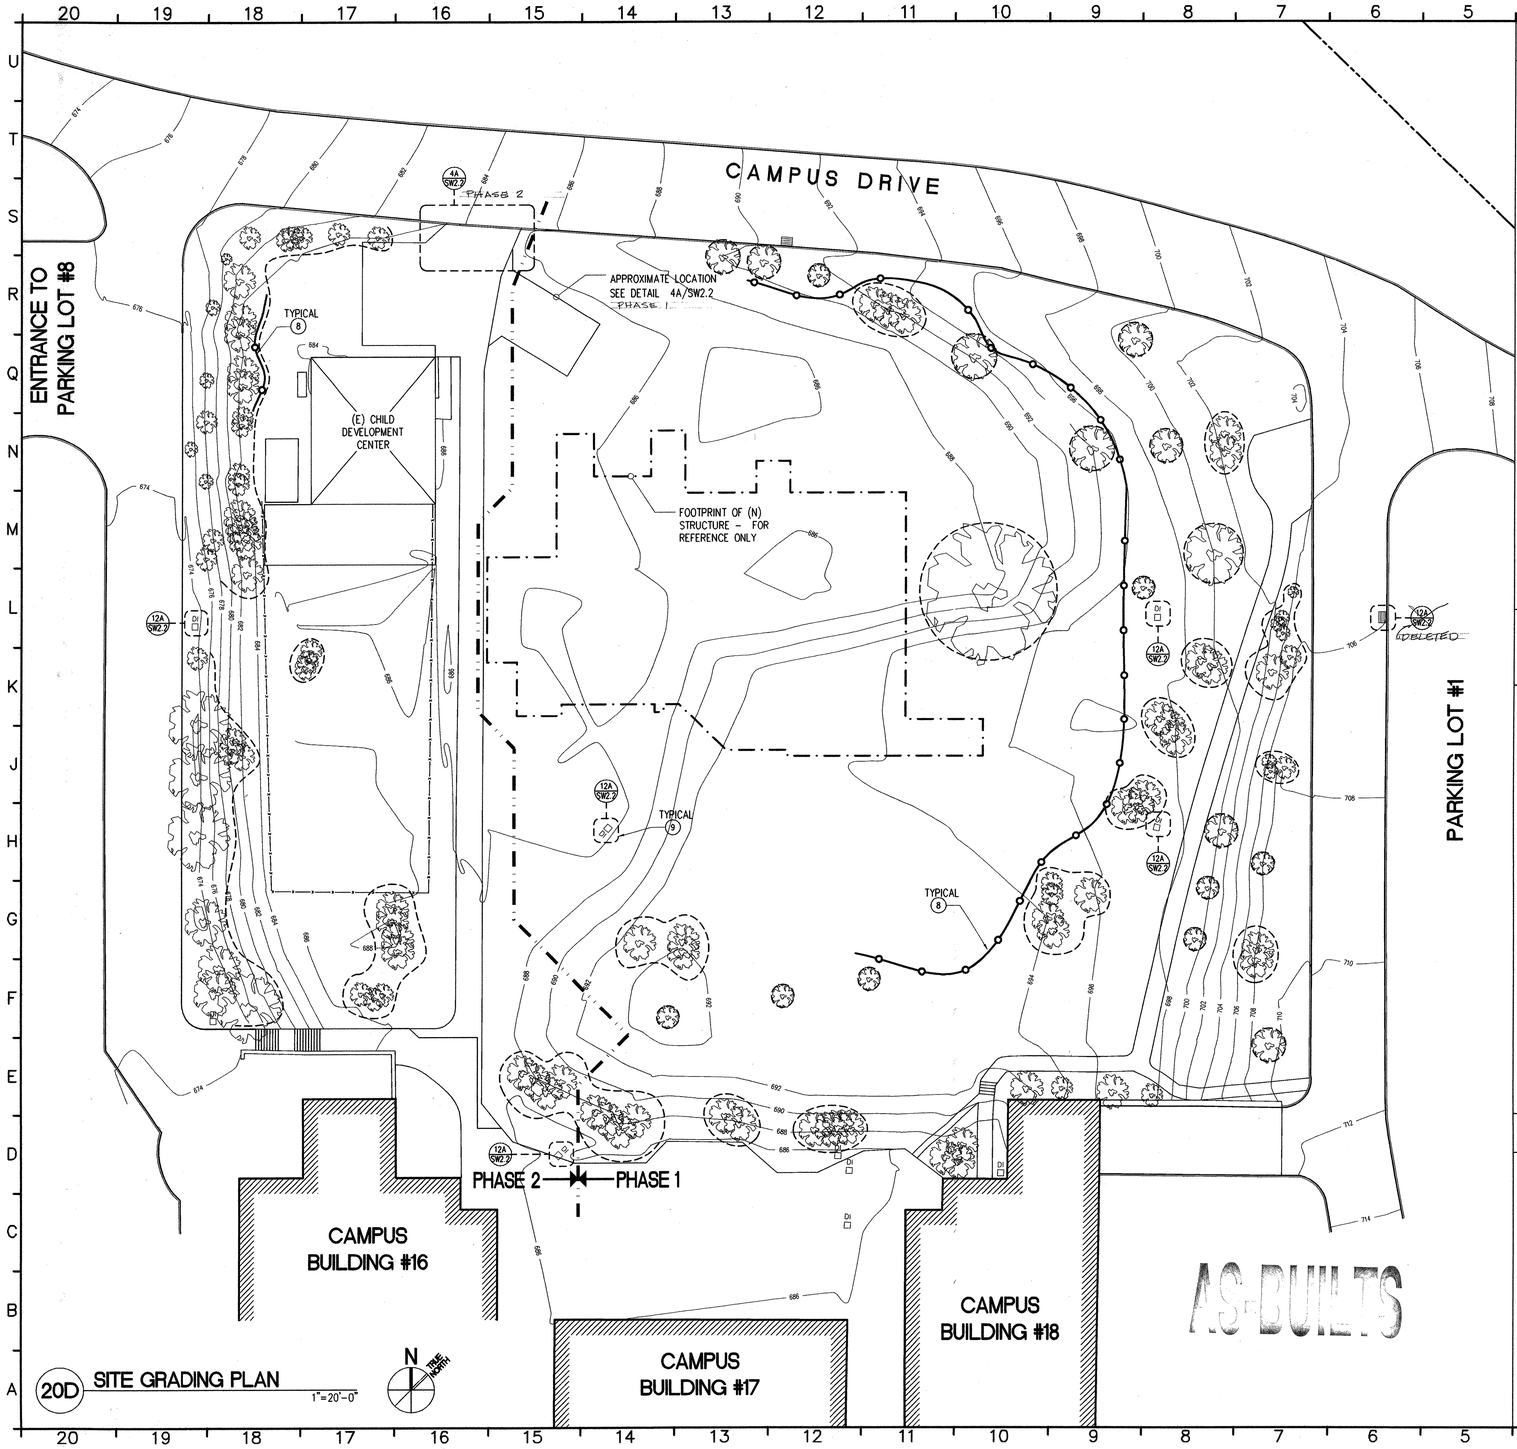

20D SITE GRADING PLAN
1"=20'-0"

EROSION CONTROL PLAN NOTES

1. CONTRACTOR IS RESPONSIBLE FOR ALL ASPECTS OF "EROSION CONTROL AND SEDIMENTATION CONTROL" AND SHALL INSTALL AND MAINTAIN ANY DEVICES AND MEASURES NECESSARY TO THE SATISFACTION OF THE INSPECTOR, DURING THE PERIOD OF OCTOBER 1 TO APRIL 15.

2. CONTRACTOR SHALL COMPLY WITH THE RULES, REGULATIONS AND SAFETY REQUIREMENTS OF THE U.S. FEDERAL OCCUPATIONAL SAFETY AND HEALTH ACT.

3. A STABILIZED CONSTRUCTION ENTRANCE SHALL BE INSTALLED PRIOR OT COMMENCEMENT OF GRADING, AS SHOWN ON THESE PLANS.

4. MATERIALS FOR EROSION CONTROL MEASURES SHALL BE STORED ON-SITE.

5. ALL EROSION CONTROL MEASURES SHALL BE PROMPTLY INSPECTED FOR DAMAGE FOLLOWING ALL RAIN STORMS. ANY DAMAGED ITEMS SHALL BE IMMEDIATELY REPAIRED OR REPLACED.

6. ALL GRADED OR DISTURBED AREAS SHALL BE PROTECTED BY TEMPORARY SEEDING, PERMANENT SEEDING, MULCHING OR OTHER SOIL STABILIZATION PRACTICES NO LATER THAN OCTOBER 15 AND/OR BEFORE THE RAINY SEASON BEGINS.

7. ALL GRADED OR DISTURBED AREAS THAT WILL BE IDLE DURING THE RAINY SEASON SHALL BE MULCHED AT THE MINIMUM RATE OF 2 TONS PER ACRE.

8. INSTALL SEDIMENT ROLL AS MAY BE REQUIRED TO CONTROL EROSION / SEDIMENT OFFSLOPE.

9. INSTALL DETAIL 12A/SW2.2 AT EXISTING AND NEW CATCH BASINS AS MAY BE REQUIRED TO KEEP C.B. CLEAN AND FREE OF SOIL AND DEBRIS.

CAMPUS ACCESS ROUTES, TOILET FACILITIES AND DRINKING FOUNTAIN

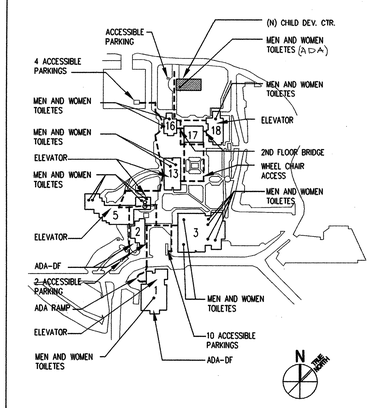

EROSION CONTROL PLAN LEGEND

APPROXIMATE LINE OF SEDIMENT ROLL - SEE DETAIL 8A/SW2.2

PROVIDE PROTECTIVE FENCE AT ALL (E) TREES TO REMAIN IN WORK AREA

REVISIONS: (△ INDICATES REVISIONS MADE TO THIS SHEET)

NO.:	DATE	REASON	BY

ISSUE FOR PROGRESS REVIEW	01/15/01
ISSUE FOR PLAN CHECK	01/25/01
ISSUE FOR FINAL REVIEW	05/09/01
ISSUE FOR BID	
ISSUE FOR CONSTRUCTION	

SEAL: LICENSED ARCHITECT BRIAN A. CIANFICHI No. C-23110 REN. 10-31-01 STATE OF CALIFORNIA

ARCHITECT: CONSULTANT:

CONSULTANT IDENTIFICATION STAMP
DIVISION OF THE STATE ARCHITECT
APPL.01 1035 29
AC WM FLS DD SS MT
DATE 5/9/01 Redate 5/21/01 MT

ARCHITECT:
CIANFICHI
ARCHITECTURE • PLANNING
30 ANNE COURT
WALNUT CREEK, CA. 94598
TEL.: (925) 256-8638
FAX.: (925) 256-8652

PROJECT:
CHILD DEVELOPMENT CENTER
CAÑADA COLLEGE
4200 FARM HILL BLVD.
REDWOOD CITY, CA 94061
SAN MATEO COUNTY COMMUNITY COLLEGE DISTRICT

STAMP:

APPL. NUMBER:

KEY PLAN:

AS-BUILT

SHEET TITLE:
EROSION CONTROL/ SITE PROTECT. PLAN

DRAWN BY: GL	PROJECT NO.: 304.99
CHECKED BY: BA	DATE: 01-25-2001
APPL NO.:	SHEET: SW0.1
DATA NO.:	NO.: OF: