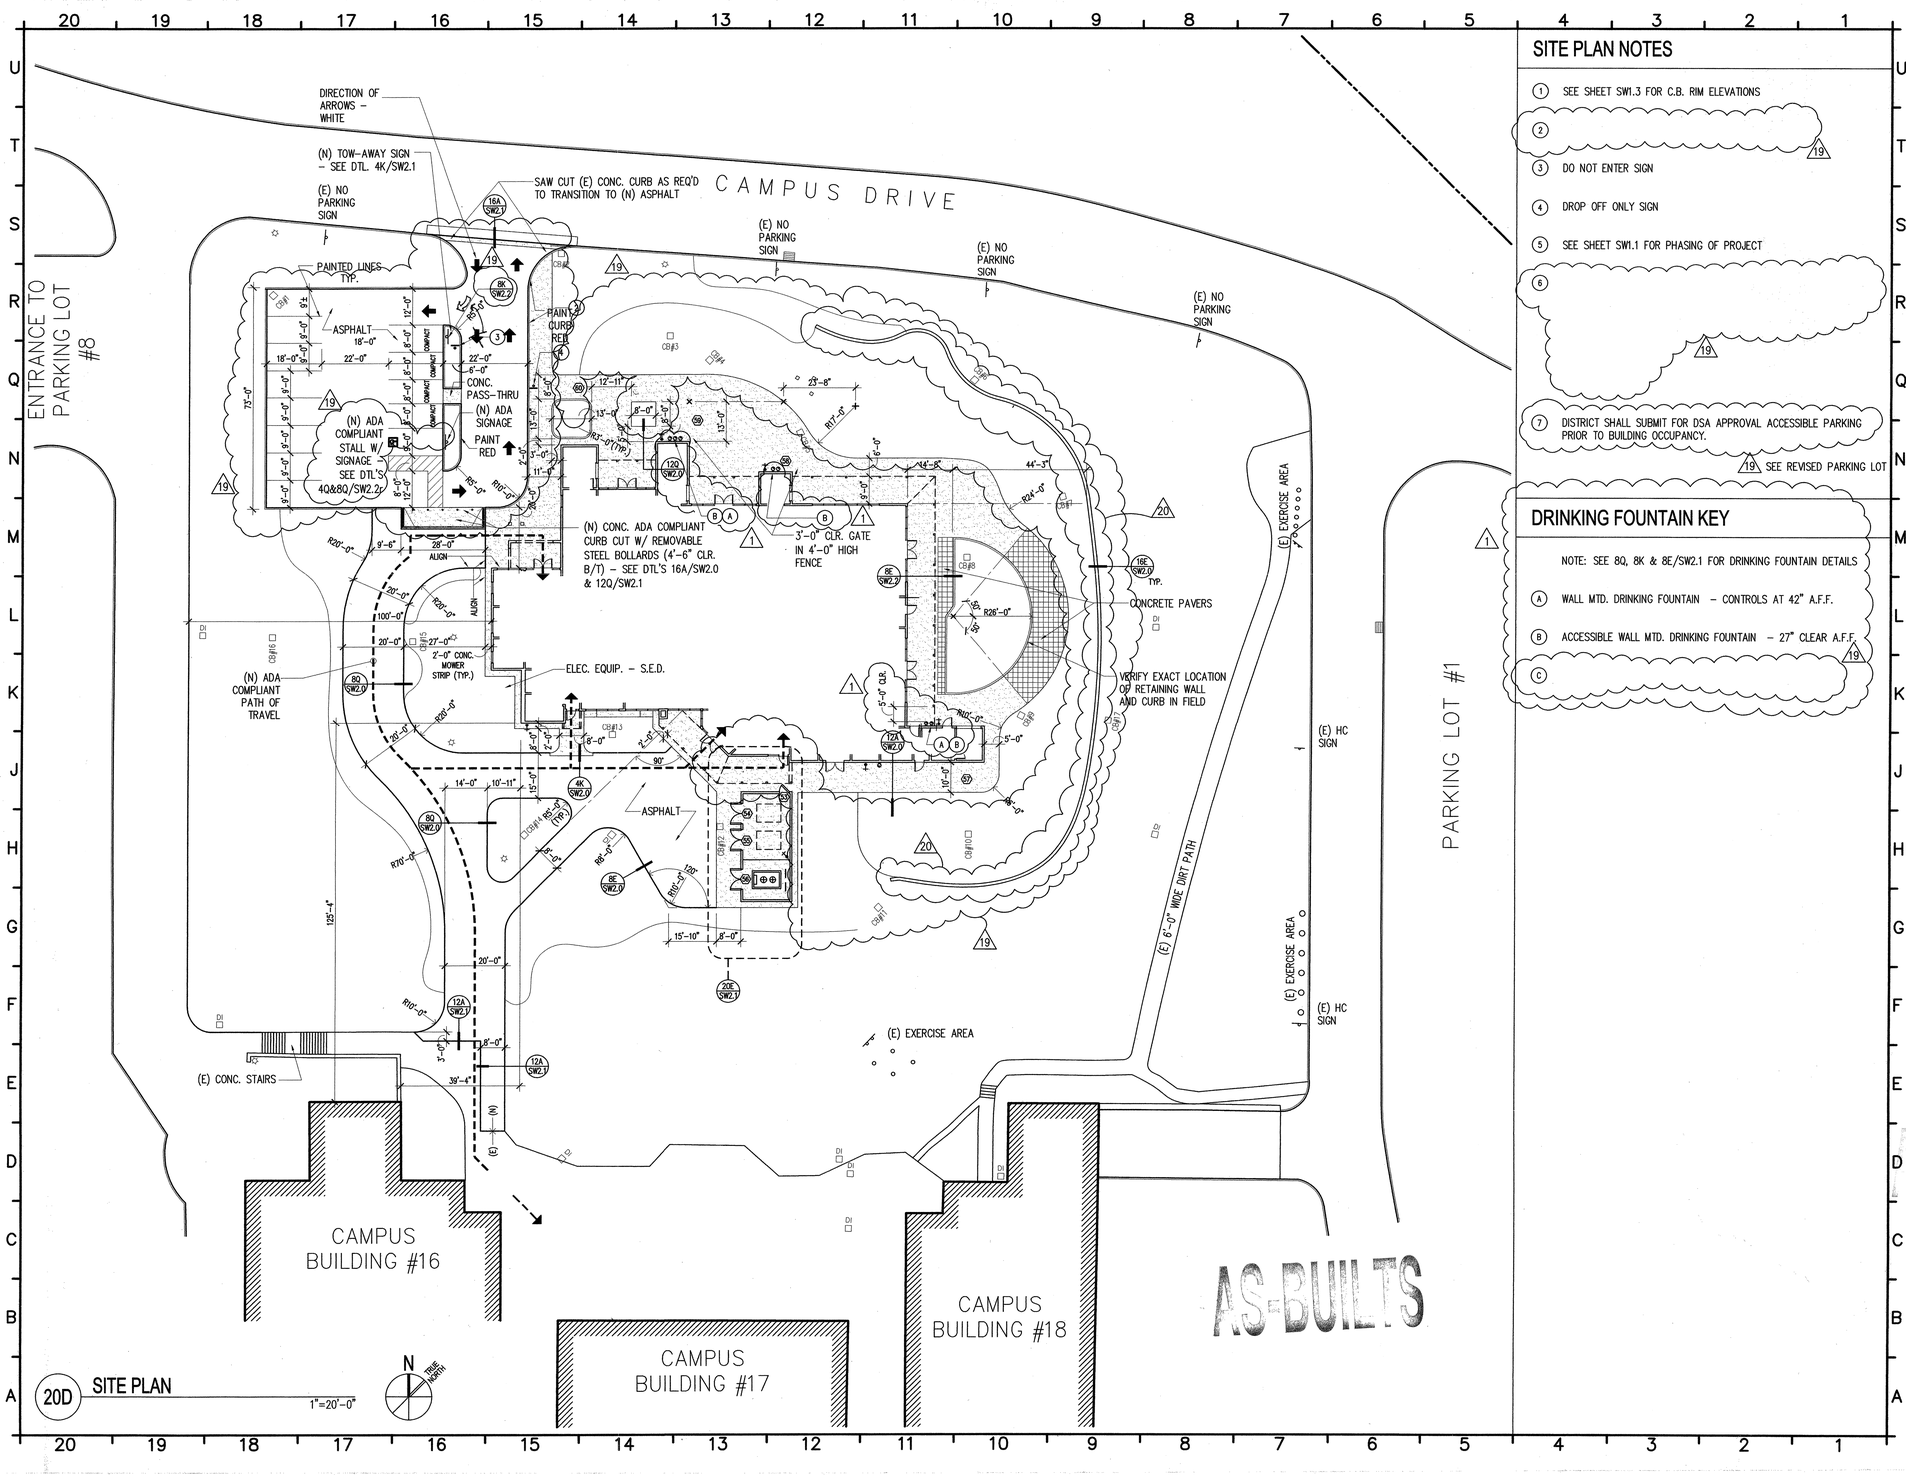

SITE PLAN NOTES

1. SEE SHEET SW1.3 FOR C.B. RIM ELEVATIONS
2. 19
3. DO NOT ENTER SIGN
4. DROP OFF ONLY SIGN
5. SEE SHEET SW1.1 FOR PHASING OF PROJECT
6. 19
7. DISTRICT SHALL SUBMIT FOR DSA APPROVAL ACCESSIBLE PARKING PRIOR TO BUILDING OCCUPANCY.

19 SEE REVISED PARKING LOT

DRINKING FOUNTAIN KEY

NOTE: SEE 8Q, 8K & 8E/SW2.1 FOR DRINKING FOUNTAIN DETAILS

A WALL MTD. DRINKING FOUNTAIN – CONTROLS AT 42" A.F.F.

B ACCESSIBLE WALL MTD. DRINKING FOUNTAIN – 27" CLEAR A.F.F. 19

C

REVISIONS: △ INDICATES REVISIONS MADE TO THIS SHEET

NO.	DATE	REASON	BY
1	10/15/01	ADDENDUM#1	
2	10/26/01	ADDENDUM#2	
5	02/28/03	ADDENDUM#2	
19	3/17/03	CR #19	
20	5/20/03	CR #20	

ISSUE FOR PROGRESS REVIEW	01/15/01
ISSUE FOR PLAN CHECK	01/25/01
ISSUE FOR FINAL REVIEW	05/09/01
ISSUE FOR BID	
ISSUE FOR CONSTRUCTION	

SEAL: LICENSED ARCHITECT ROBERT A. CIANFICHI No. C-5310 REN. 10-31-03 STATE OF CALIFORNIA

ARCHITECT: CONSULTANT:

CONSULTANT:

ARCHITECT:
CIANFICHI
ARCHITECTURE • PLANNING
30 ANNE COURT
WALNUT CREEK, CA. 94598
TEL.: (925) 256–8636
FAX.: (925) 256–8652

PROJECT:
CHILD DEVELOPMENT CENTER
CAÑADA COLLEGE

4200 FARM HILL BLVD.
REDWOOD CITY, CA 94061

SAN MATEO COUNTY COMMUNITY COLLEGE DISTRICT

STAMP:
APPROVED
DIV. OF THE STATE ARCHITECT
AO AG F/LS EB SS SC
APPL NO. 103529 DATE 6/16/03

APPL. NUMBER:

KEY PLAN:

AS-BUILTS

SHEET TITLE:
SITE PLAN

DRAWN BY: GL	PROJECT NO.: 304.99
CHECKED BY: BA	DATE: 03/17/03
APPL NO.:	SHEET: SW1.2r
DATA NO.:	NO.: OF: