## Legend:

CEILING CLEARED

CEILING CLEARED
FLOOR REPLACED
WALLS PAINTED

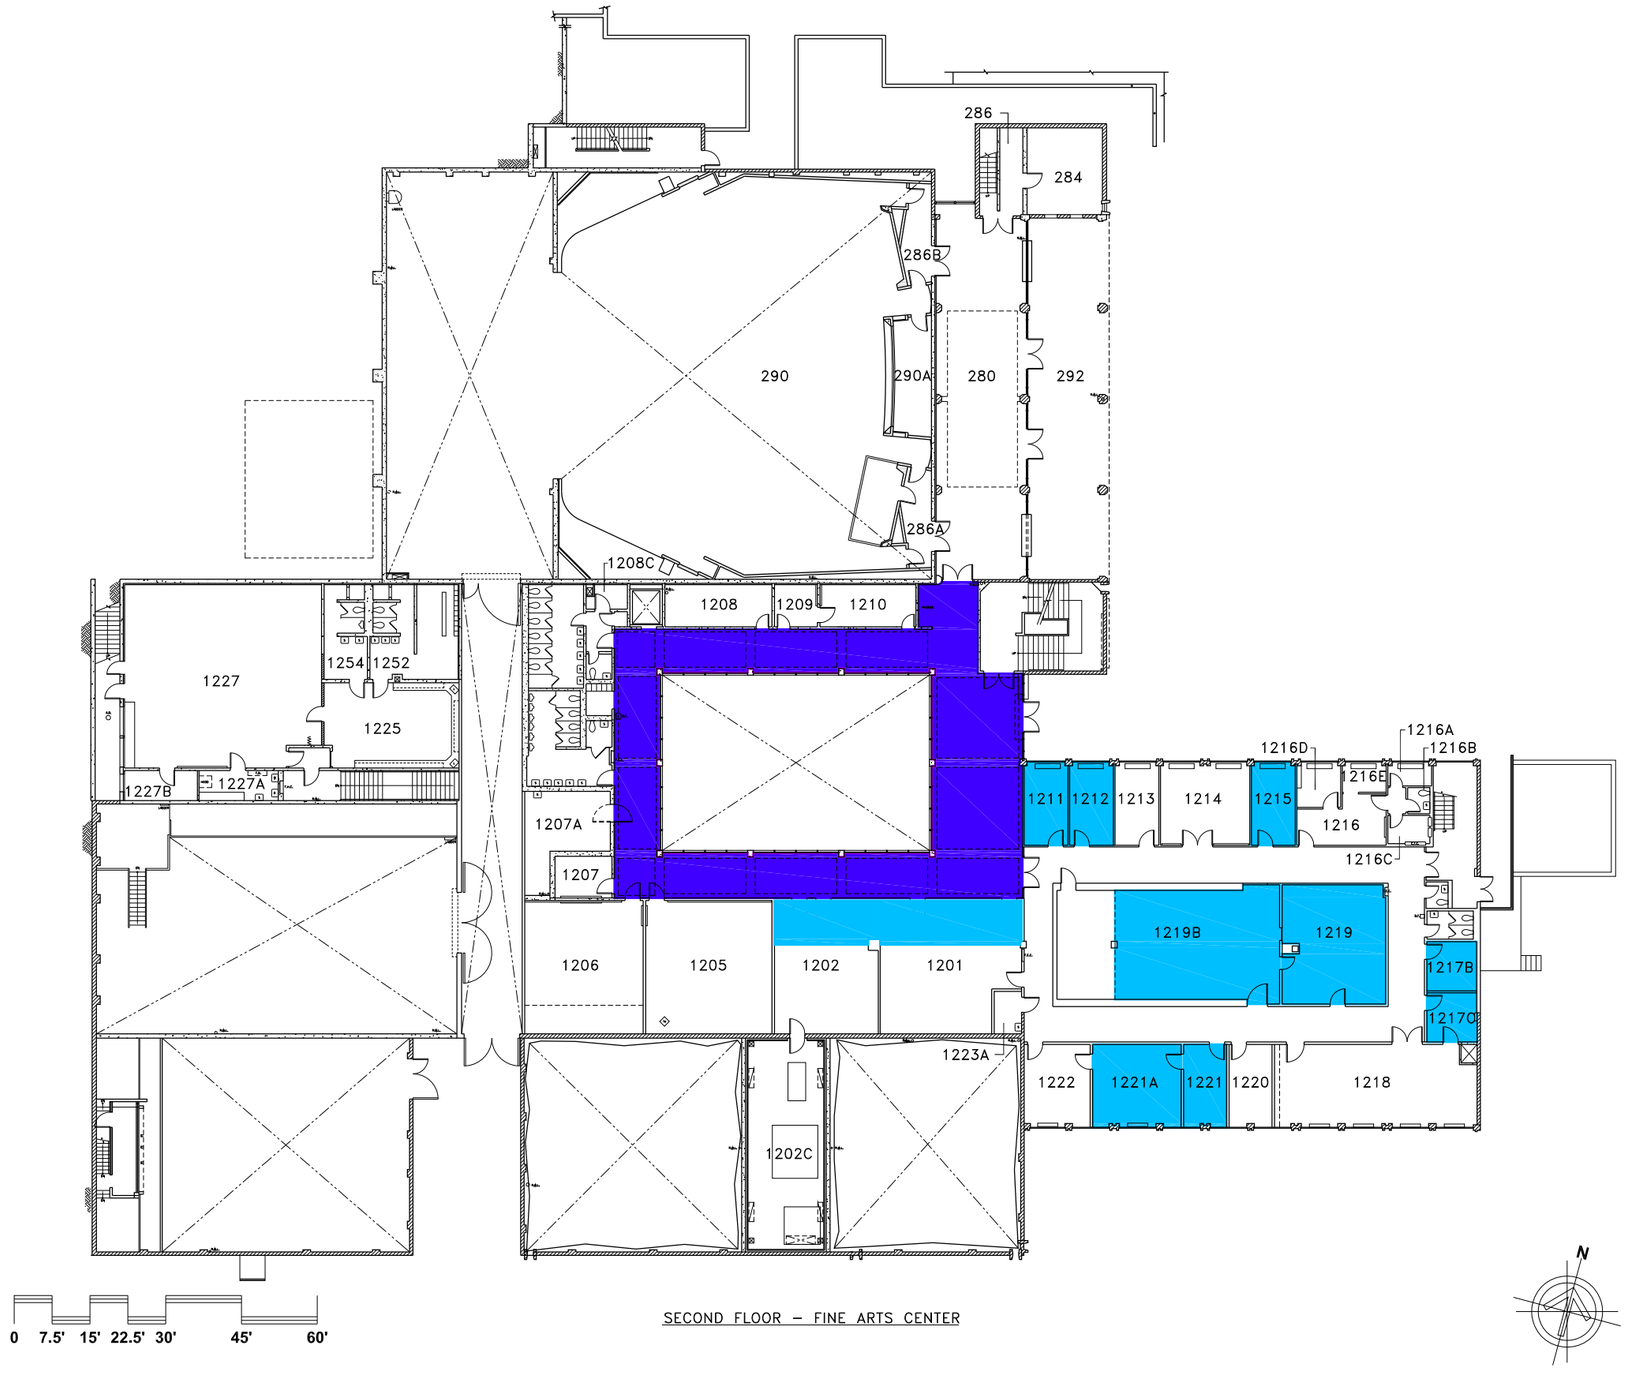


# Skyline Community College - Building 1, Second Floor

## Field Survey of (E) Modifications - Sheet 2/3

## 4/07/08