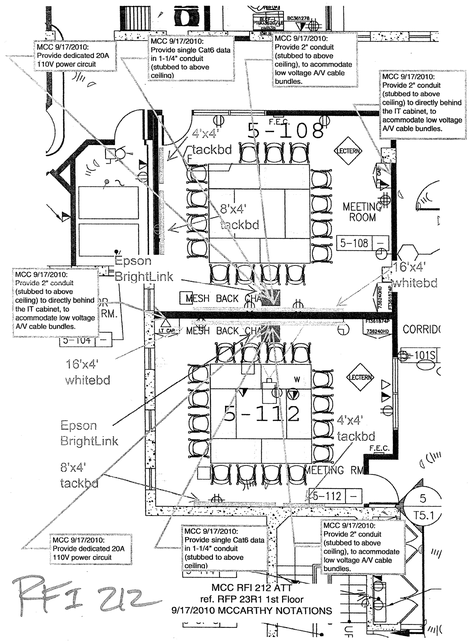

RFI 37

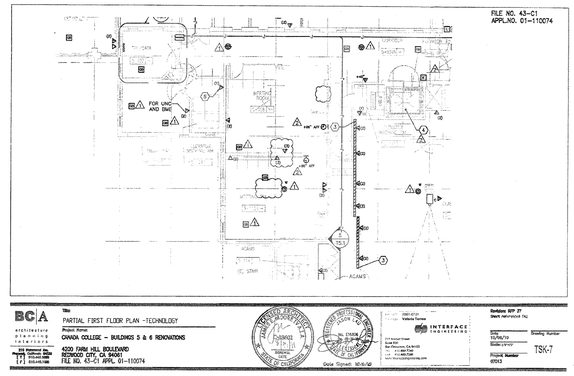

RFP-36

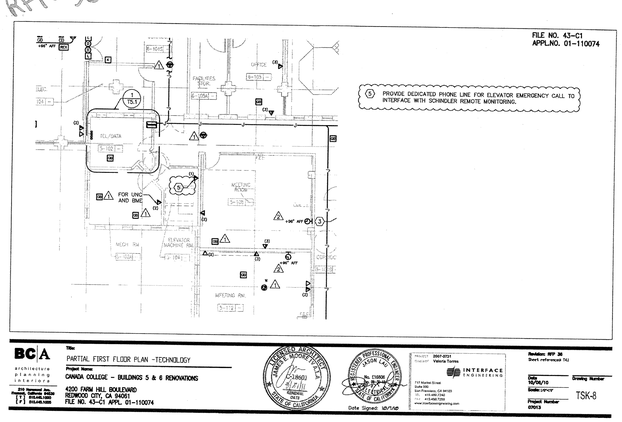
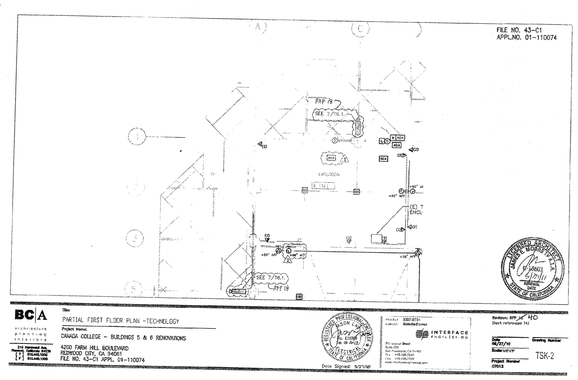
RFP-40