

REMARKS	DATE
ADDENDUM NO. 1	08/18/08
ADDENDUM NO. 2	11/06/09

DRAWING STATUS	DATE
DSA PLAN CHECK	08/28/08
DSA BACK CHECK	01/22/09
RFICING (REV. 08/28/08)	08/18/08
CONSTRUCTION	

FILE NO. 41-C1
IDENTIFICATION STAMP
DIV. OF THE STATE ARCHITECT
01-110074
AC: _____ FLS: _____ SS: _____
DATE: _____

BUILDINGS 5 & 6 RENOVATIONS

San Mateo County Community College District

BID ADDENDA


APPROVED BY THE STATE ARCHITECT
AC 11/18/08 FILE NO. 08-SS-10
APPL. NO. 110674 DATE 5/12/10

CAÑADA COLLEGE
4200 FARM HILL BOULEVARD
REDWOOD CITY, CA 94061

TECHNOLOGY - FIRST FLOOR

SHEET KEYNOTES

- PULL BACK (E) BACKBONE CABLES GOING TO THIS TELECOM ENCLOSURE AND REDIRECT THEM TO THE (N) TRS.1 (ROOM 5-102).
- PROVIDE SPEAKER SELECTION SWITCH ALLOWING ROOMS 6-101 AND 6-102 TO BE CONTROLLED SEPARATELY OR ALL TOGETHER.
- SEE DETAIL 6/TS.1.
- PROVIDE KEYPAD/CARD READER IN ELEVATOR CAR FOR AFTER HOURS USE.

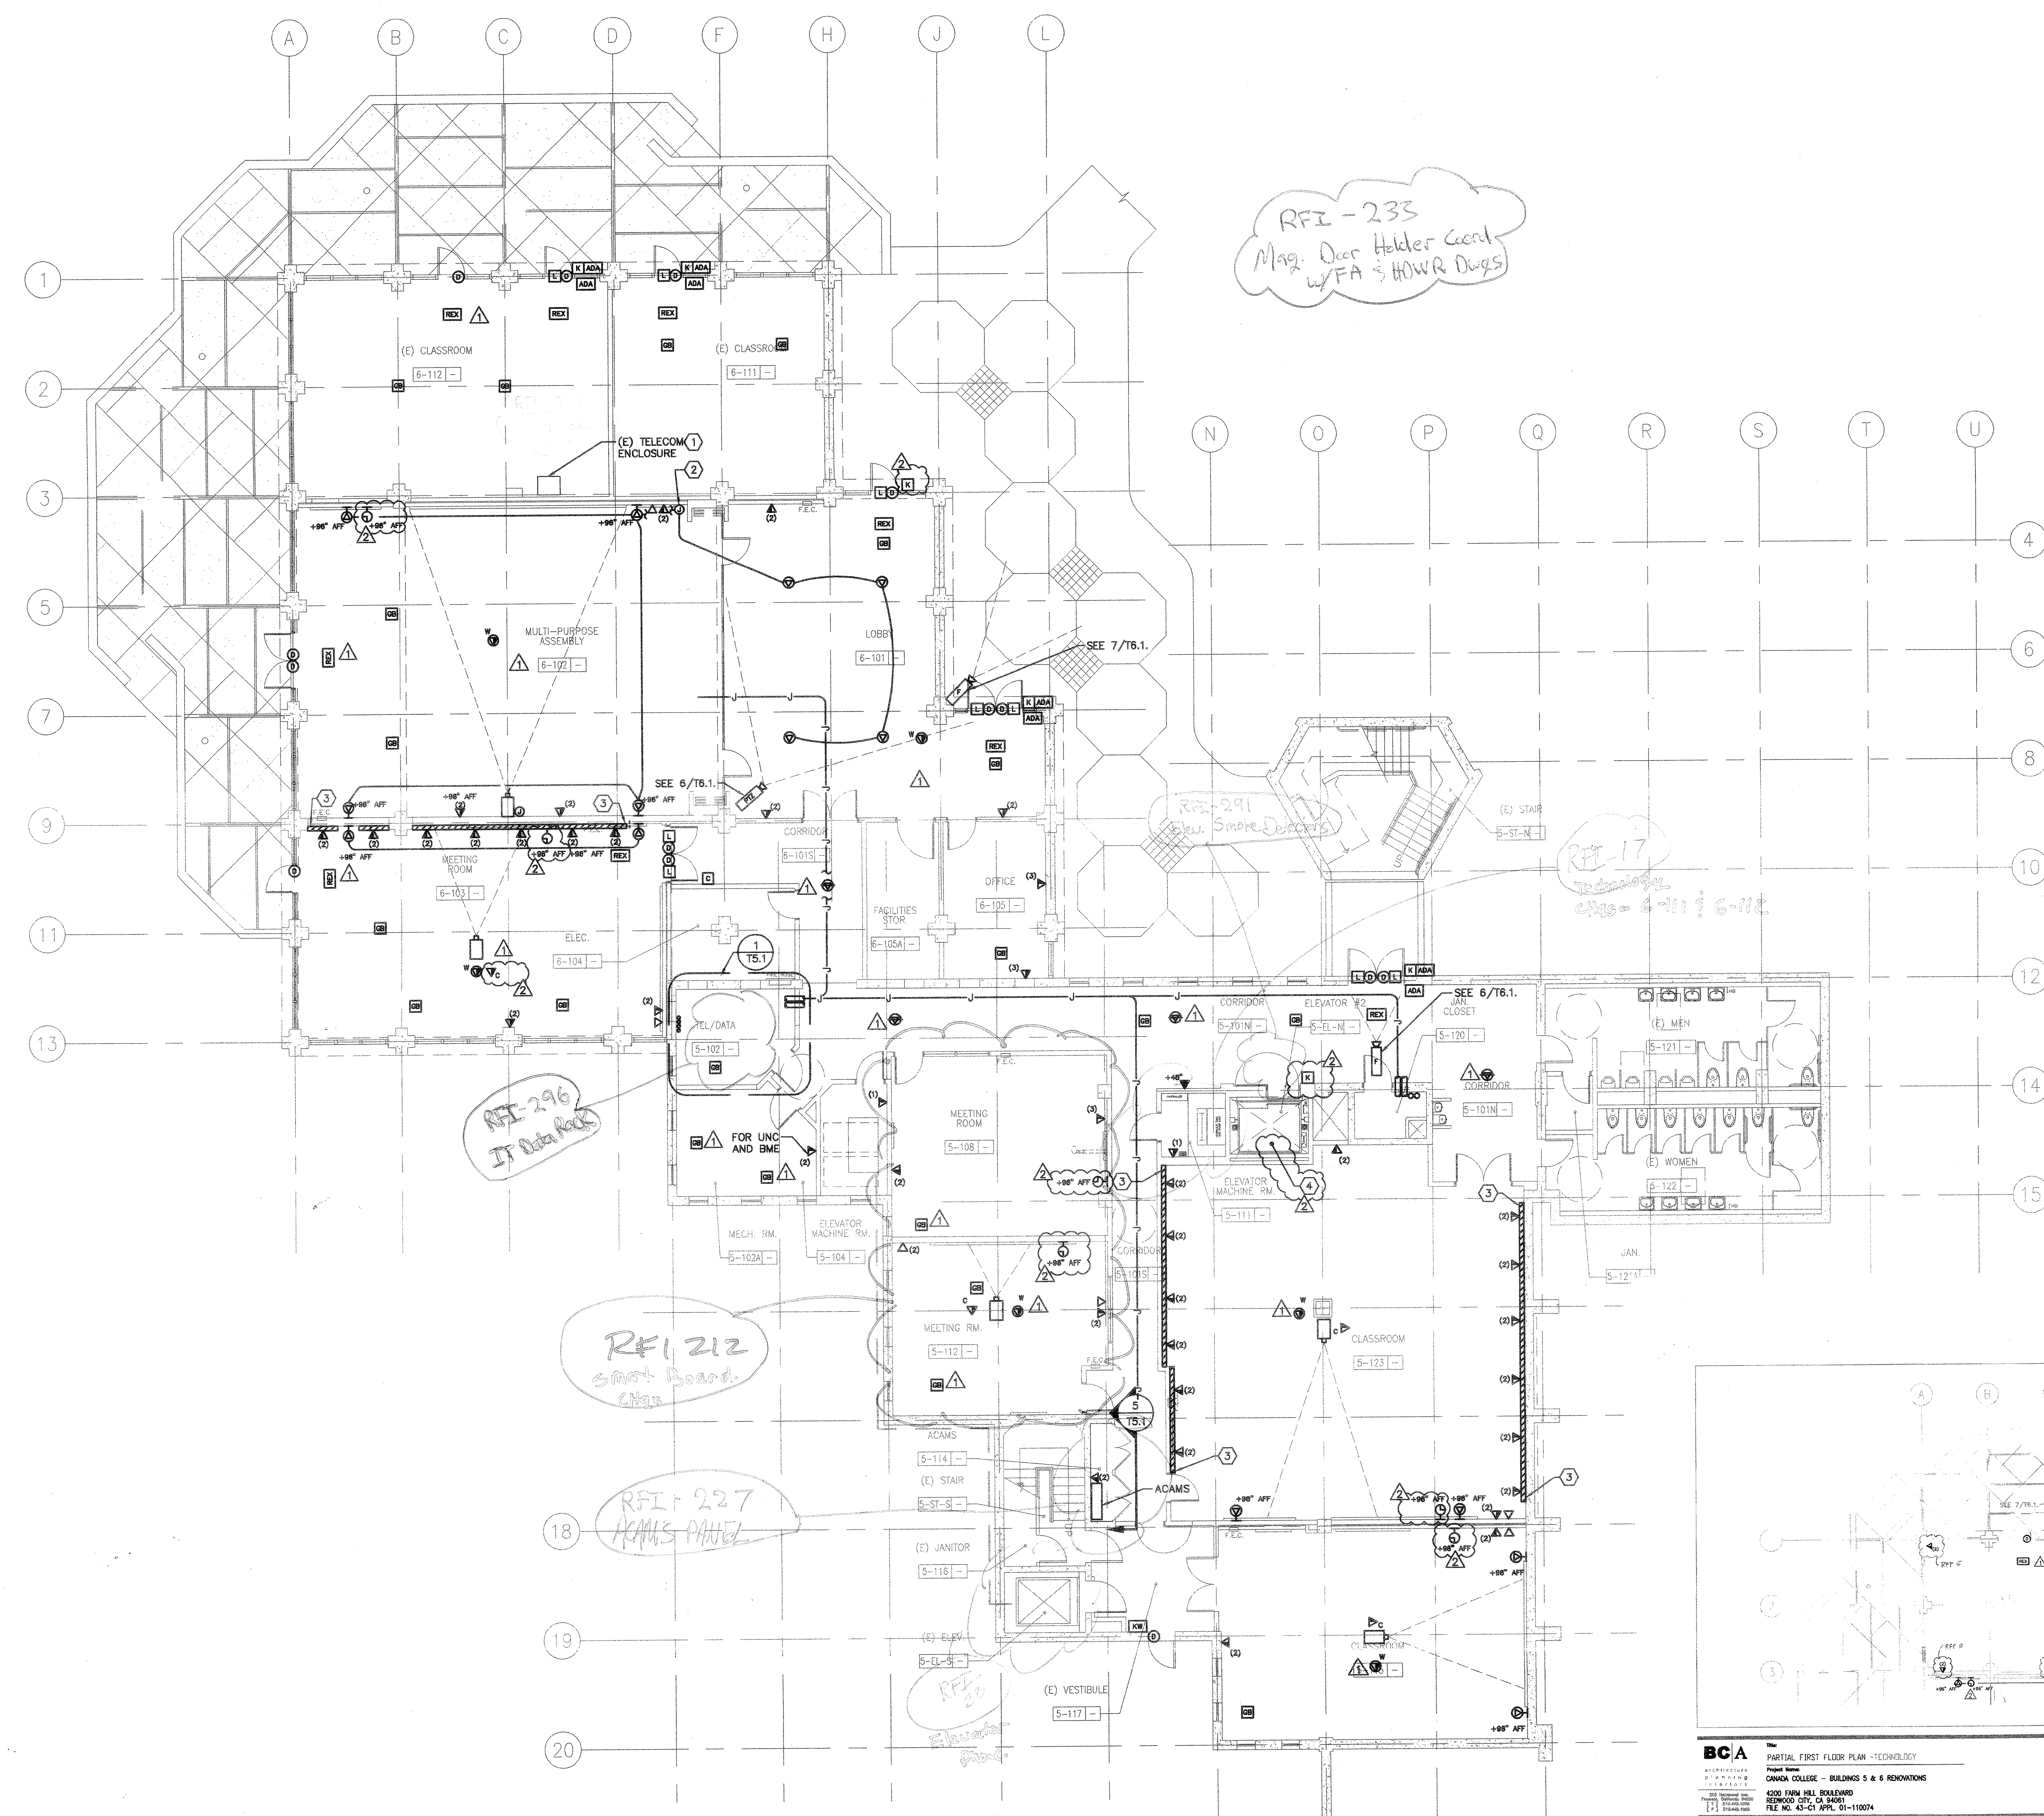

1 TECHNOLOGY - FIRST FLOOR
SCALE: 1/8"=1'-0"

