


RFP-40

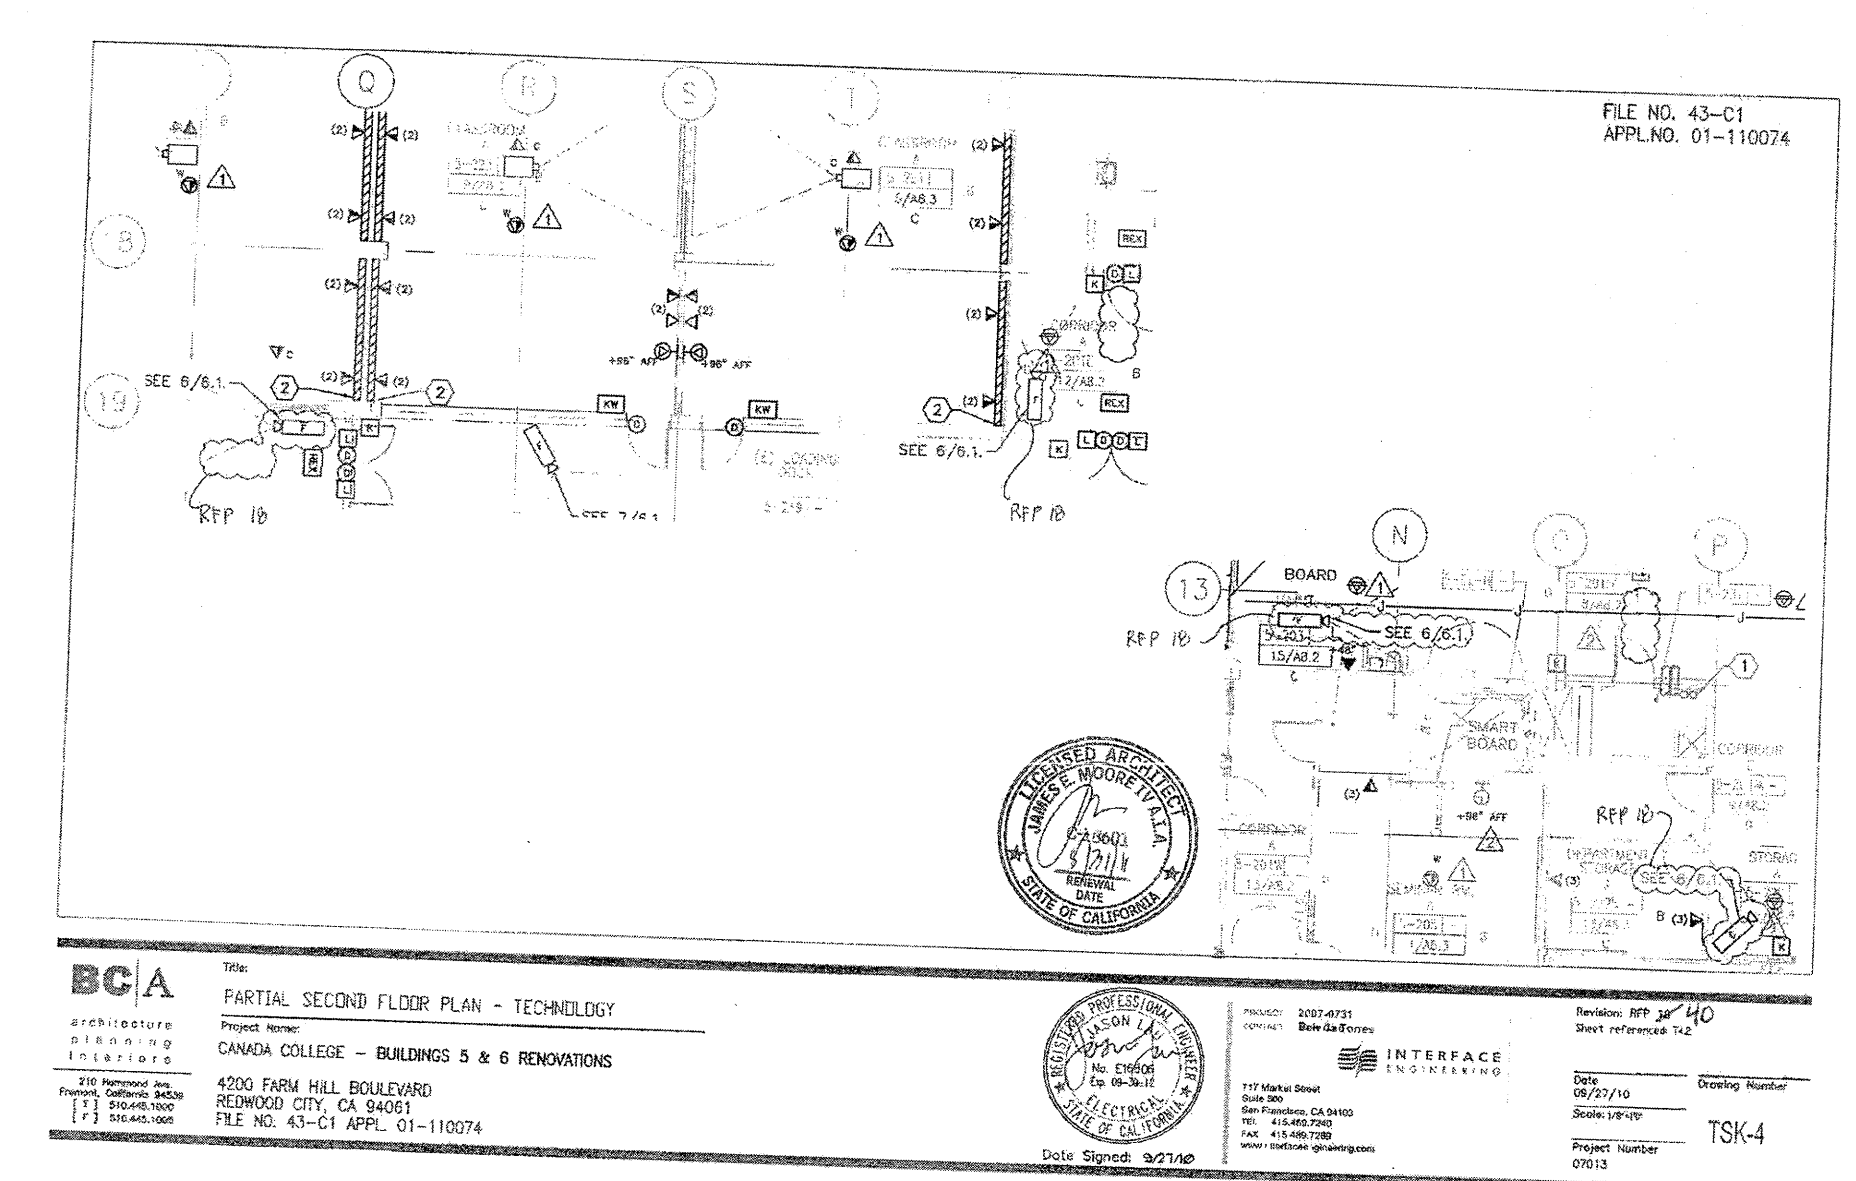

RFP-48

