




RFP-29

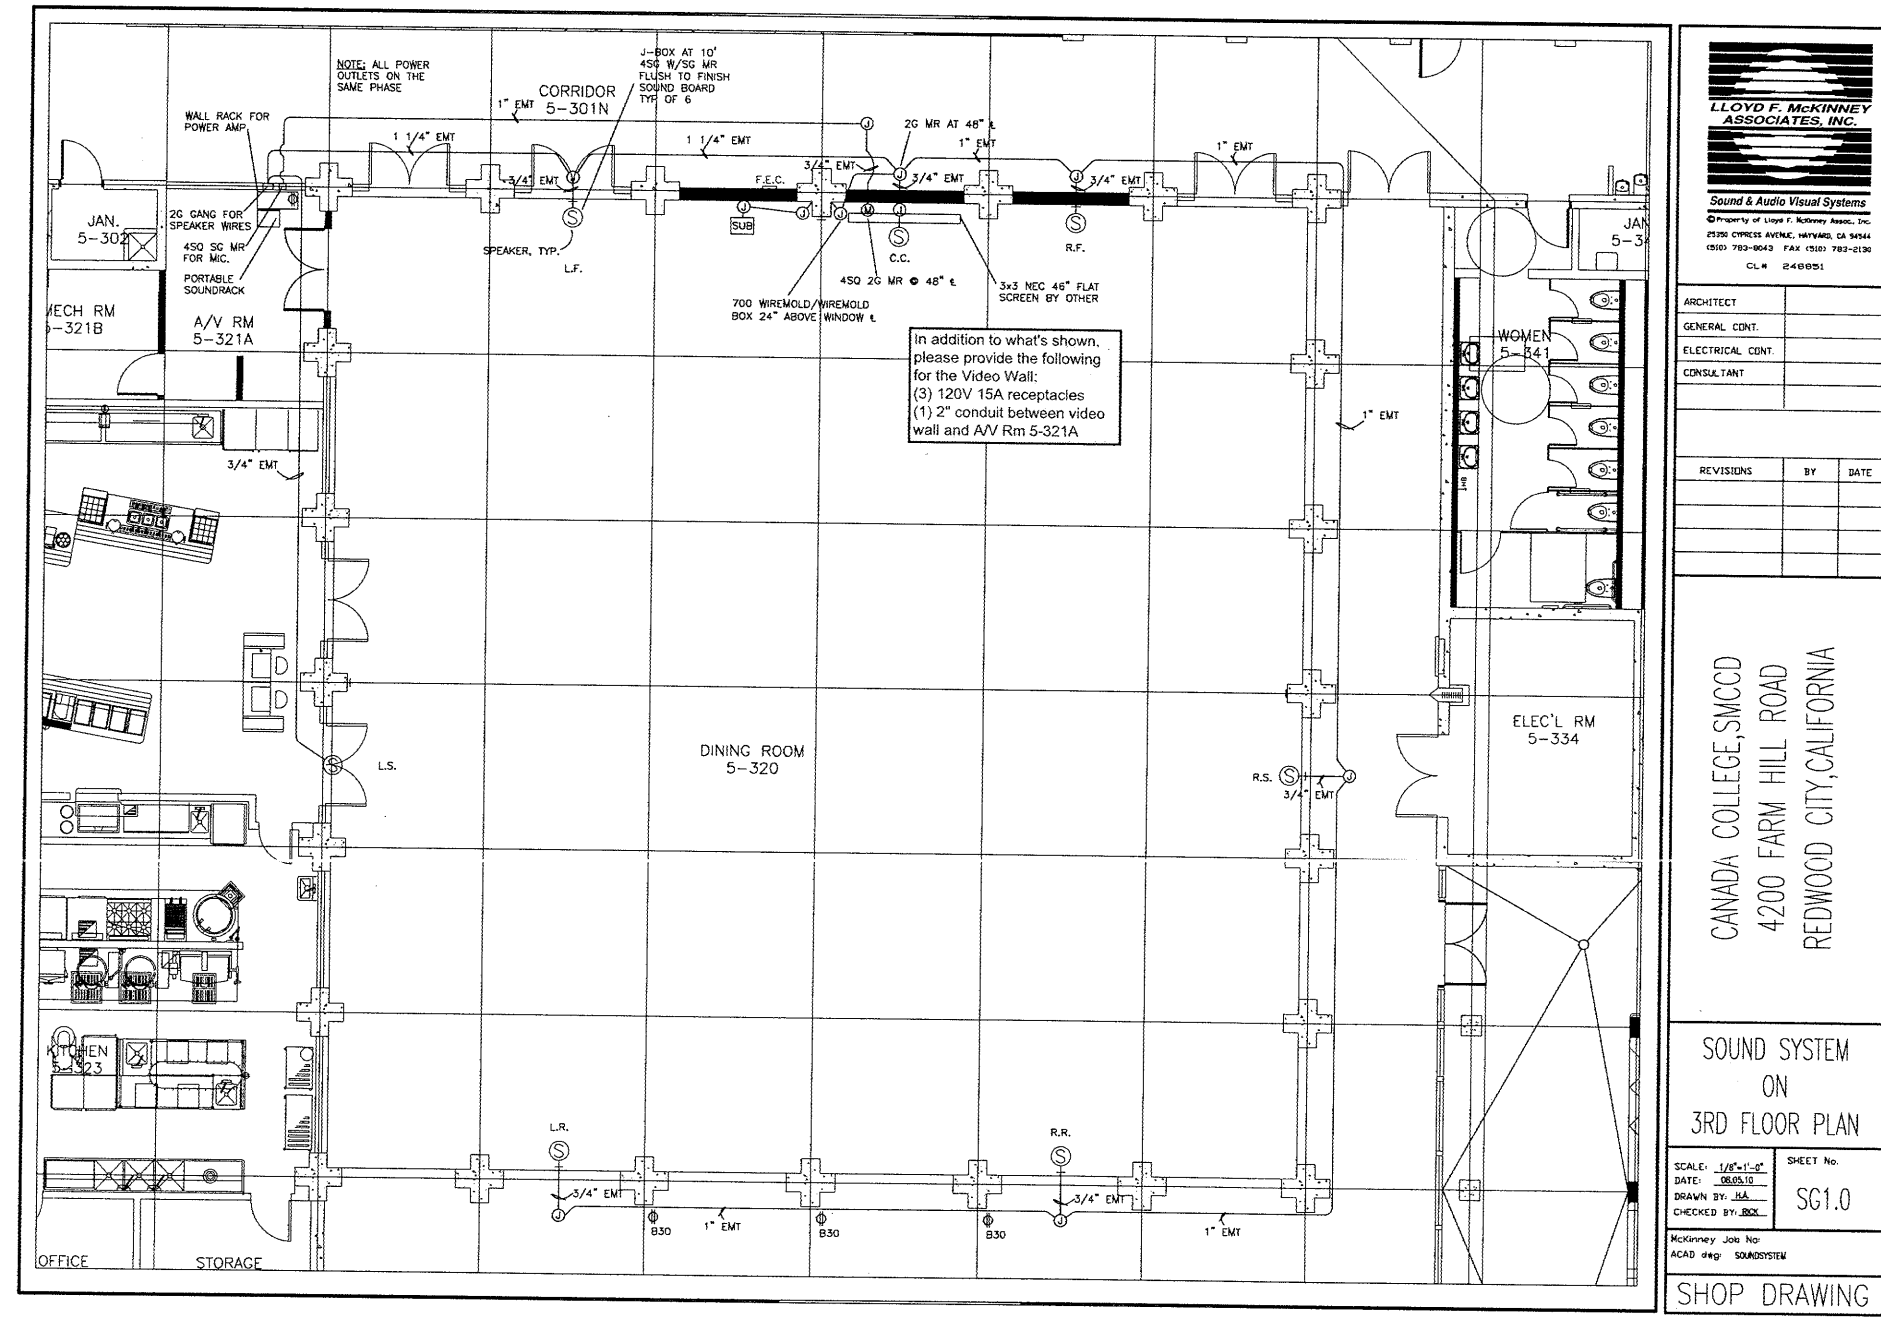


RFP-40

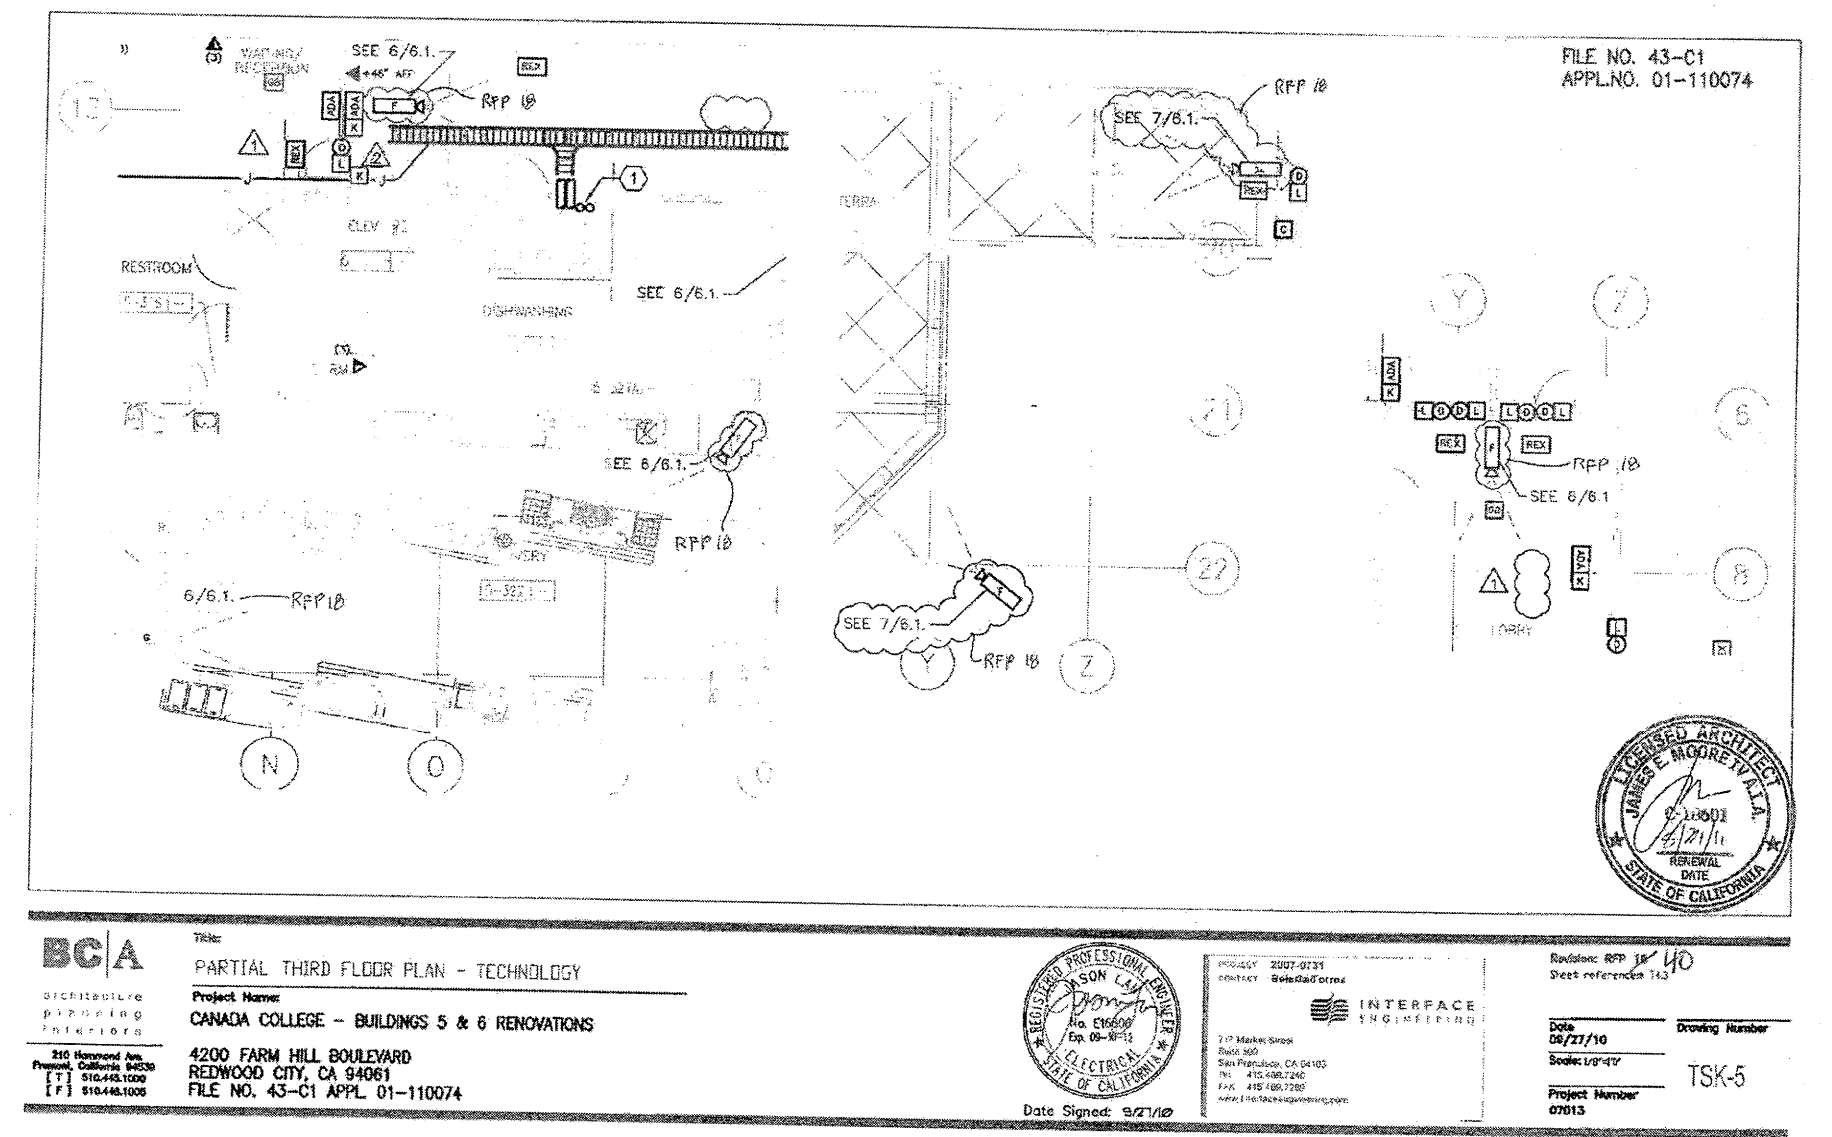

RFP-31

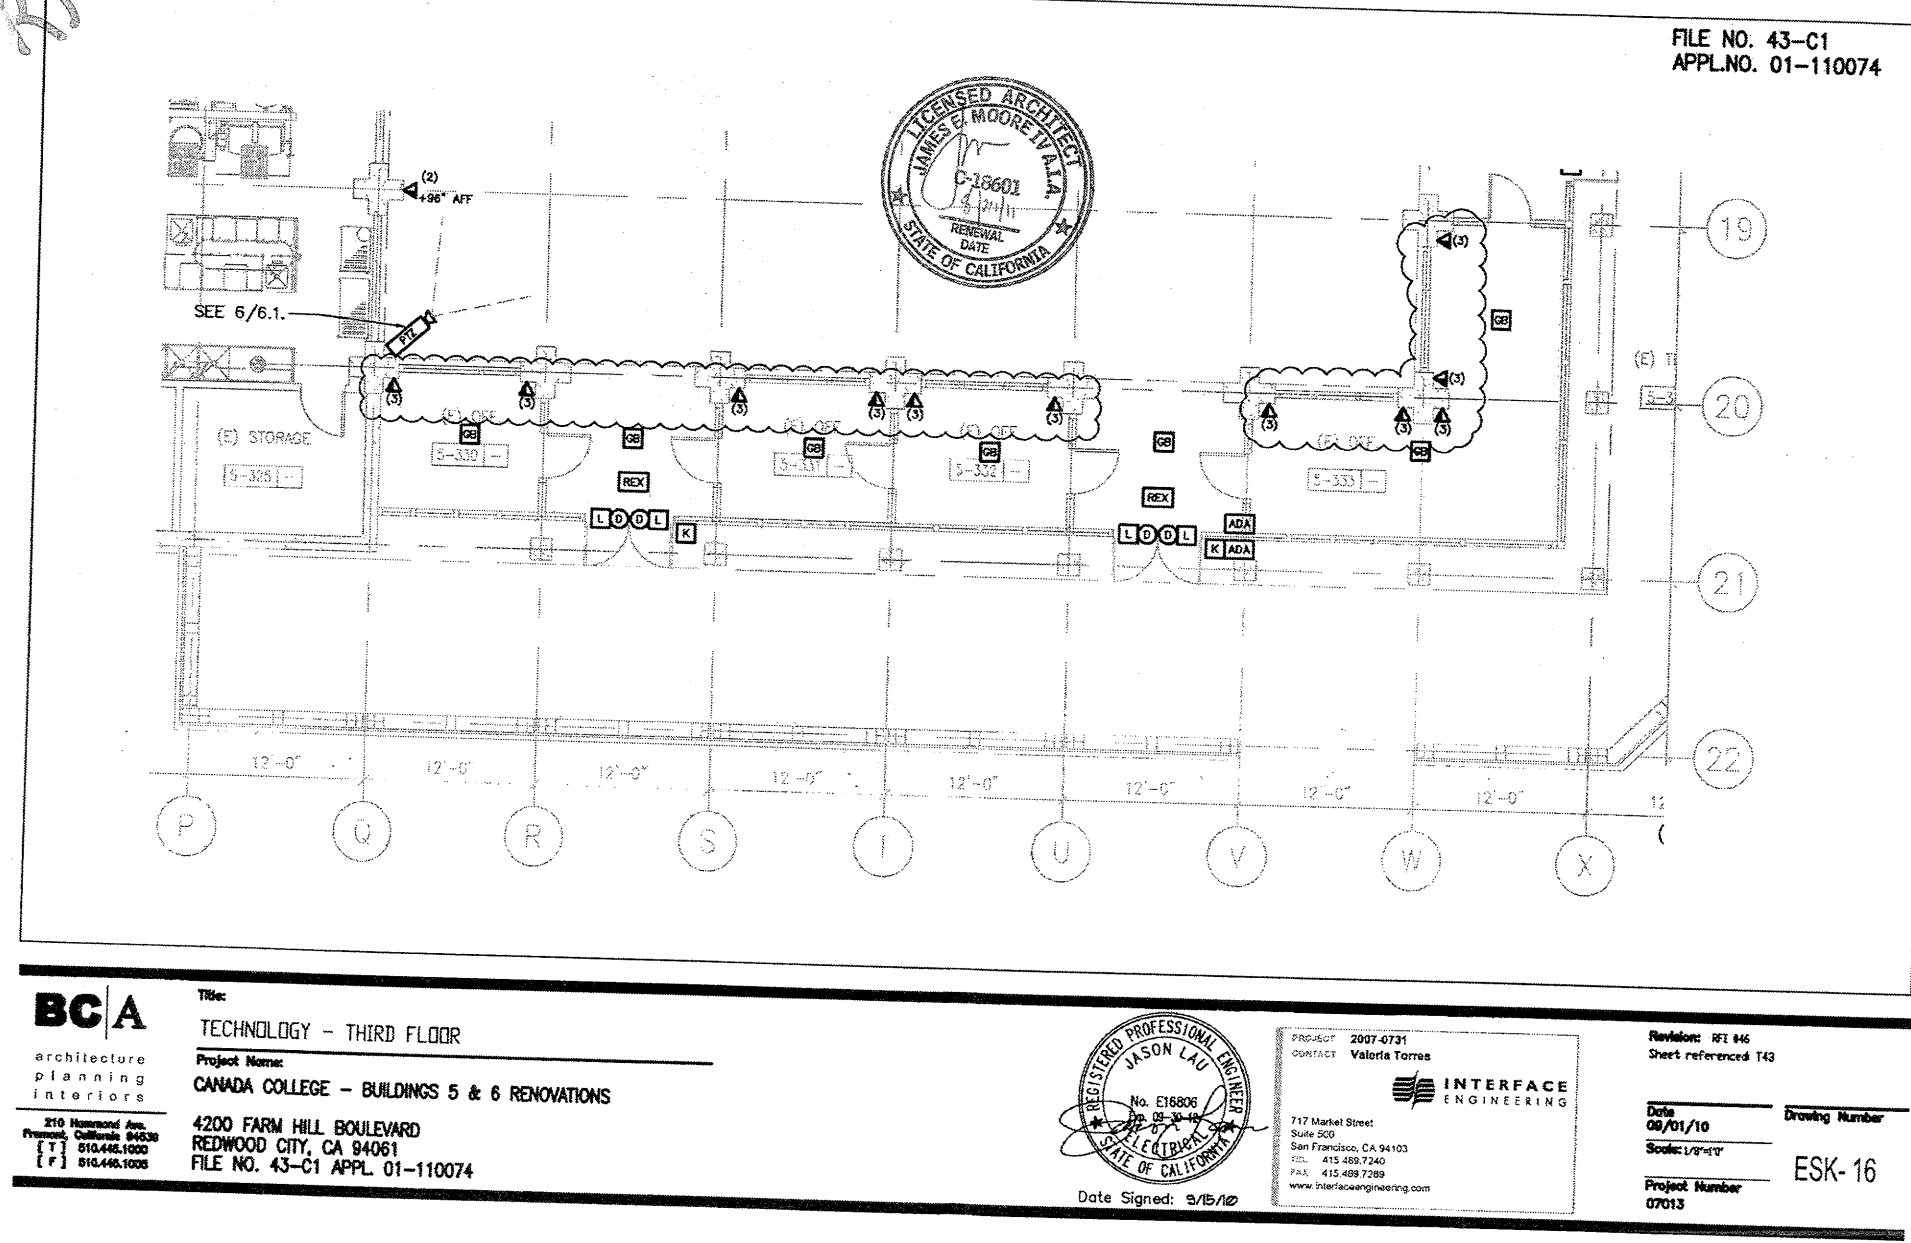

RFP-48

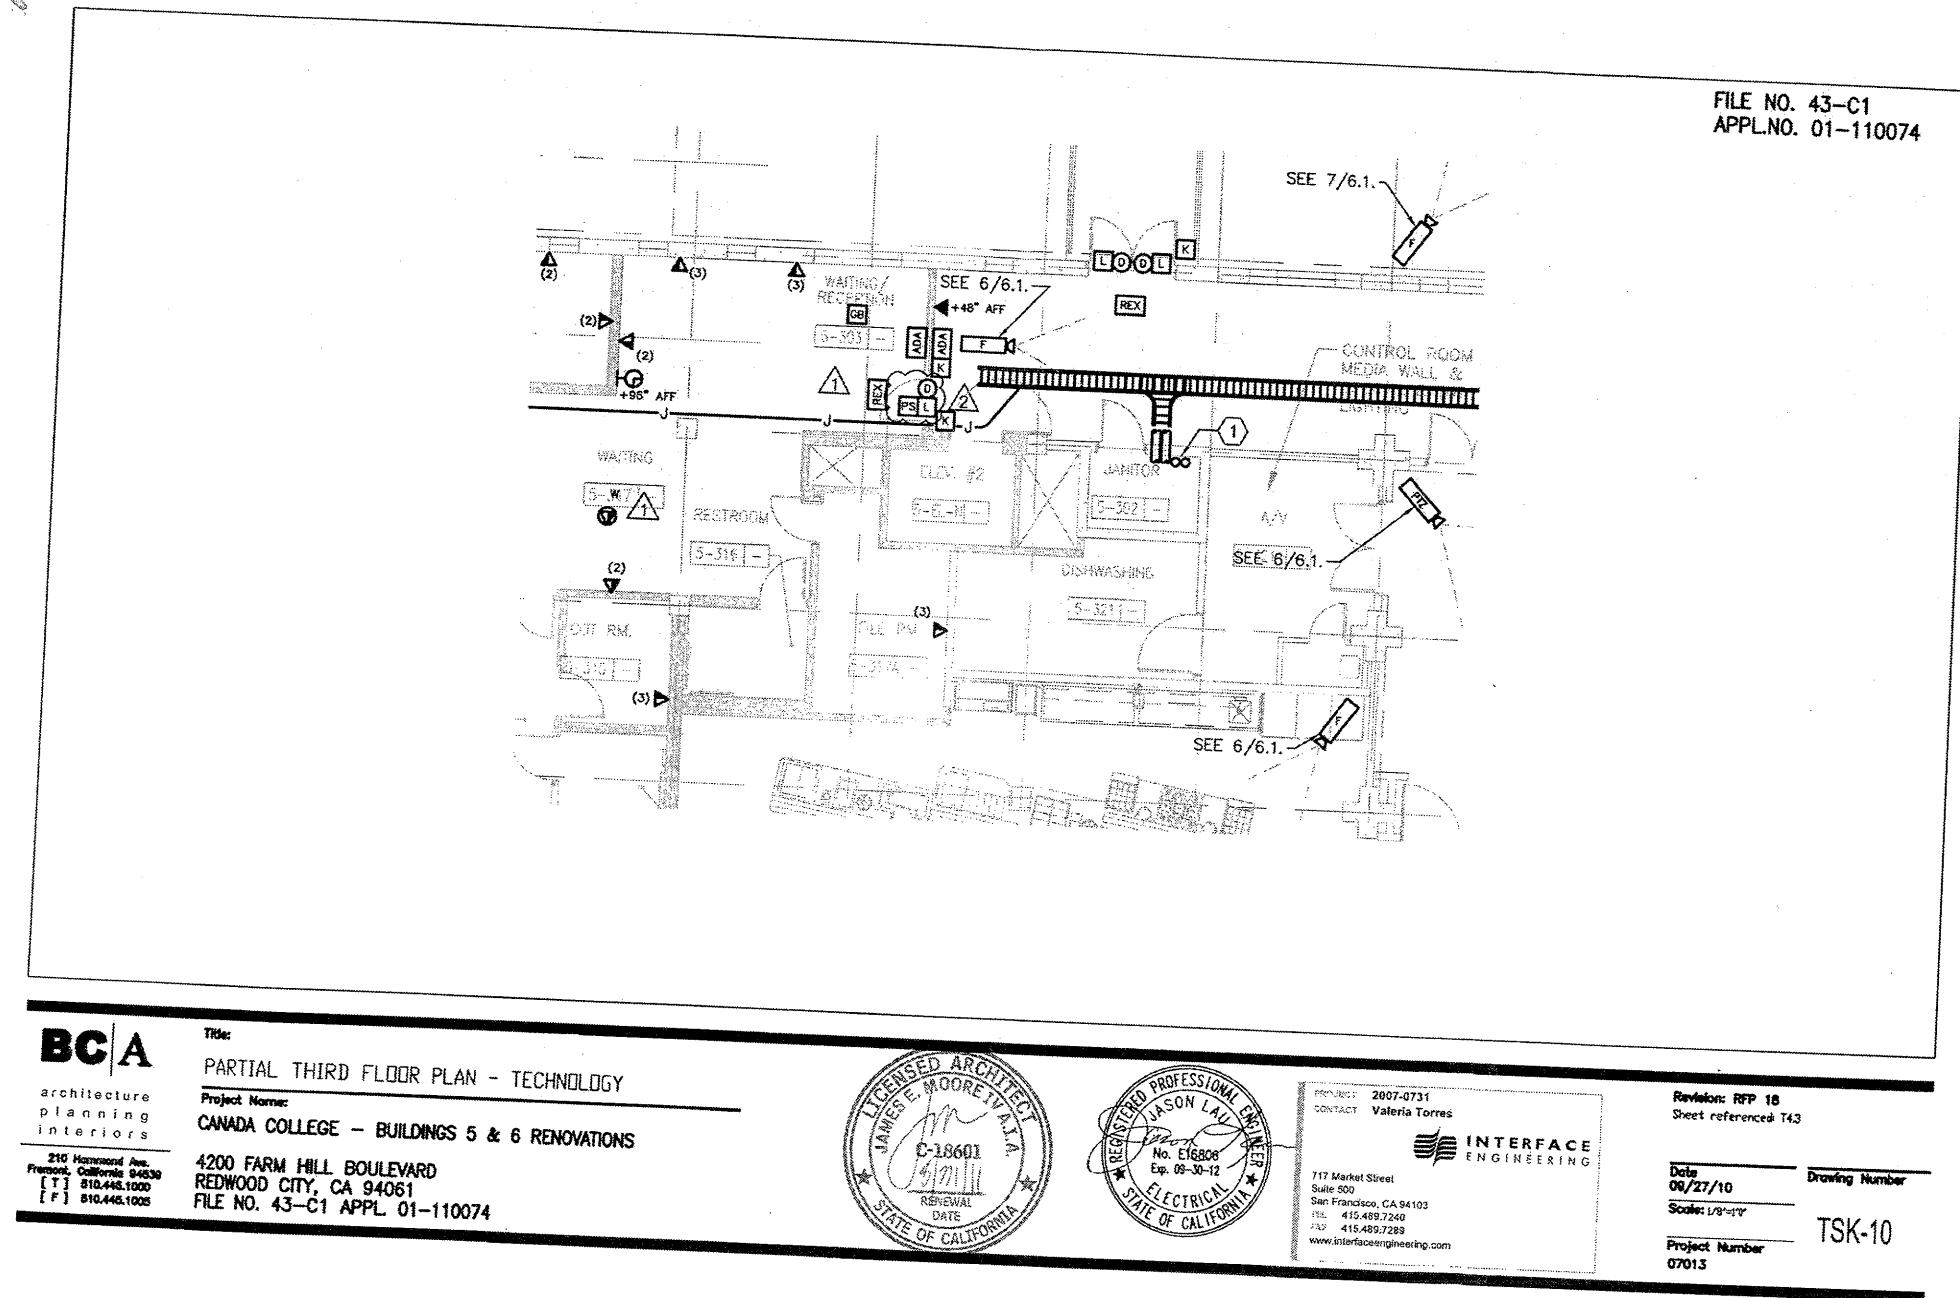

RFP-40

