
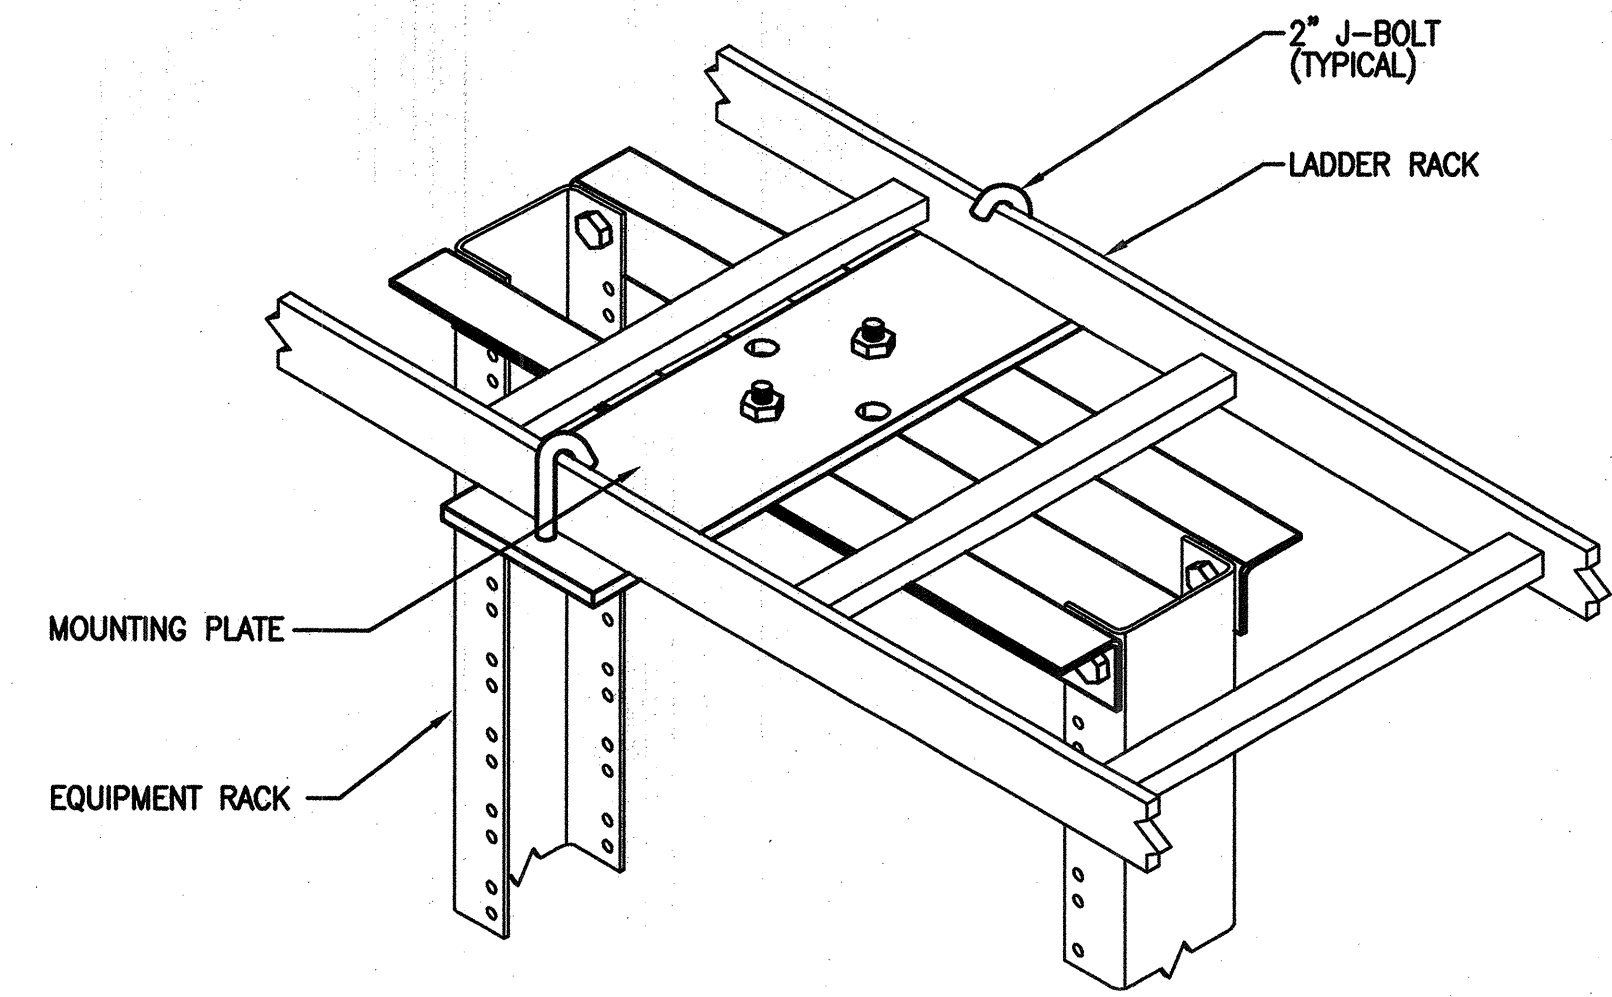
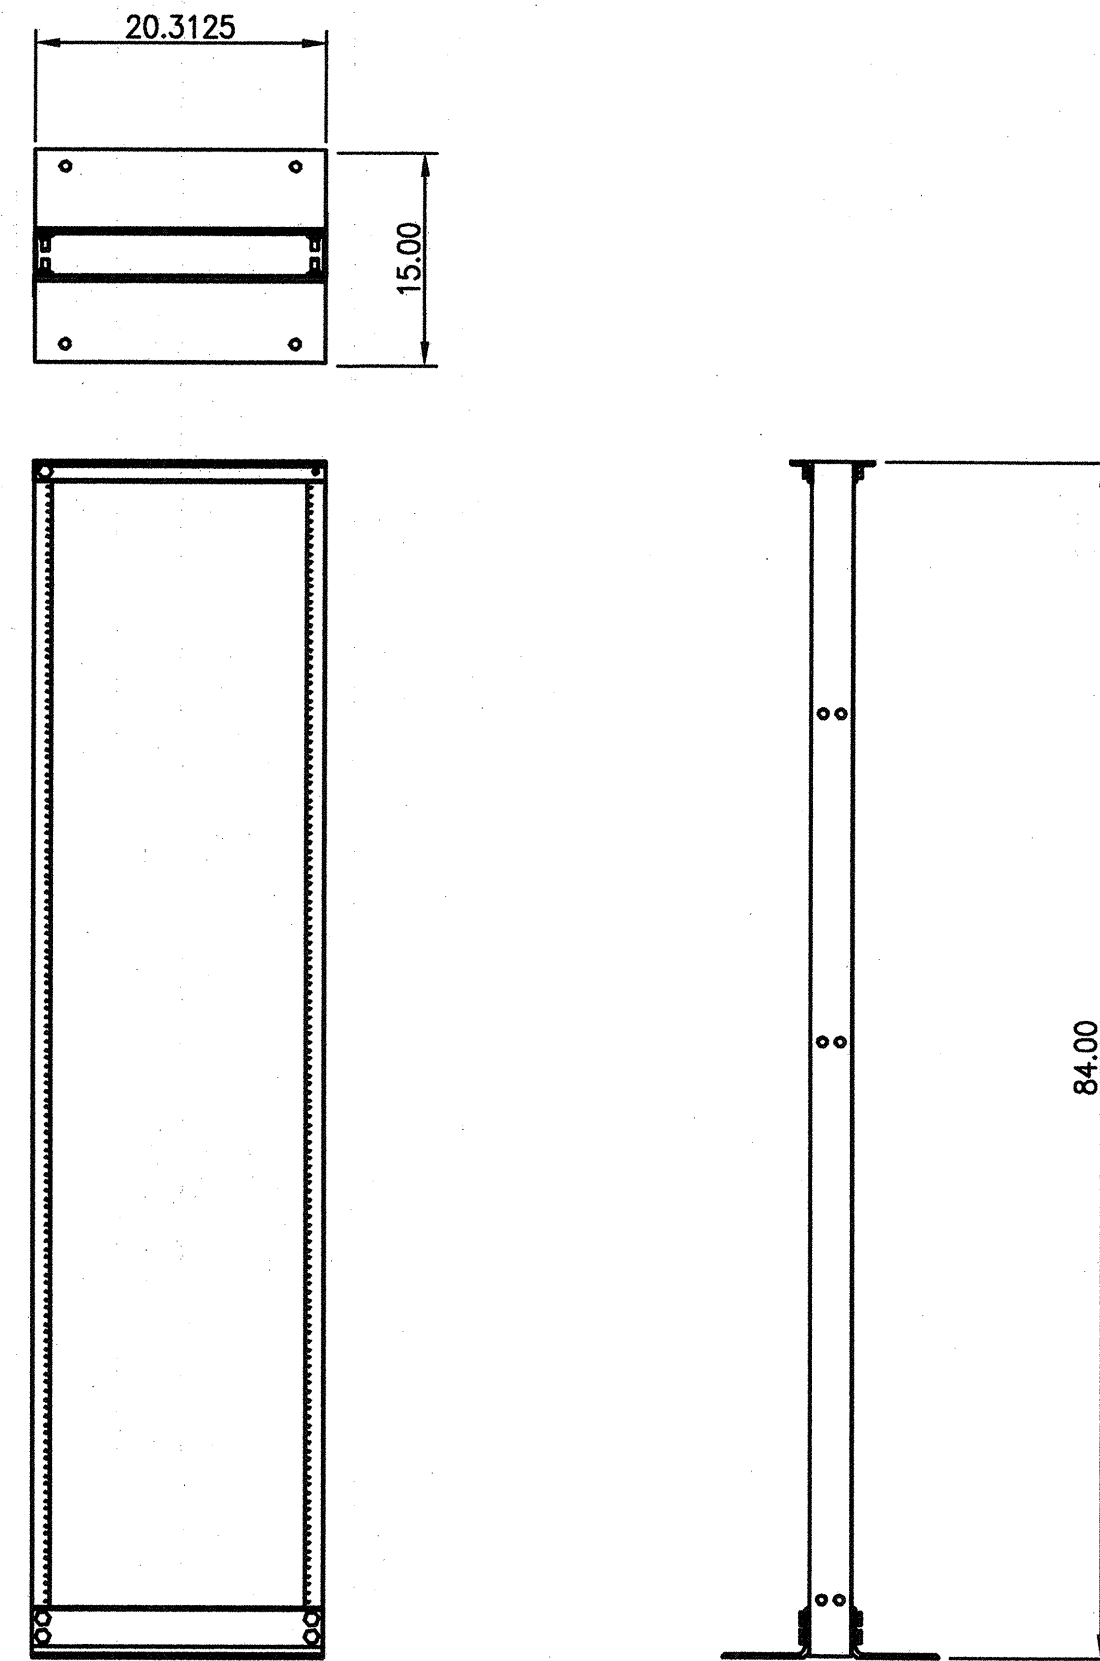


Copyright 2005 Steinberg Architects. All Rights Reserved. These Plans and/or Specifications are intended for the sole benefit of Skyline College and may not be used, reprinted, copied, or reproduced in any form without the express written consent of Steinberg Architects.

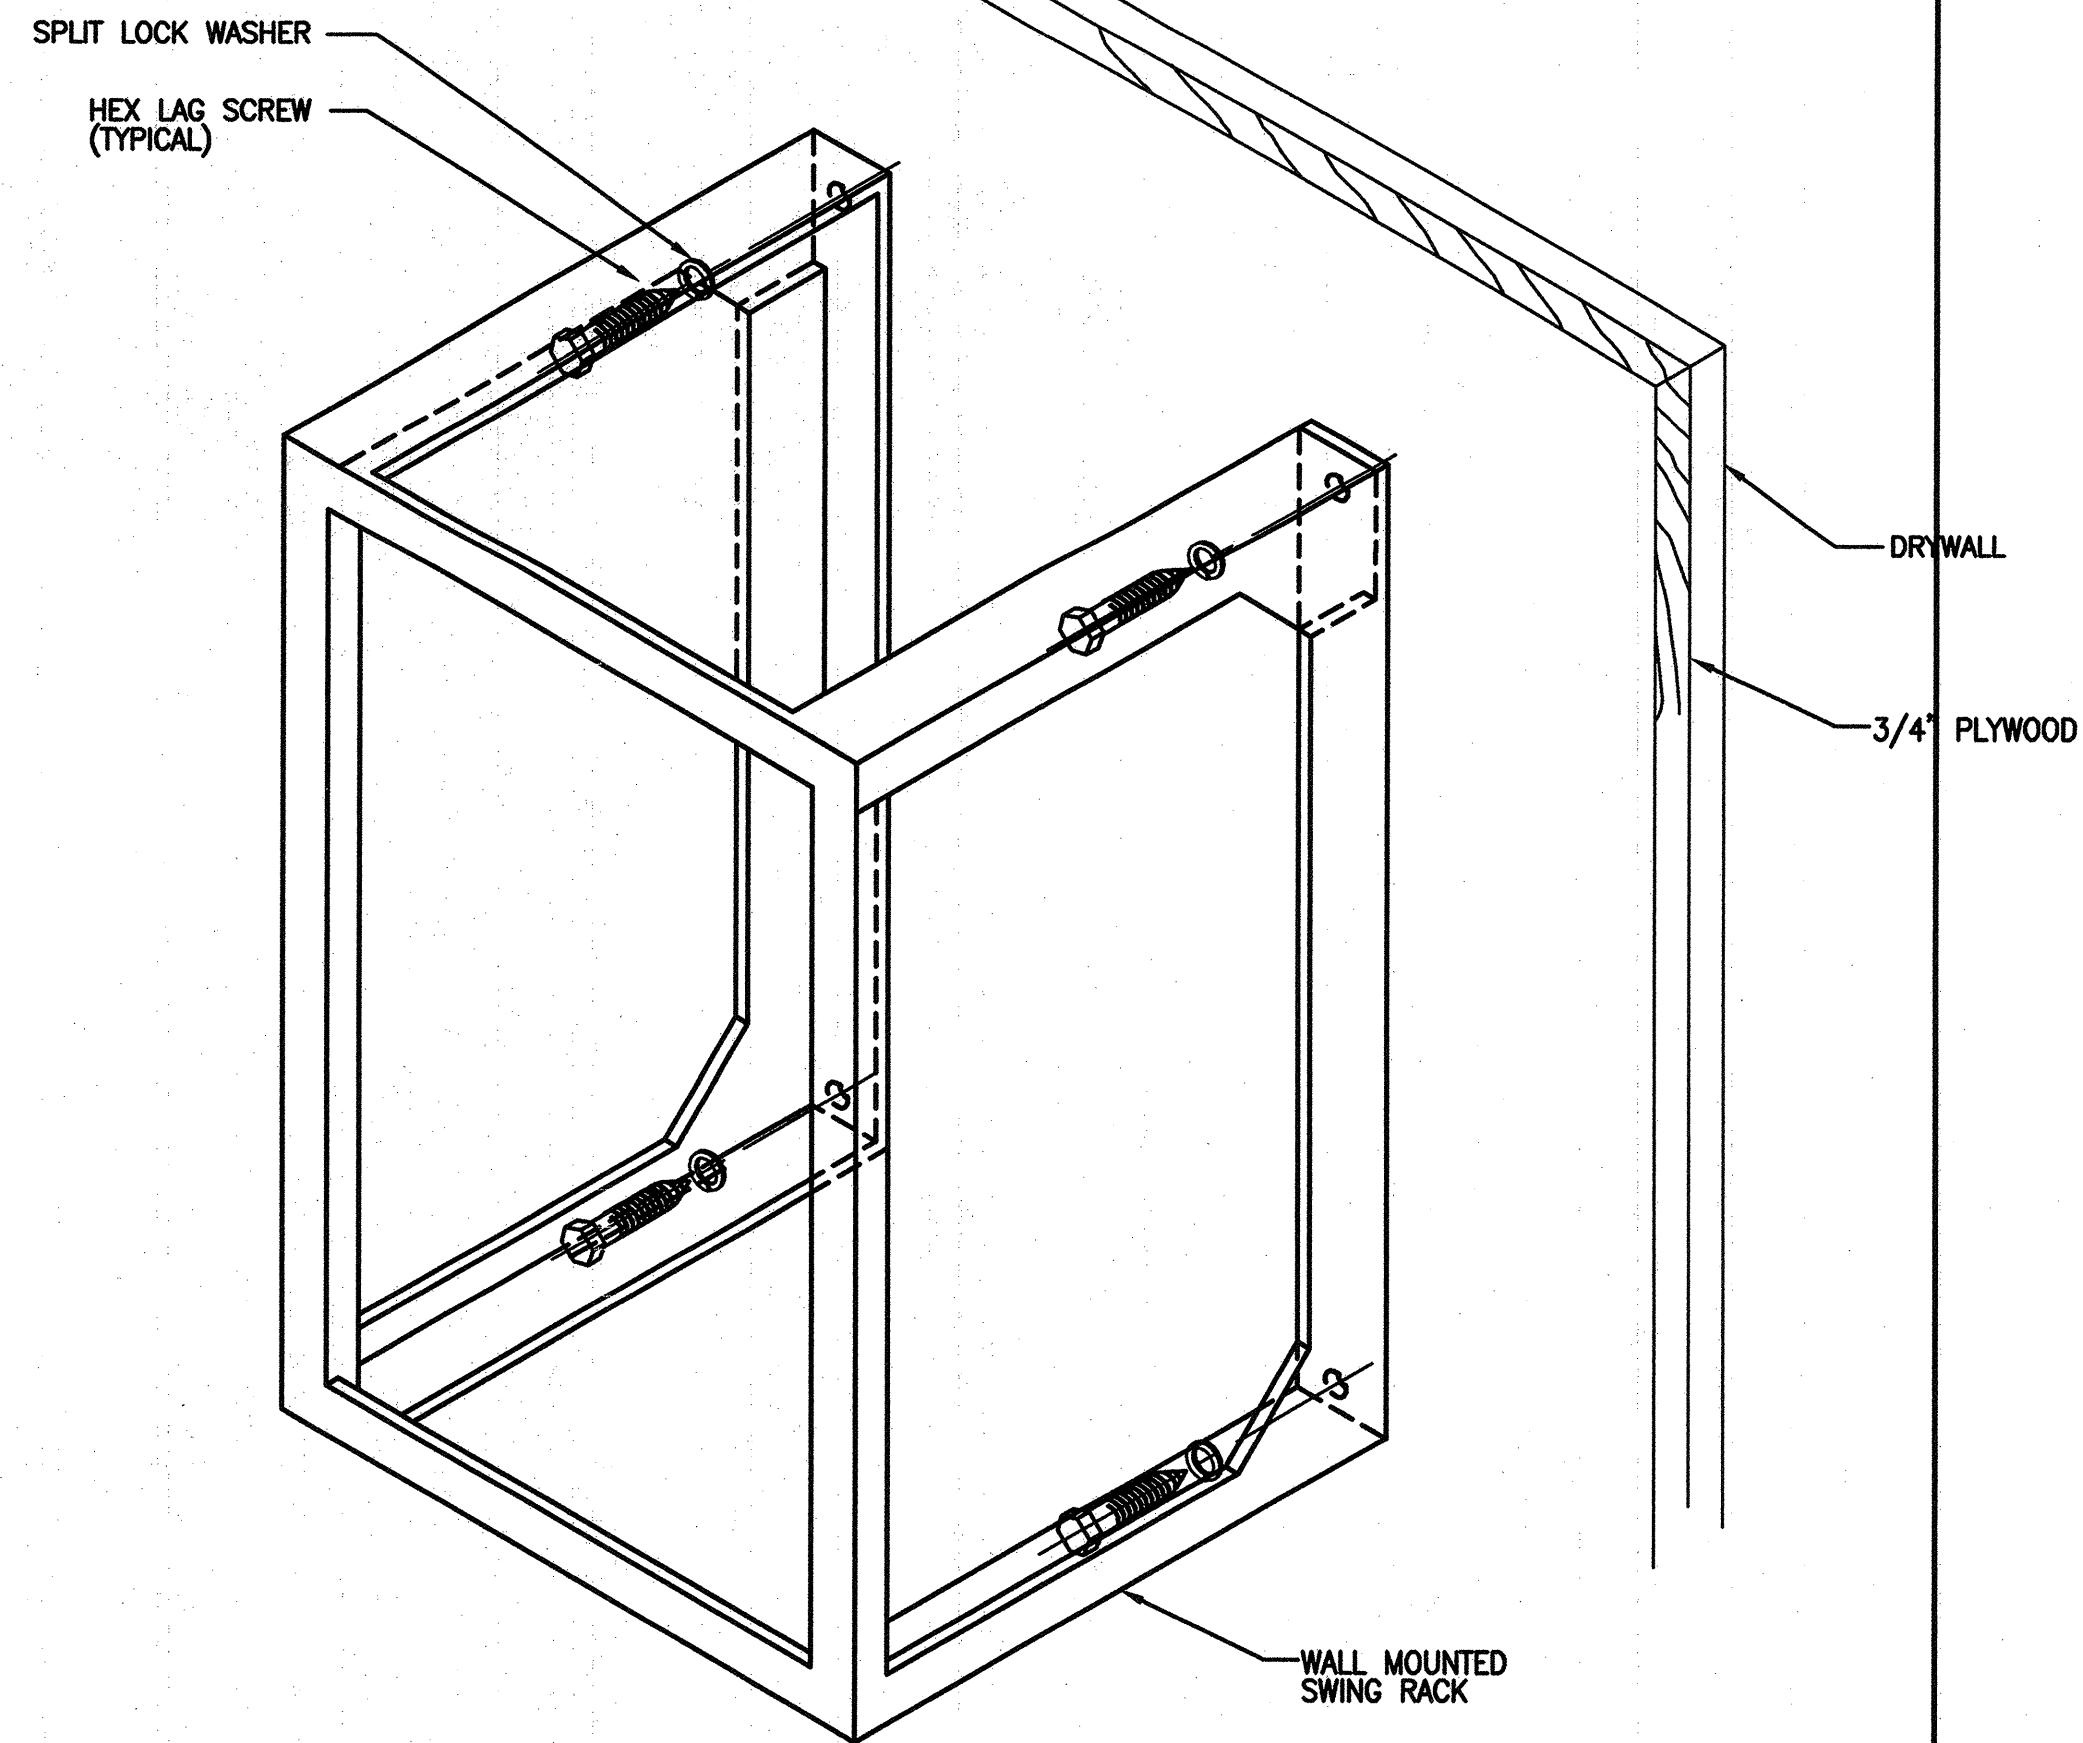

SWING RACK, WALL MOUNT INSTALLATION DETAIL
NOT TO SCALE




5

7' EQUIPMENT RACK W/RACK UNIT IDENTIFICATION
NOT TO SCALE

3

EQUIPMENT RACK TO LADDER RACK MOUNTING DETAIL
NOT TO SCALE

1

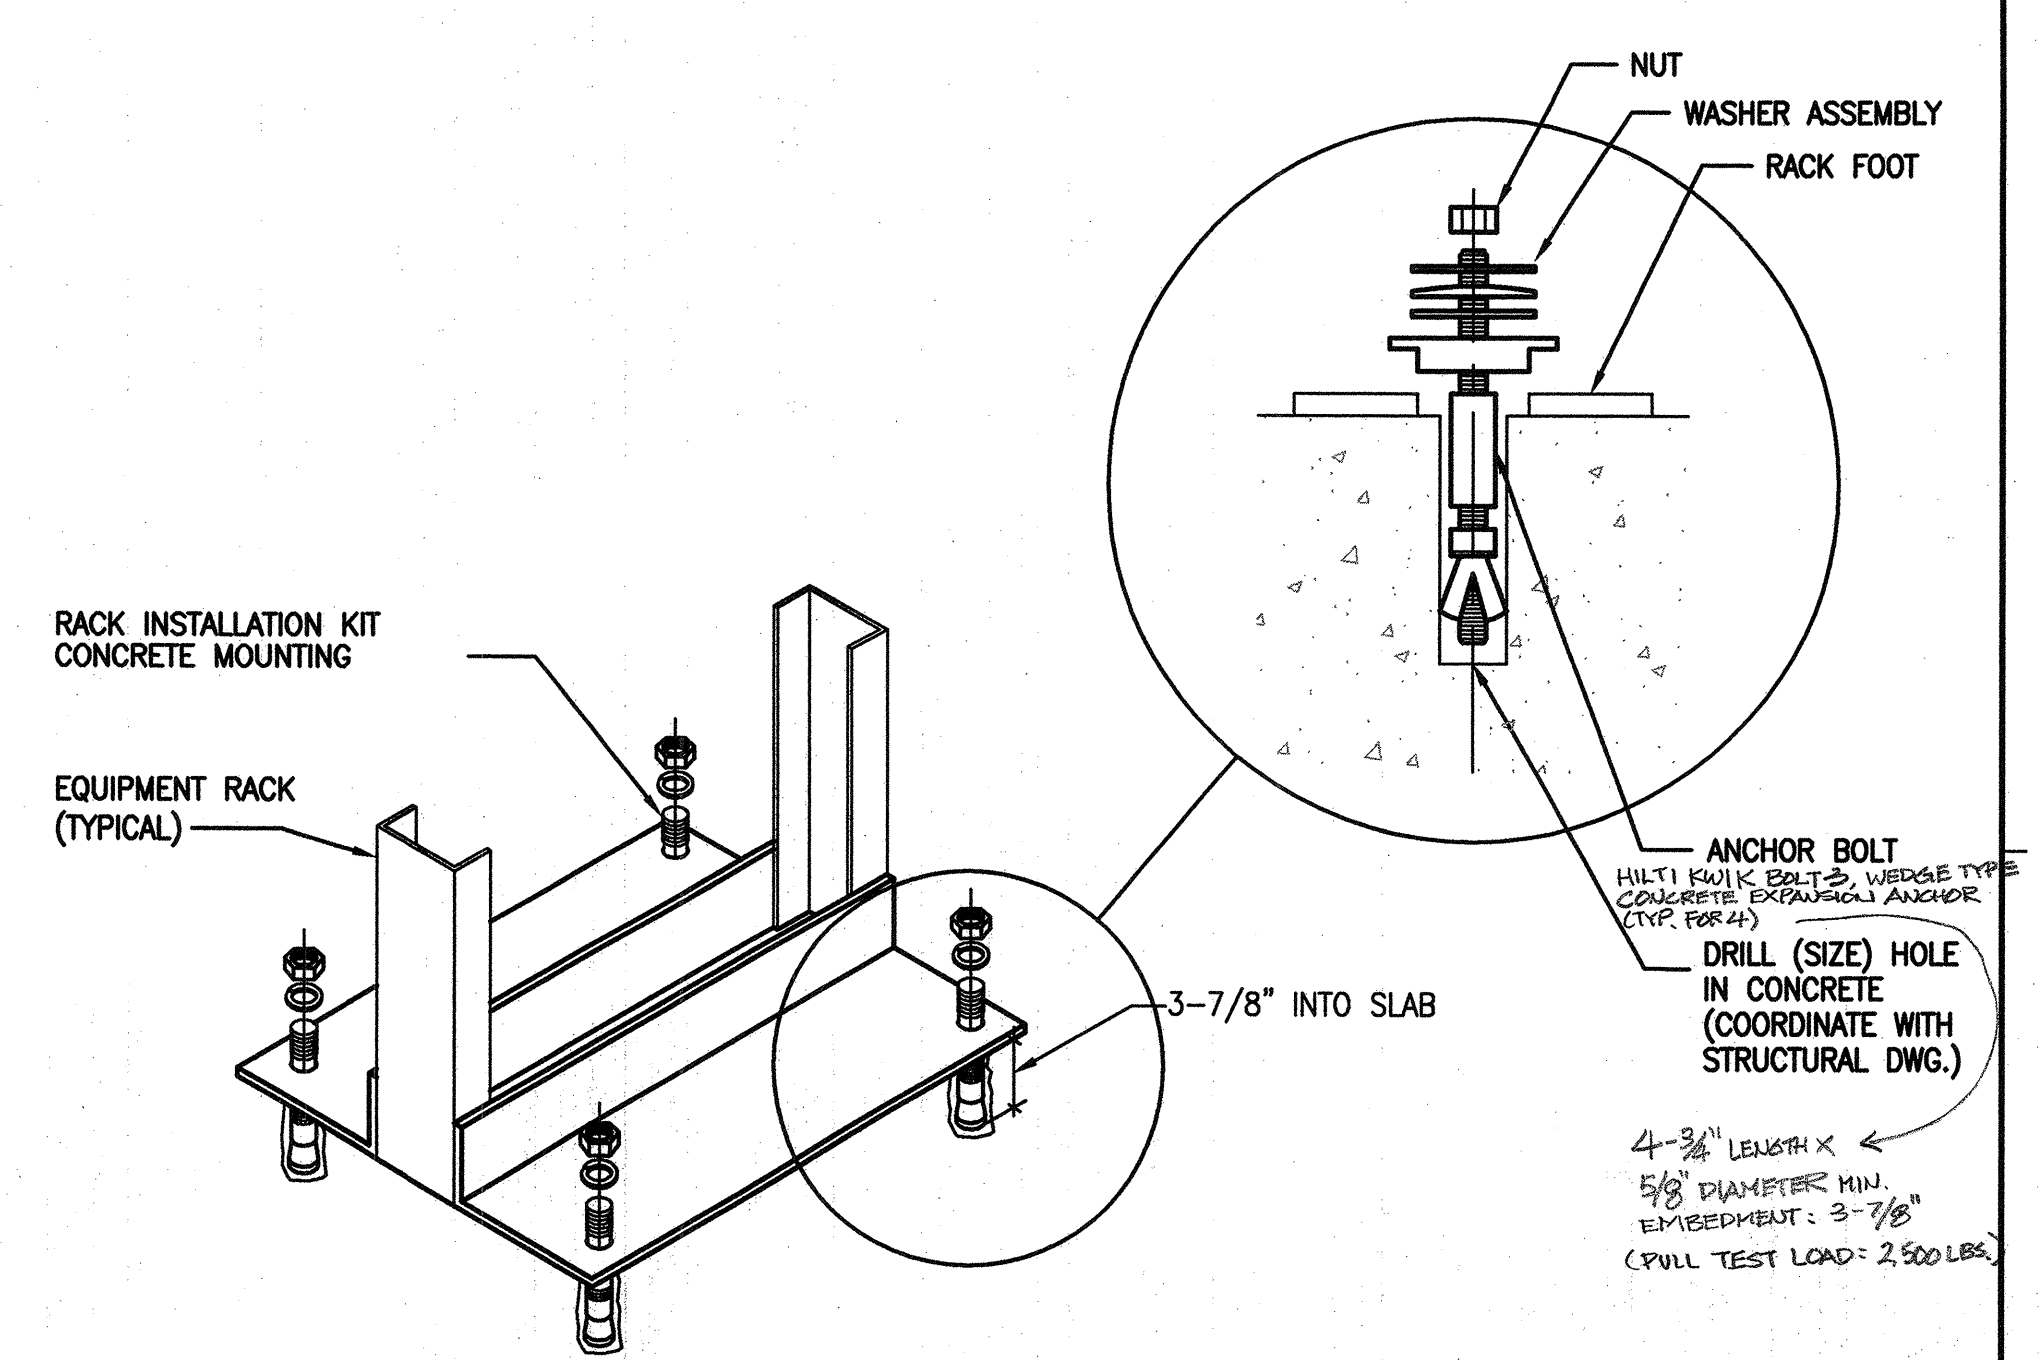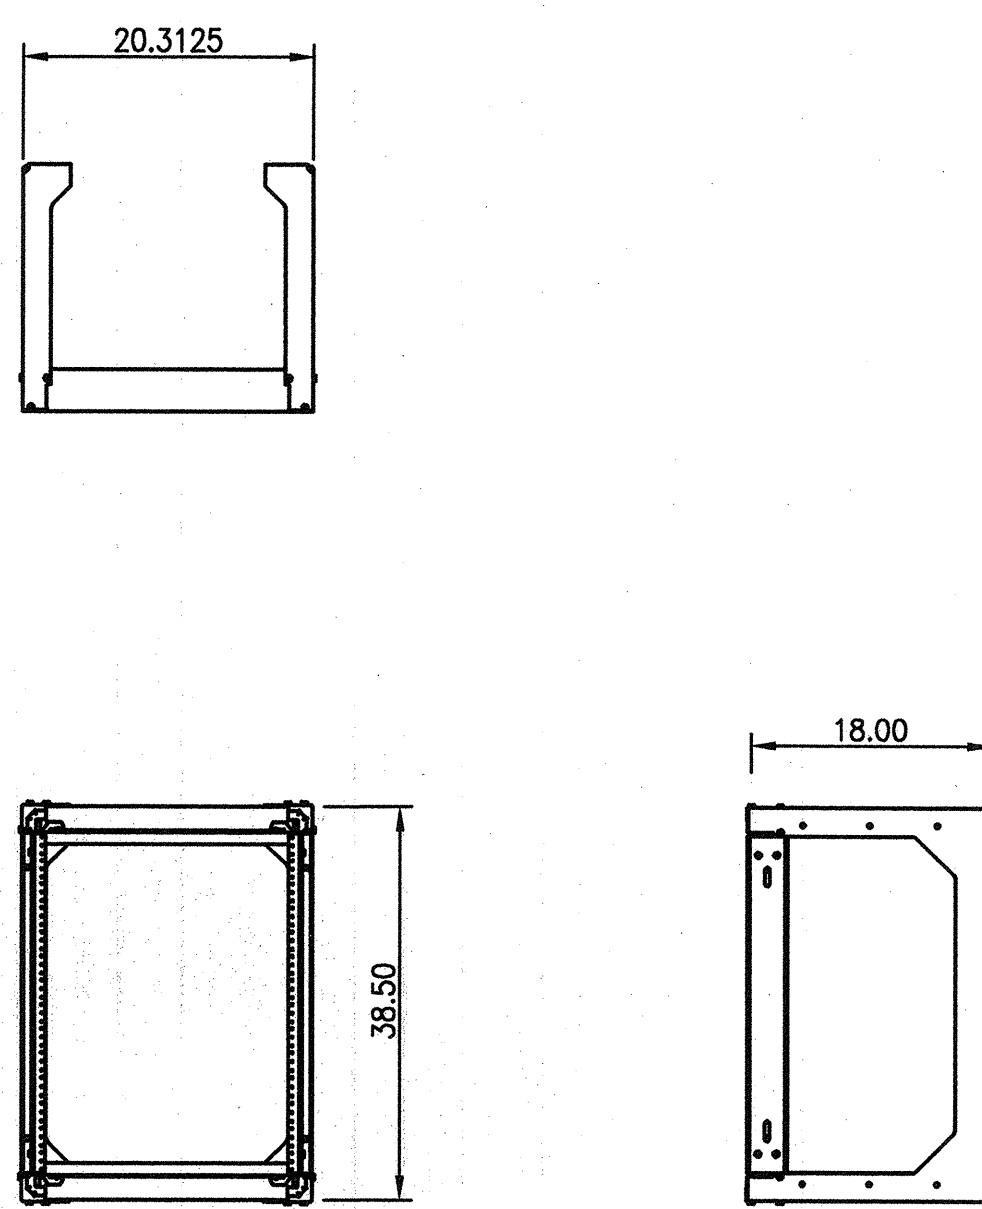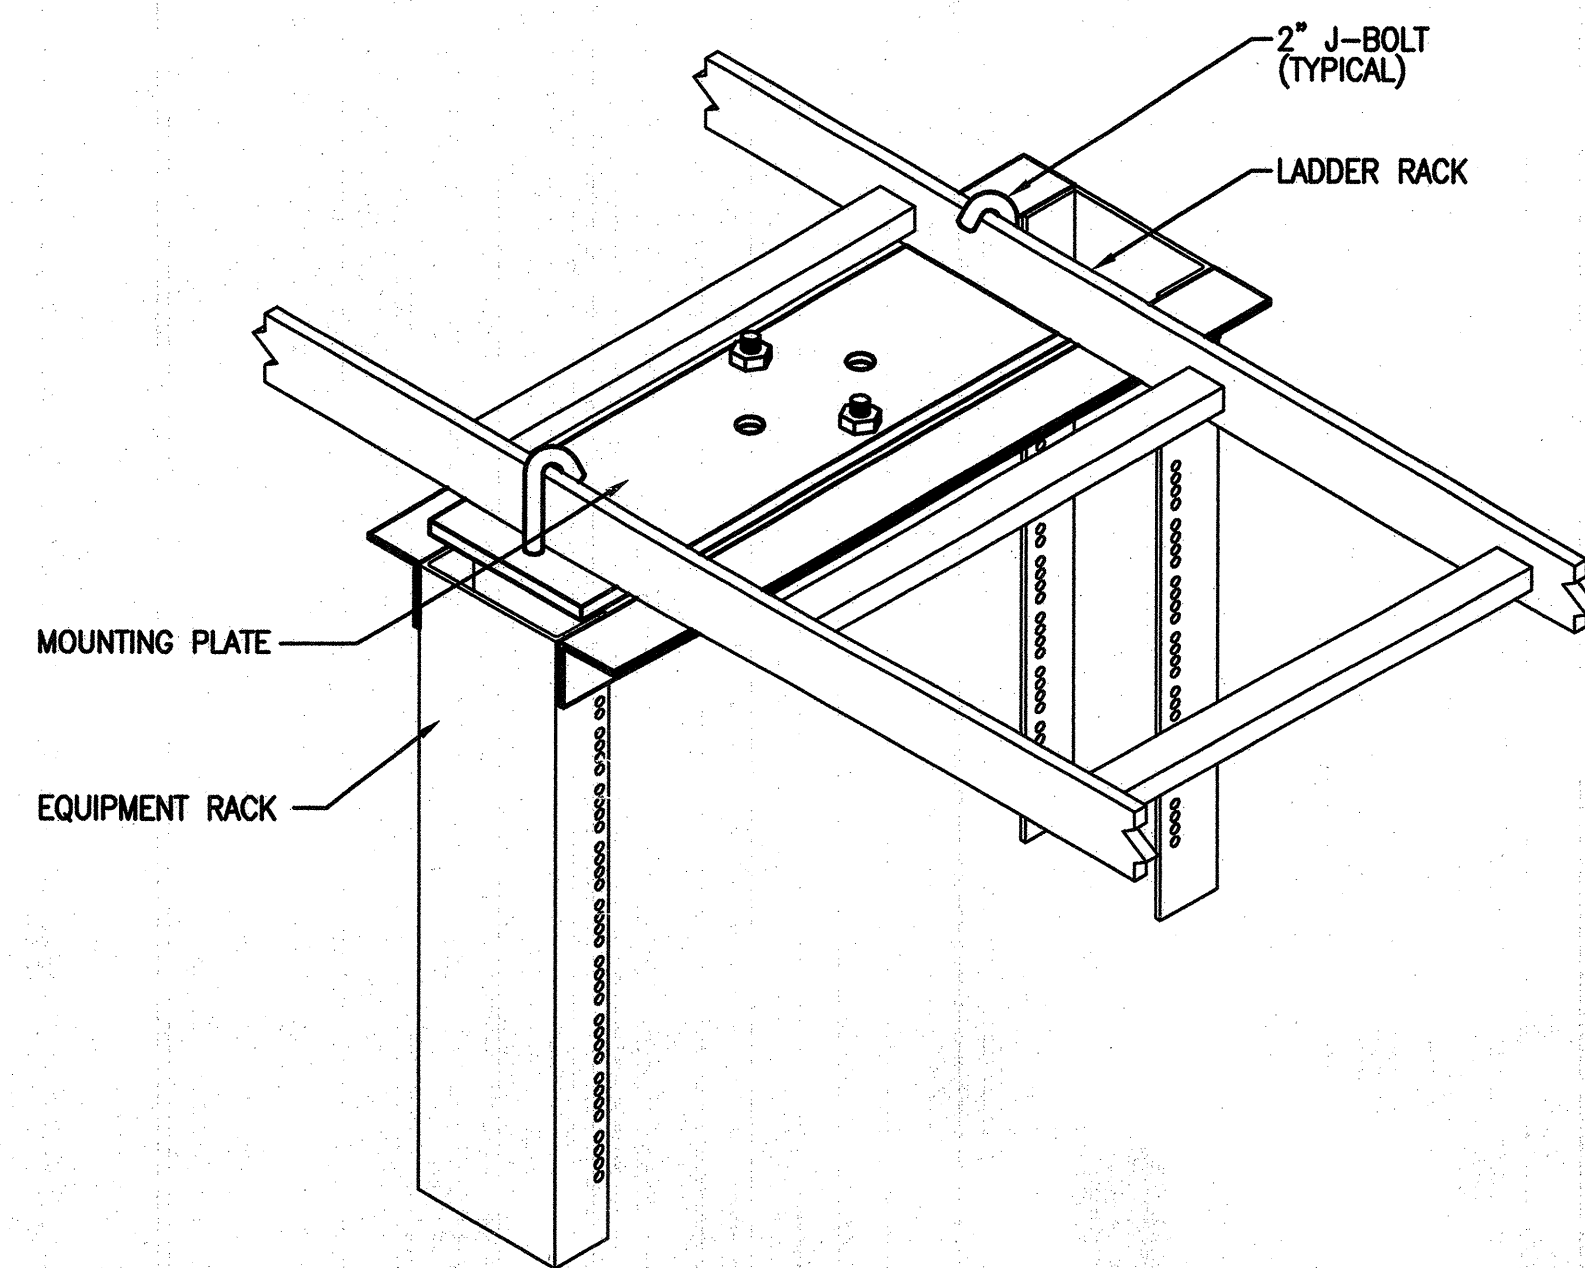

EQUIPMENT RACK TO LADDER RACK MOUNTING DETAIL
NOT TO SCALE

6

SWING GATE RACK DETAIL
NOT TO SCALE

4

EQUIPMENT RACK FLOOR MOUNT INSTALLATION W/FLOOR ANCHOR DETAIL
NOT TO SCALE

2

1: W:\Projects\06044 Skyline College TCOM Classroom Renovation\0401\031507.dwg
Printed: Monday, March 12, 2007 11:28am by: jw