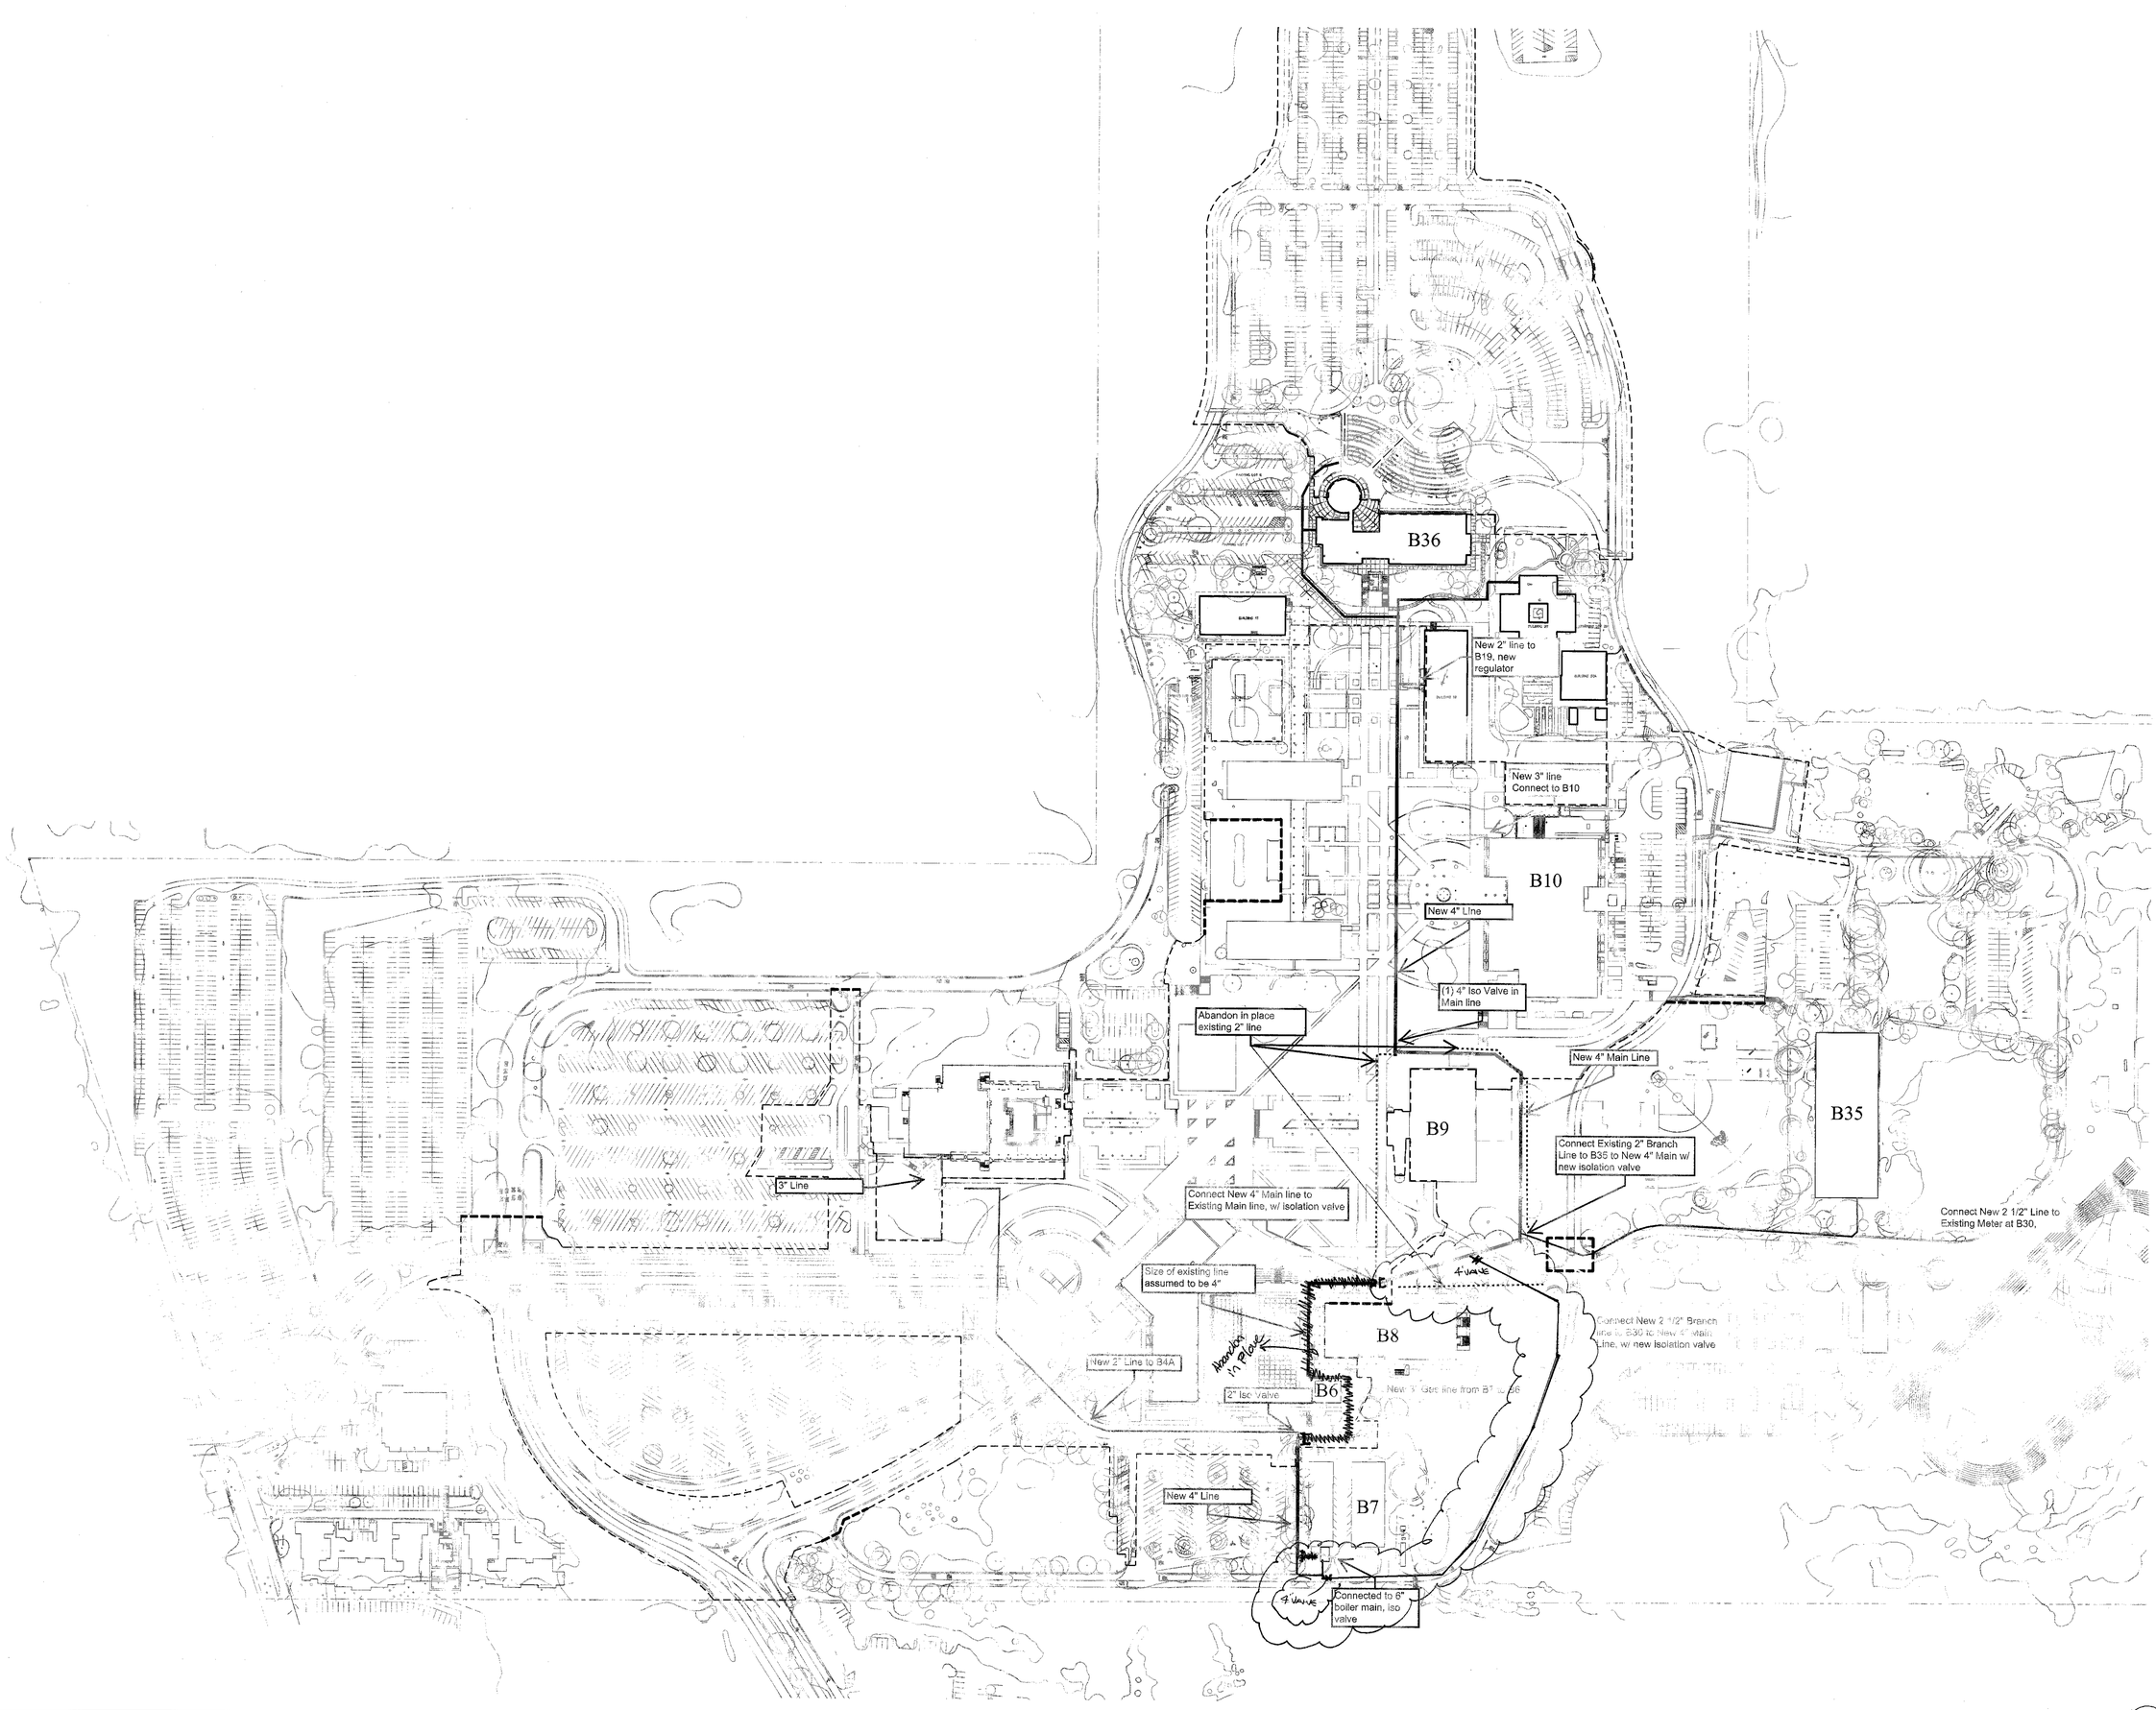

OVERALL SITE PLAN | 1" = 100' | 01

McCarthy Building Companies, I
343 Sansome Street, 14th Floor
San Francisco, California 94104
P 415 364-1339
F 415 397-5999

LICENSED ARCHITECT STEVEN C. KENDRICK No. C14099 REN 08-31-07 STATE OF CALIFORNIA

REGISTERED LANDSCAPE ARCHITECT KEVIN MICHAEL SULLIVAN Signature NO. 2188 RENEWAL 8-31-10 Date STATE OF CALIFORNIA

IDENTIFICATION STAMP
DIV. OF THE STATE ARCHITECT
OFFICE OF REGULATION SERVICE
APPL. # 01-110097
AC. ____ FLS ____ SS ____
DATE ____

FILE NUMBER:

This and all other project documents and all ideas, sketches and designs incorporated therein are instruments of service. All project documents are the the registered property of LPA, INC. (LPA) and cannot be lawfully used in whole or in part for any project or purpose except as described in the contractual agreement between McCarthy and the District. LPA hereby gives limited permission that any such project documents may be used by the District and others acting on the District's behalf but automatically loses all permission with respect to full indemnity and defend LPA and LPA's consultants to the maximum legal extent against all losses, demands, claims or liabilities arising directly or indirectly from project documents misuse. Project documents describe design intent of work and are not a representation of as-built or existing conditions. LPA and LPA's Consultants make no representations concerning accuracy of documents and are not responsible for any discrepancies between project documents and the existing conditions.

© Copyright 2008

College of San Mateo
Site Package
San Mateo, CA

Developed for
San Mateo County Community College District

Revision	Description	Date

Revision	Description	Date

Job. No.	27082.50
Date	12 NOVEMBER 2008
Drawn by	AG, DT
Checked by	LC
Scale	AS SHOWN

0 50 100 200

OVERALL SITE PLAN

A0.02